

10^{ac}
JAMES ALFRED WINDRED
1044-87^q

10^{ac}
F.W. HALES G.L.
661-87^c


10^{ac}
L.C. THOMPSON
4.

10^{ac}
EDWARD ALLEN MASTERS
986-87^c

10^{ac}
HARRY MASTERS.
C. L.



SALISBURY GOLDFIELD

PLAN OF TUNNEL FROM ACTUAL SURVEY MADE IN 1894.

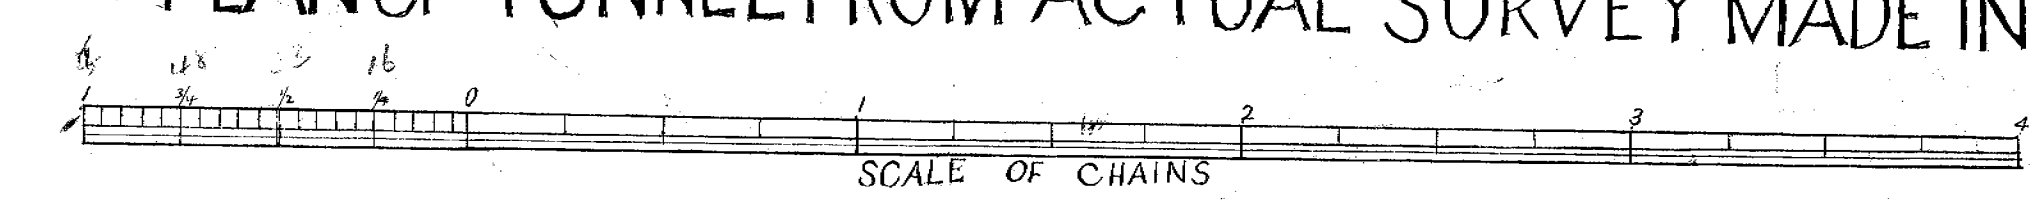

412M
5th April
1895
Notes by Trenchard
of pencils and additions
on Mr. J. A. Winchard's
original plan, added
April 9th & 1896
Ch. J. Trenchard
9/4/96

J. A. Brill
Eng. Dr.
Master sigs

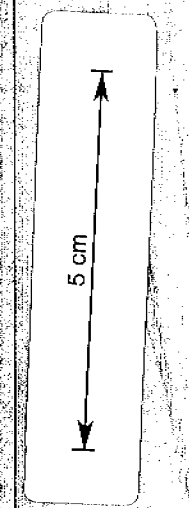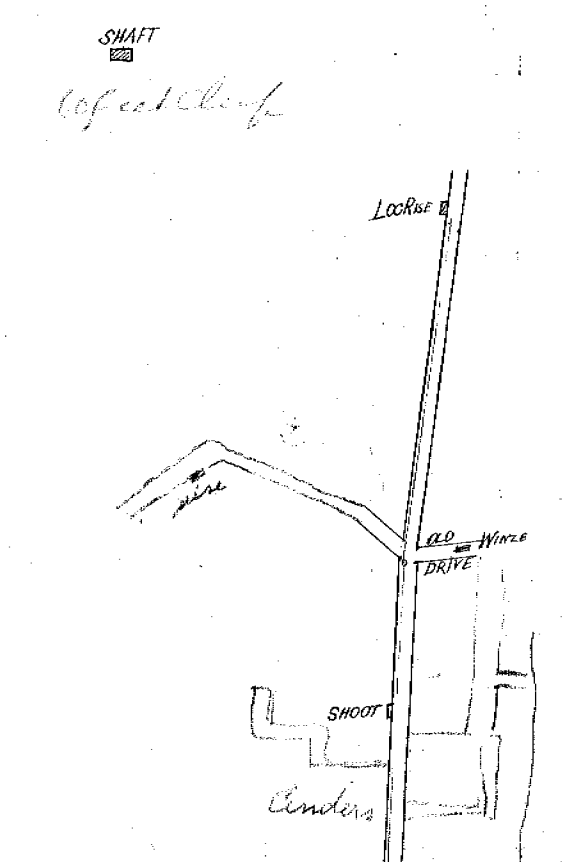

129-01

8