

93 G  
M.J. TURNER

10r. Or. OP

30°

660'



1662  
93 G  
M.J. TURNER  
9A . 2r . 27r

1061  
93 G  
M.J. TURNER

985  
87 G  
E.A. MASTERS

— TRACING —  
— OF —  
— DUCHESS OF YORK COLDMINE —  
— PARISH OF WELLS —  
— COUNTY OF DEVON —  
— SCALE 25 FT TO 1 INCH —

H. J. Benson  
Author of Mining  
Surveyor  
1st June 1902  
Theophilus Survey

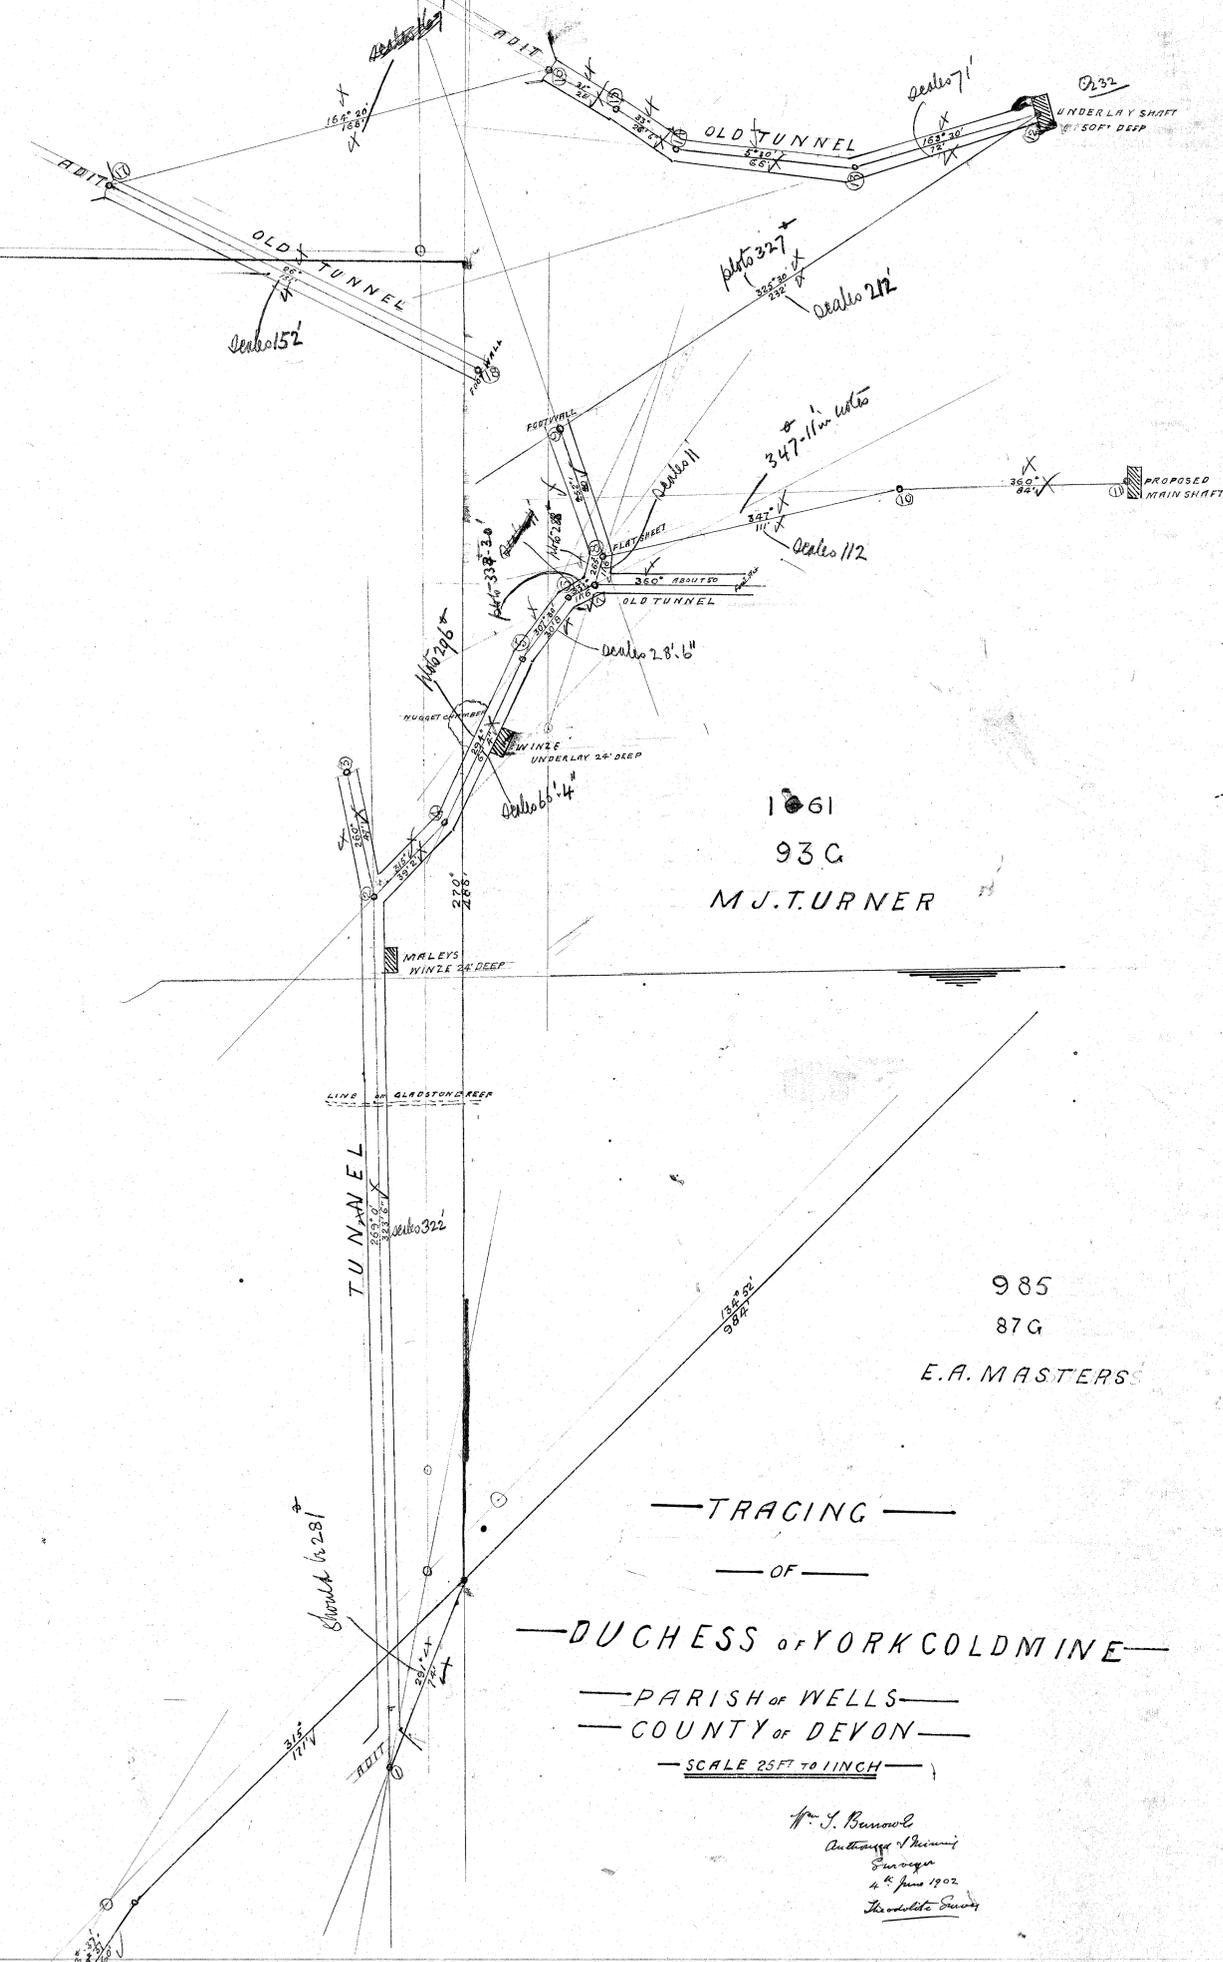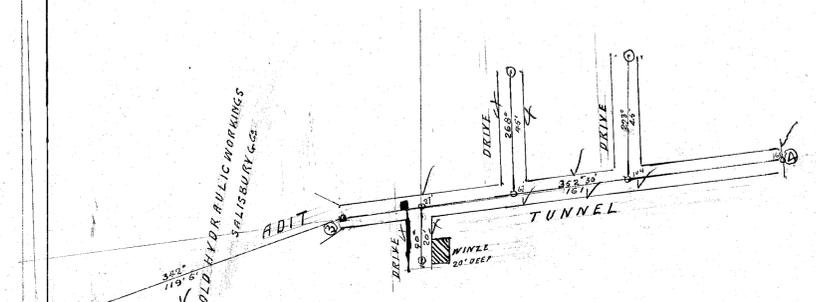

150-61

50'

150-61

176