

1803

1044  
870


1662  
93 G  
M.J. TURNER  
9A, 2A, 27P

1661  
93 G  
M.J. TURNER

985  
87G  
E.A. MASTERS



—TRACING OF PLAN—  
—DUCHESS OF YORK GOLD MINE—  
—PARISH OF WELLS—  
—COUNTY OF DEVON—  
—SCALE 40" TO 1 INCH—

W. J. Burrows  
Authorised Mining  
Surveyor  
4th June 1902  
Theodolite used

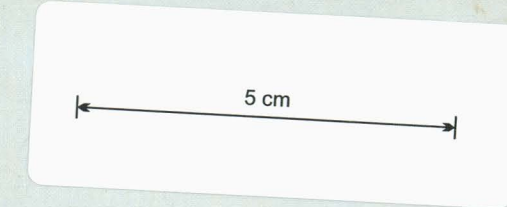

1044  
870

1663  
93 G  
M.J. TURNER  
10A, 2A, 27P

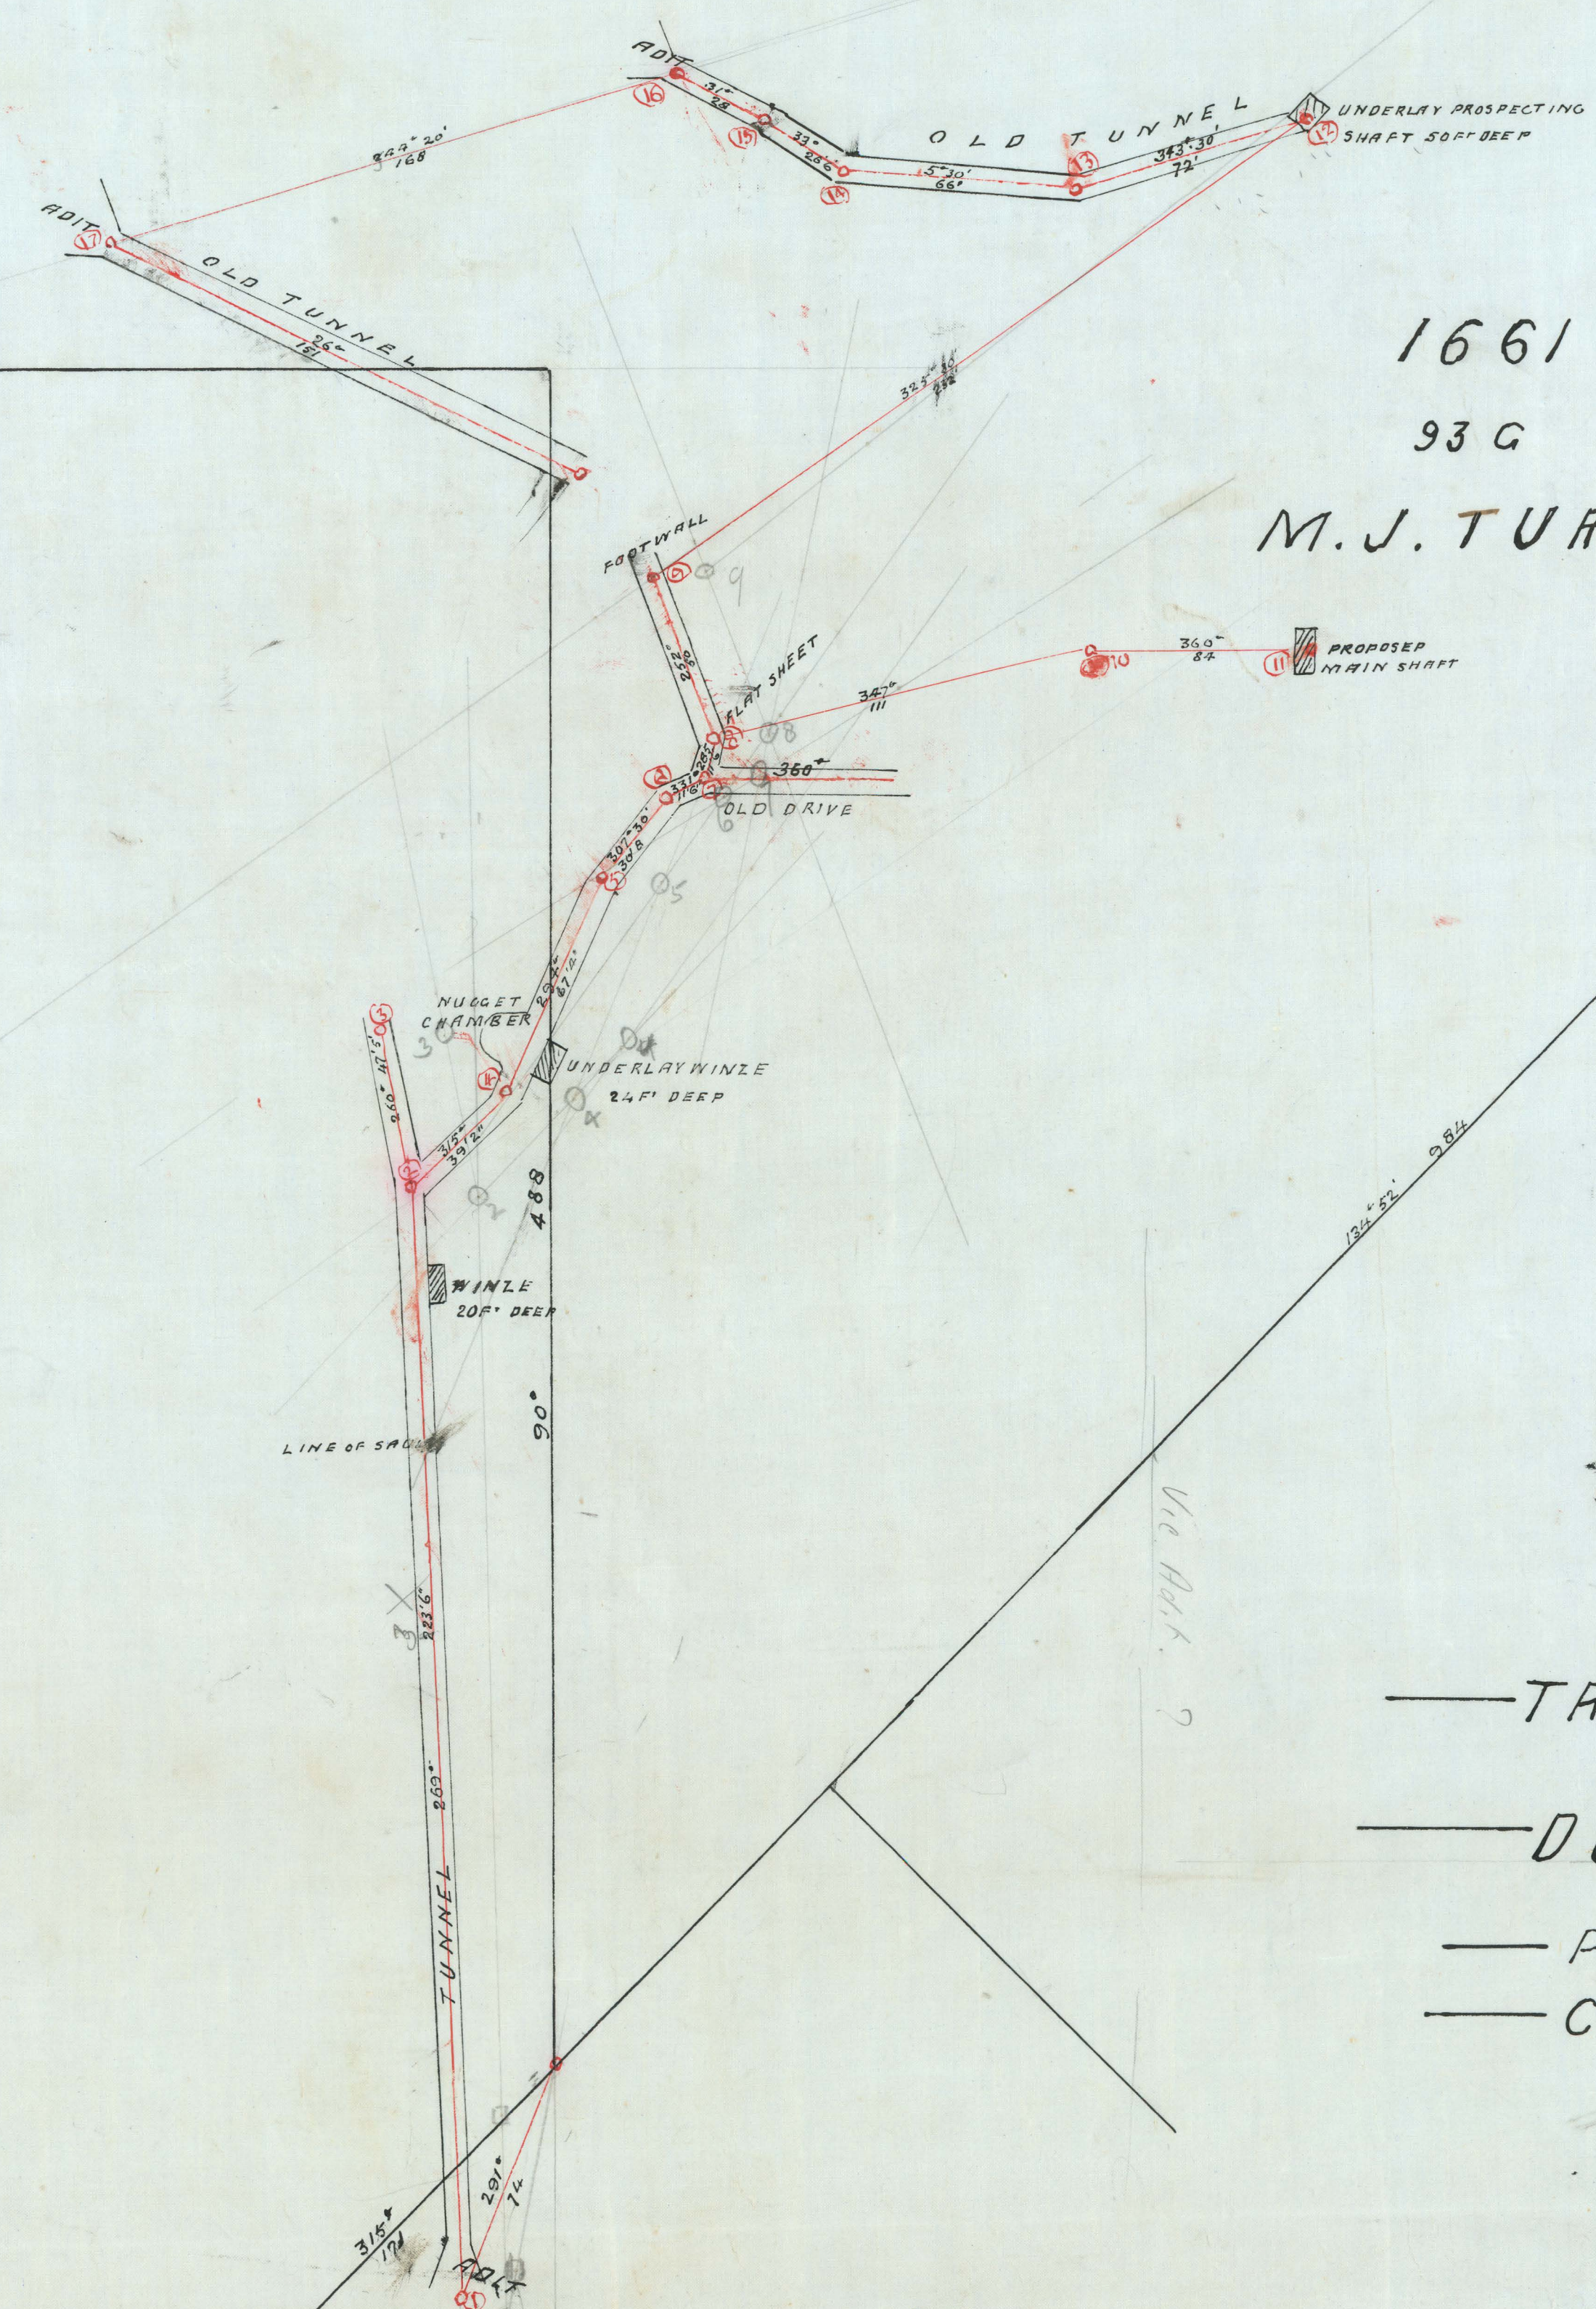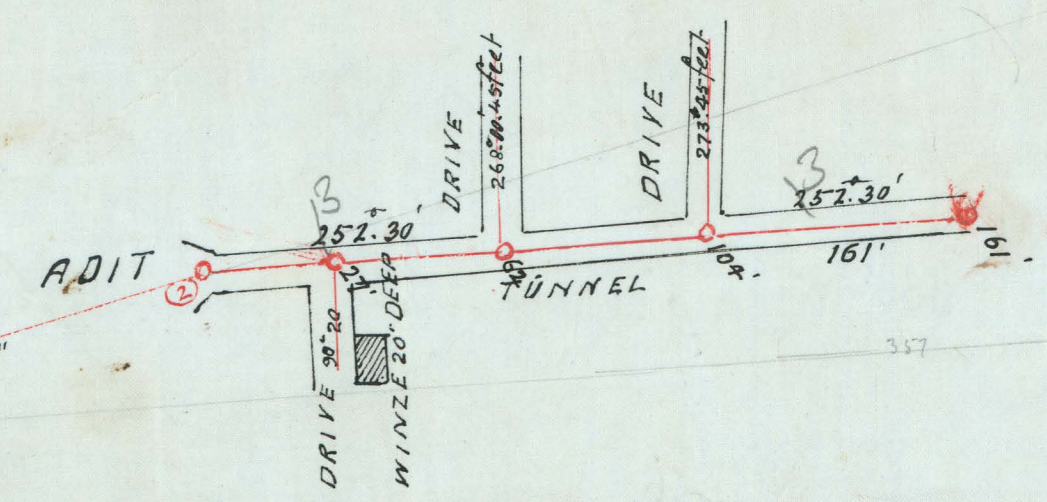

376  
93 G