



Longitudinal Section

Cross Section Through A-B

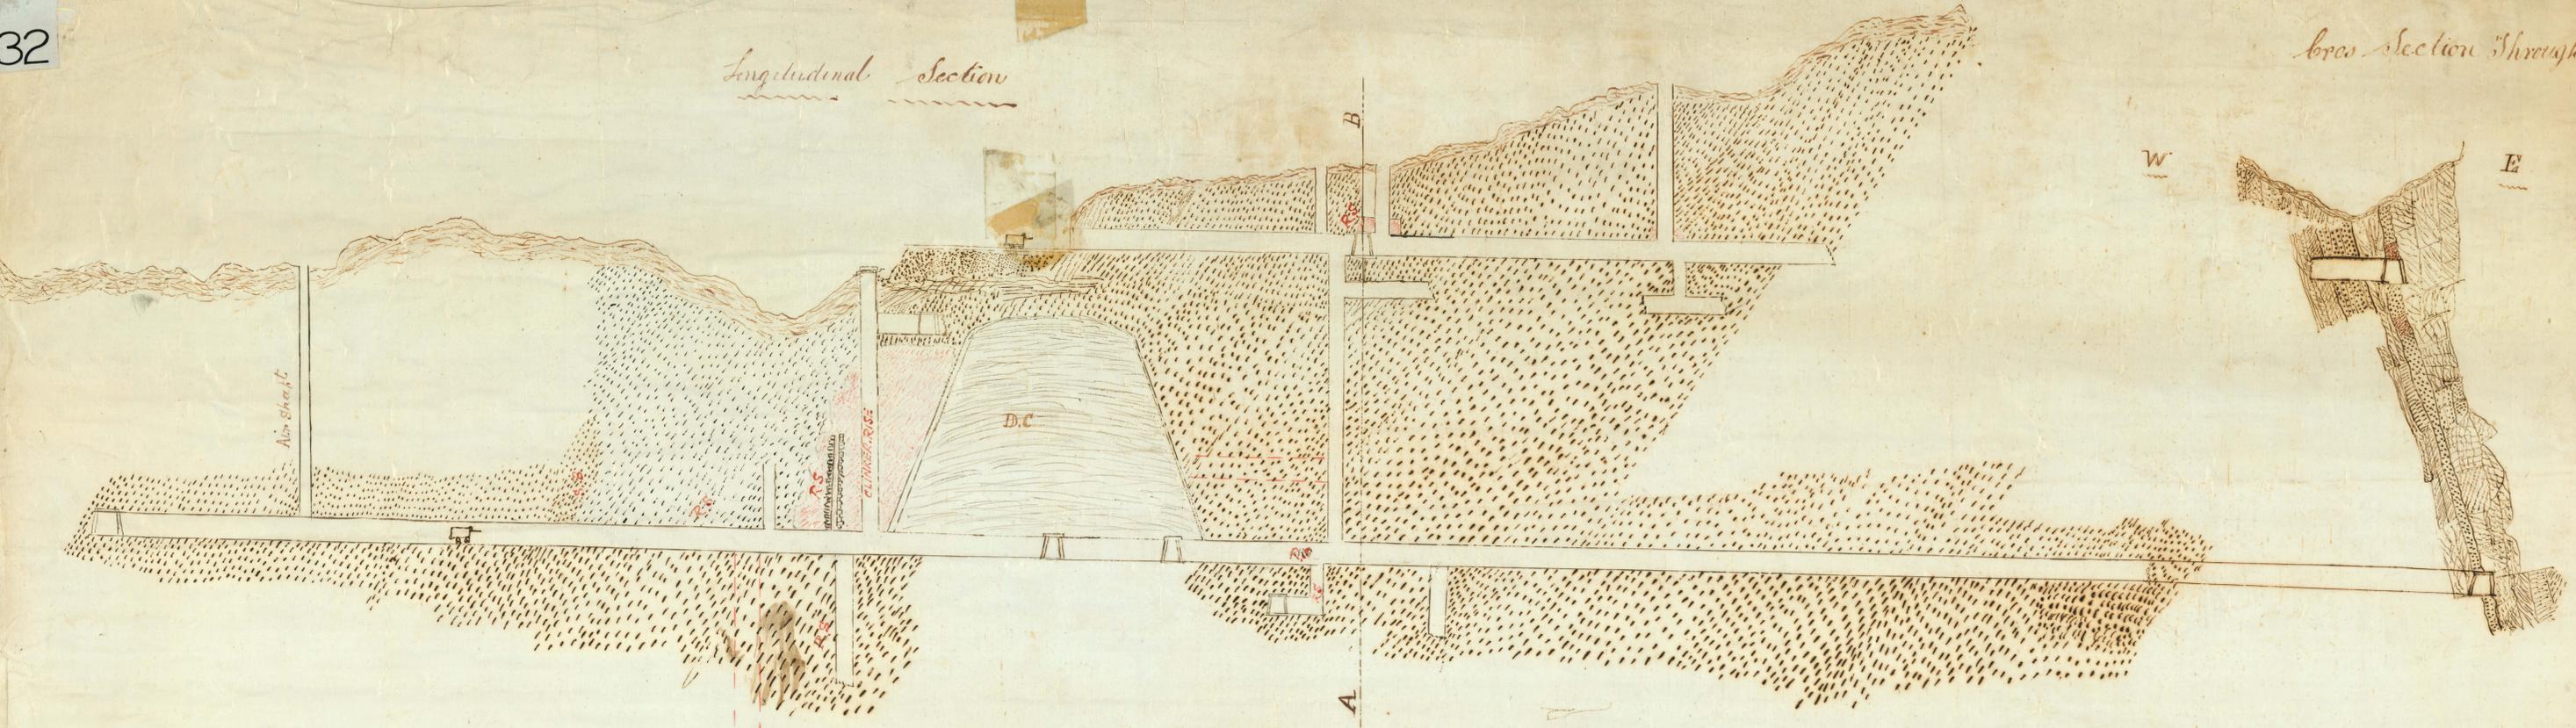

Plan

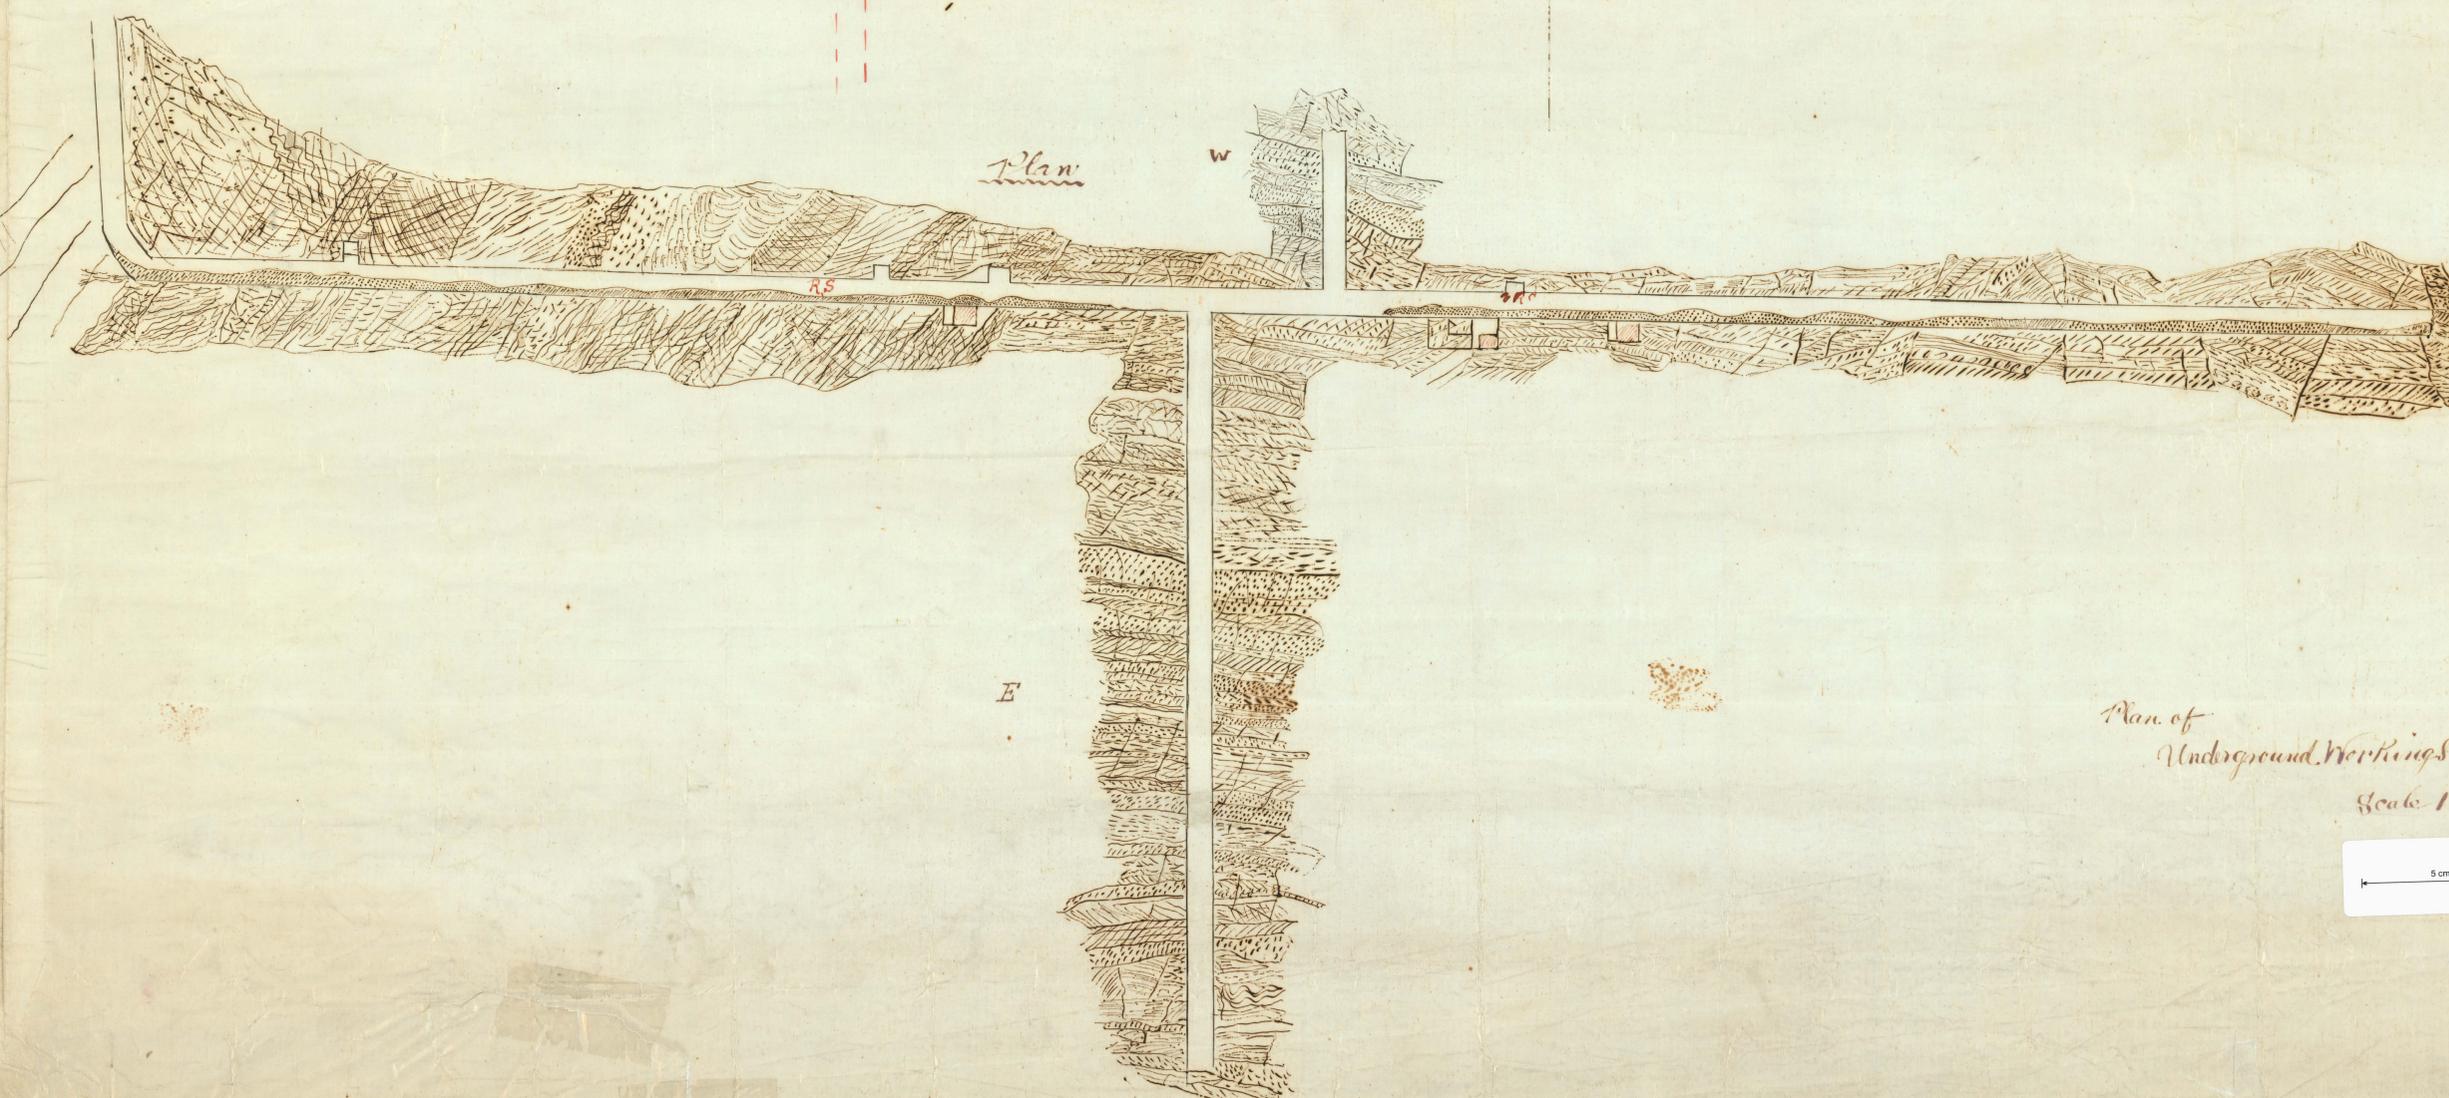

*Plan of Underground Workings Specimen Raf-Coy's
Scale 1" = 25 F.T.*

