


133

133-01

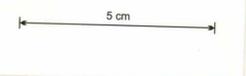

133-01

CAPTAIN C. M. C. M. NO. 114

LEFROY



Scale 25 feet to an inch

Ground Plan



Apr 11 1896
Capt. C. M. C.

Cross Section

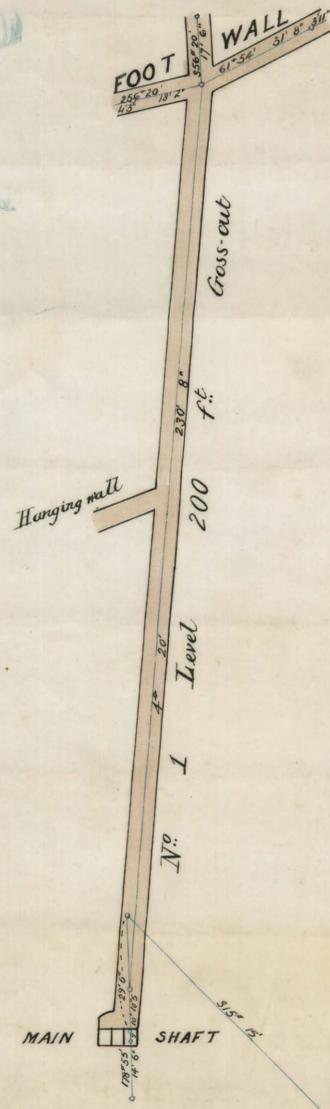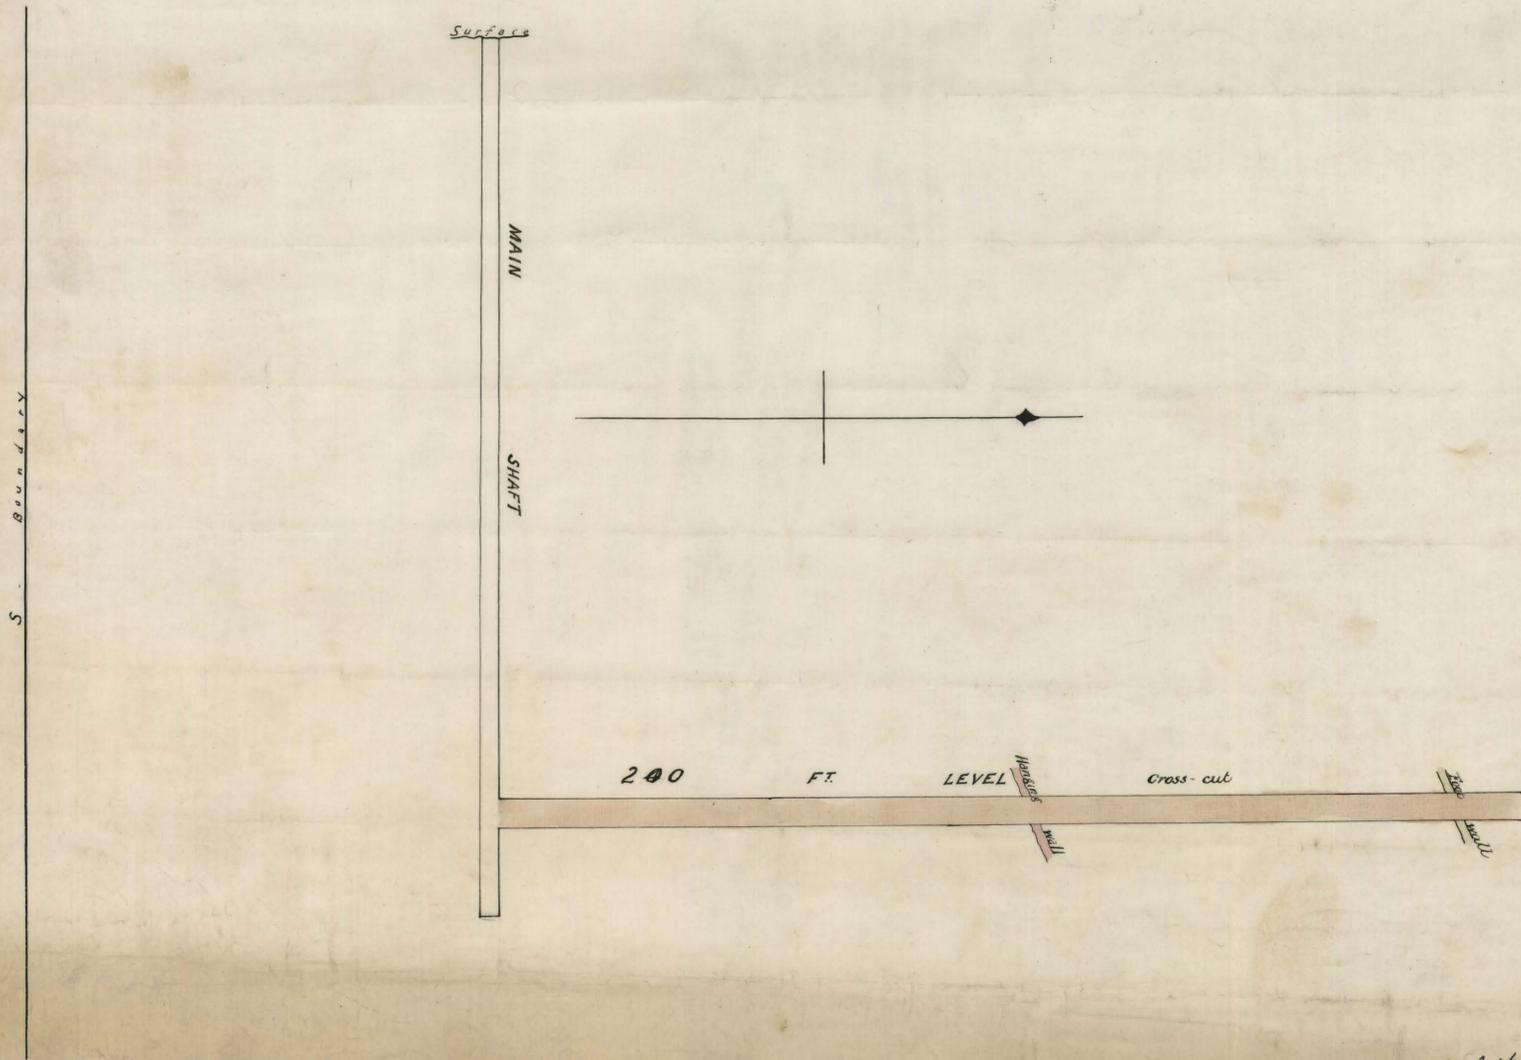

A. S. Miles.
Authorized Surveyor
Lefroy.
Jan'y '96.

Apr 11 1896
Capt. C. M. C.