


134-01



134-02

134

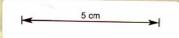


BACK CREEK DEEP LEADS


GOLD MINING C., N. L.

PLAN

SCALE - 40 Feet to 1 Inch.

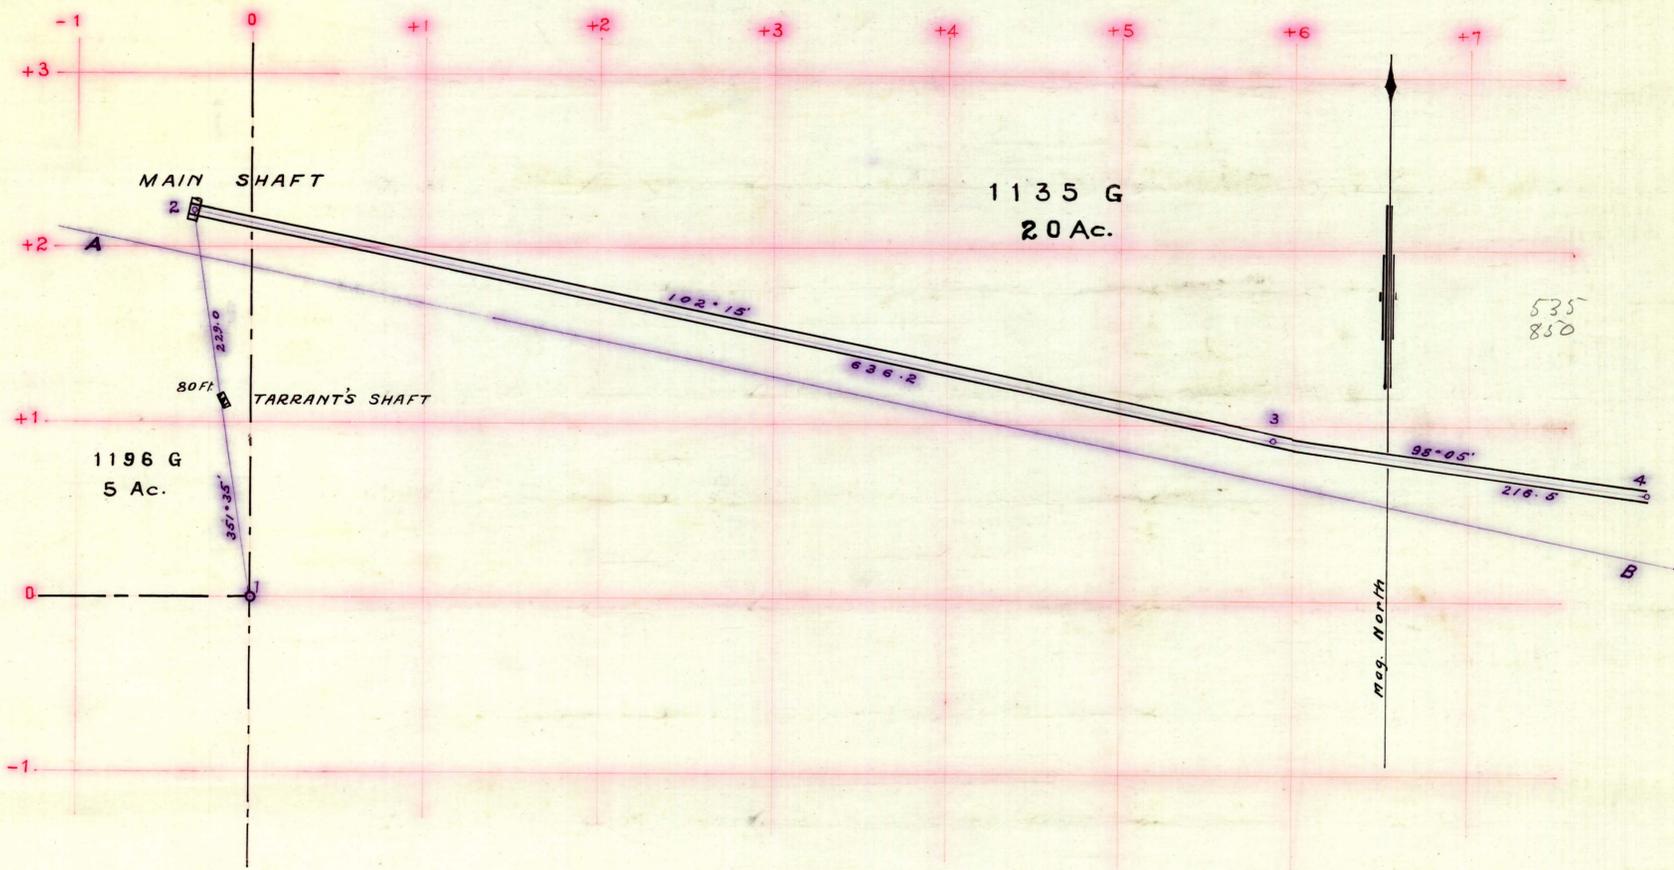

LONGITUDINAL SECTION A-B

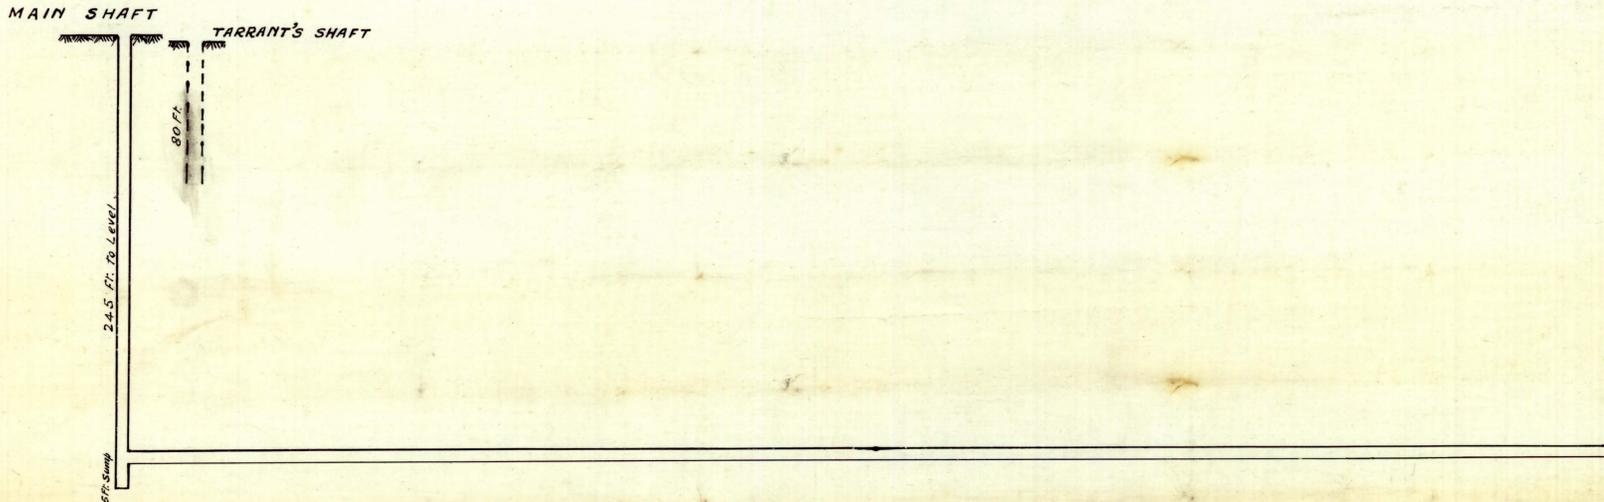

NOTE -
 Bearings taken from Daniell's Survey
 and plotted by A. M. Reid, 23 July, 1917.

Back Creek
②

Peak from

1135

850