


135-02



135-02

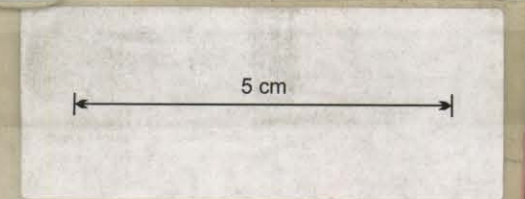

EAST CLARENCE C.M.C^o NO LIA

LEFROY

Scale 25 feet to an inch

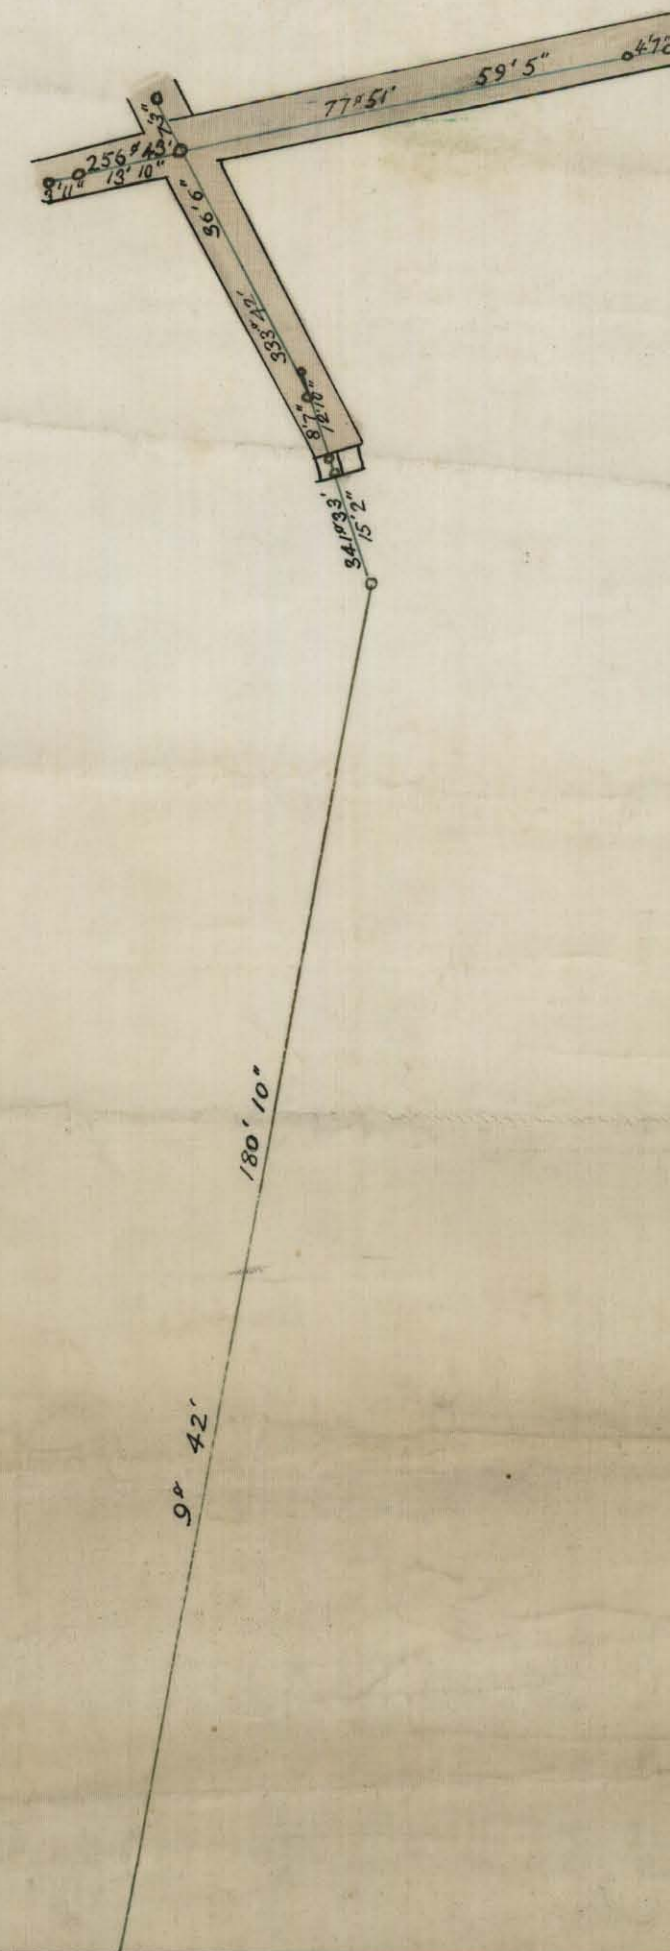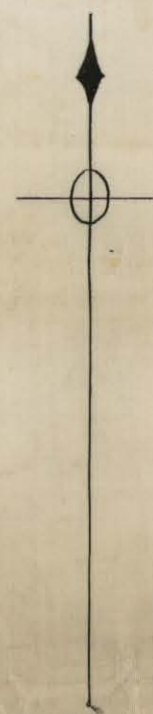

90°

353' 2"

360°

M. F. Miles.
Authorized Surveyor
Leboy
May '96

Jan 1896
M. F. Miles