

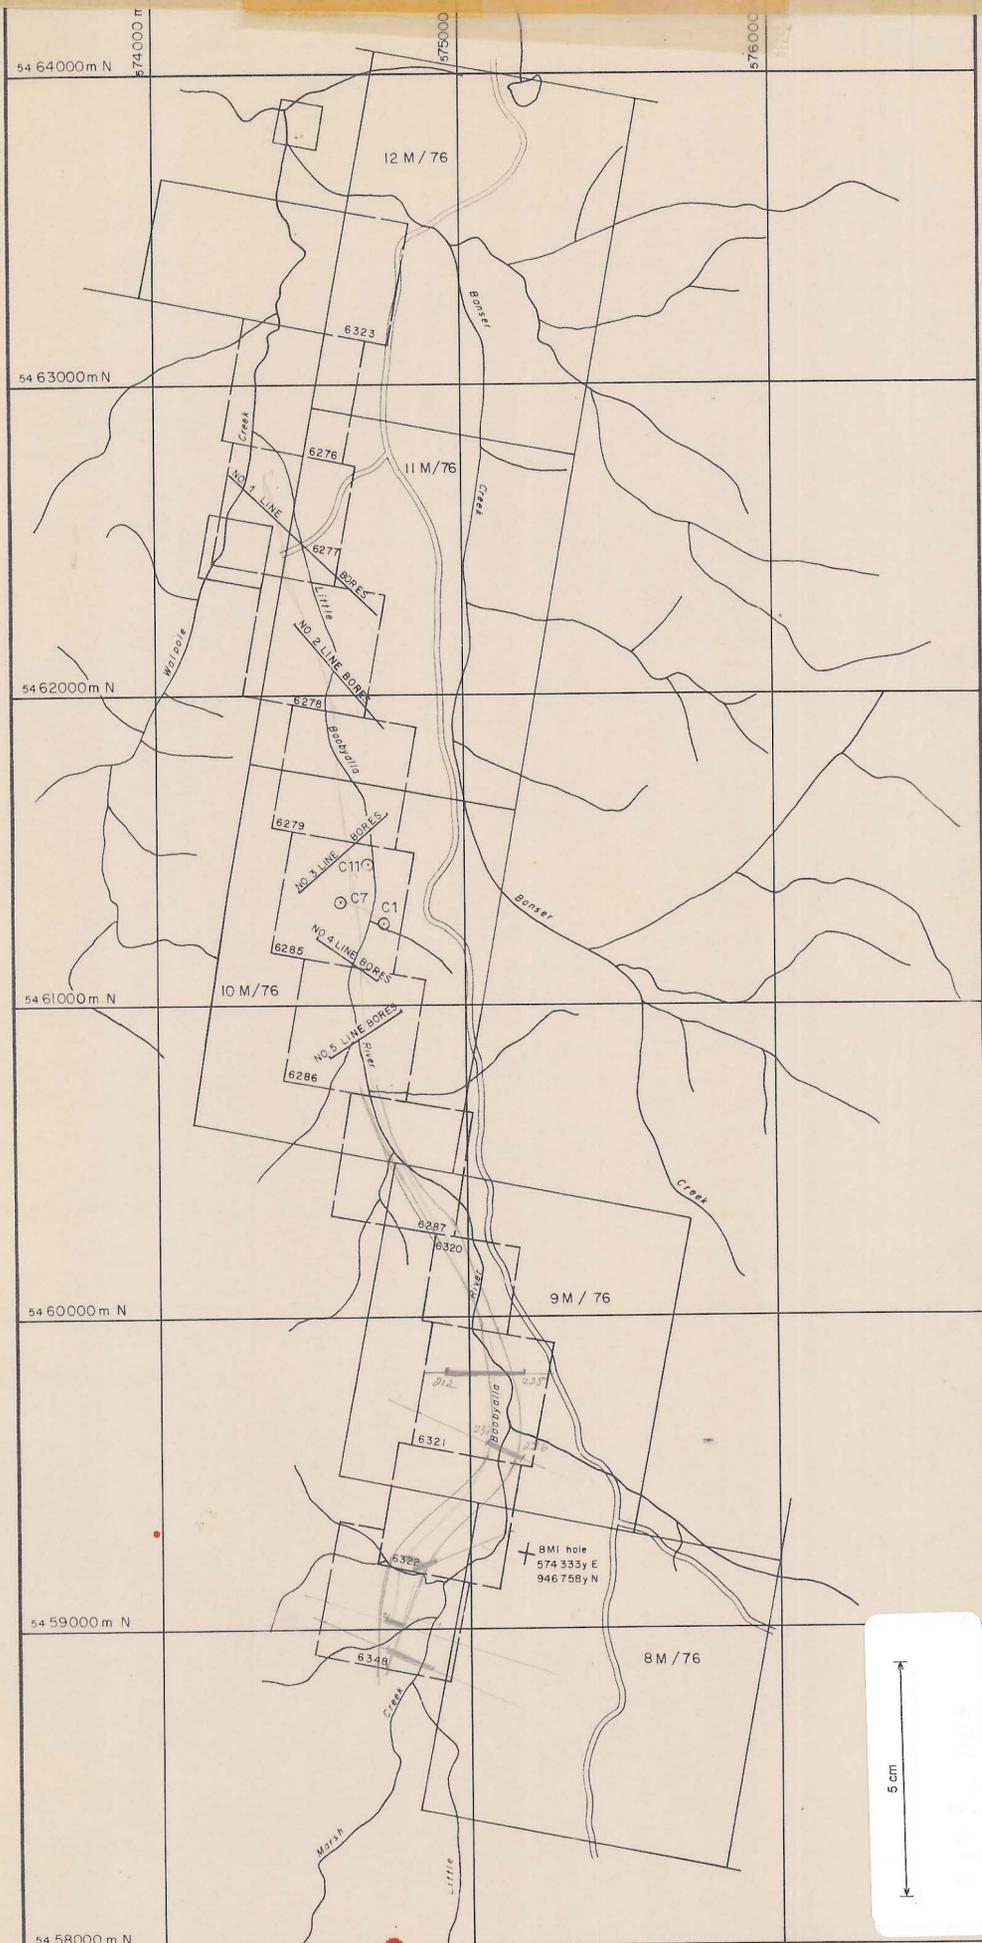


0135-003

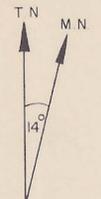

- Leases shown on old plan
- Lines of bore holes on old plan
- Existing leases
- Current Amdex drilling, approx location of hole only

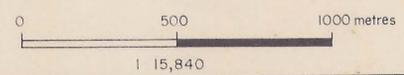

AMDEX MINING LIMITED	
CLARENCE, TASMANIA	
DRILL HOLE LOCATION PLAN	
DATA BY A Fleming	SCALE 1 : 15,840
DATE March, 1978	DRAWN BY C.C.