



PLAN

of

LONG PLAINS MINING SYNDICATE PROPERTY UNDERGROUND WORKINGS

Scale 50 Feet to an inch

1898

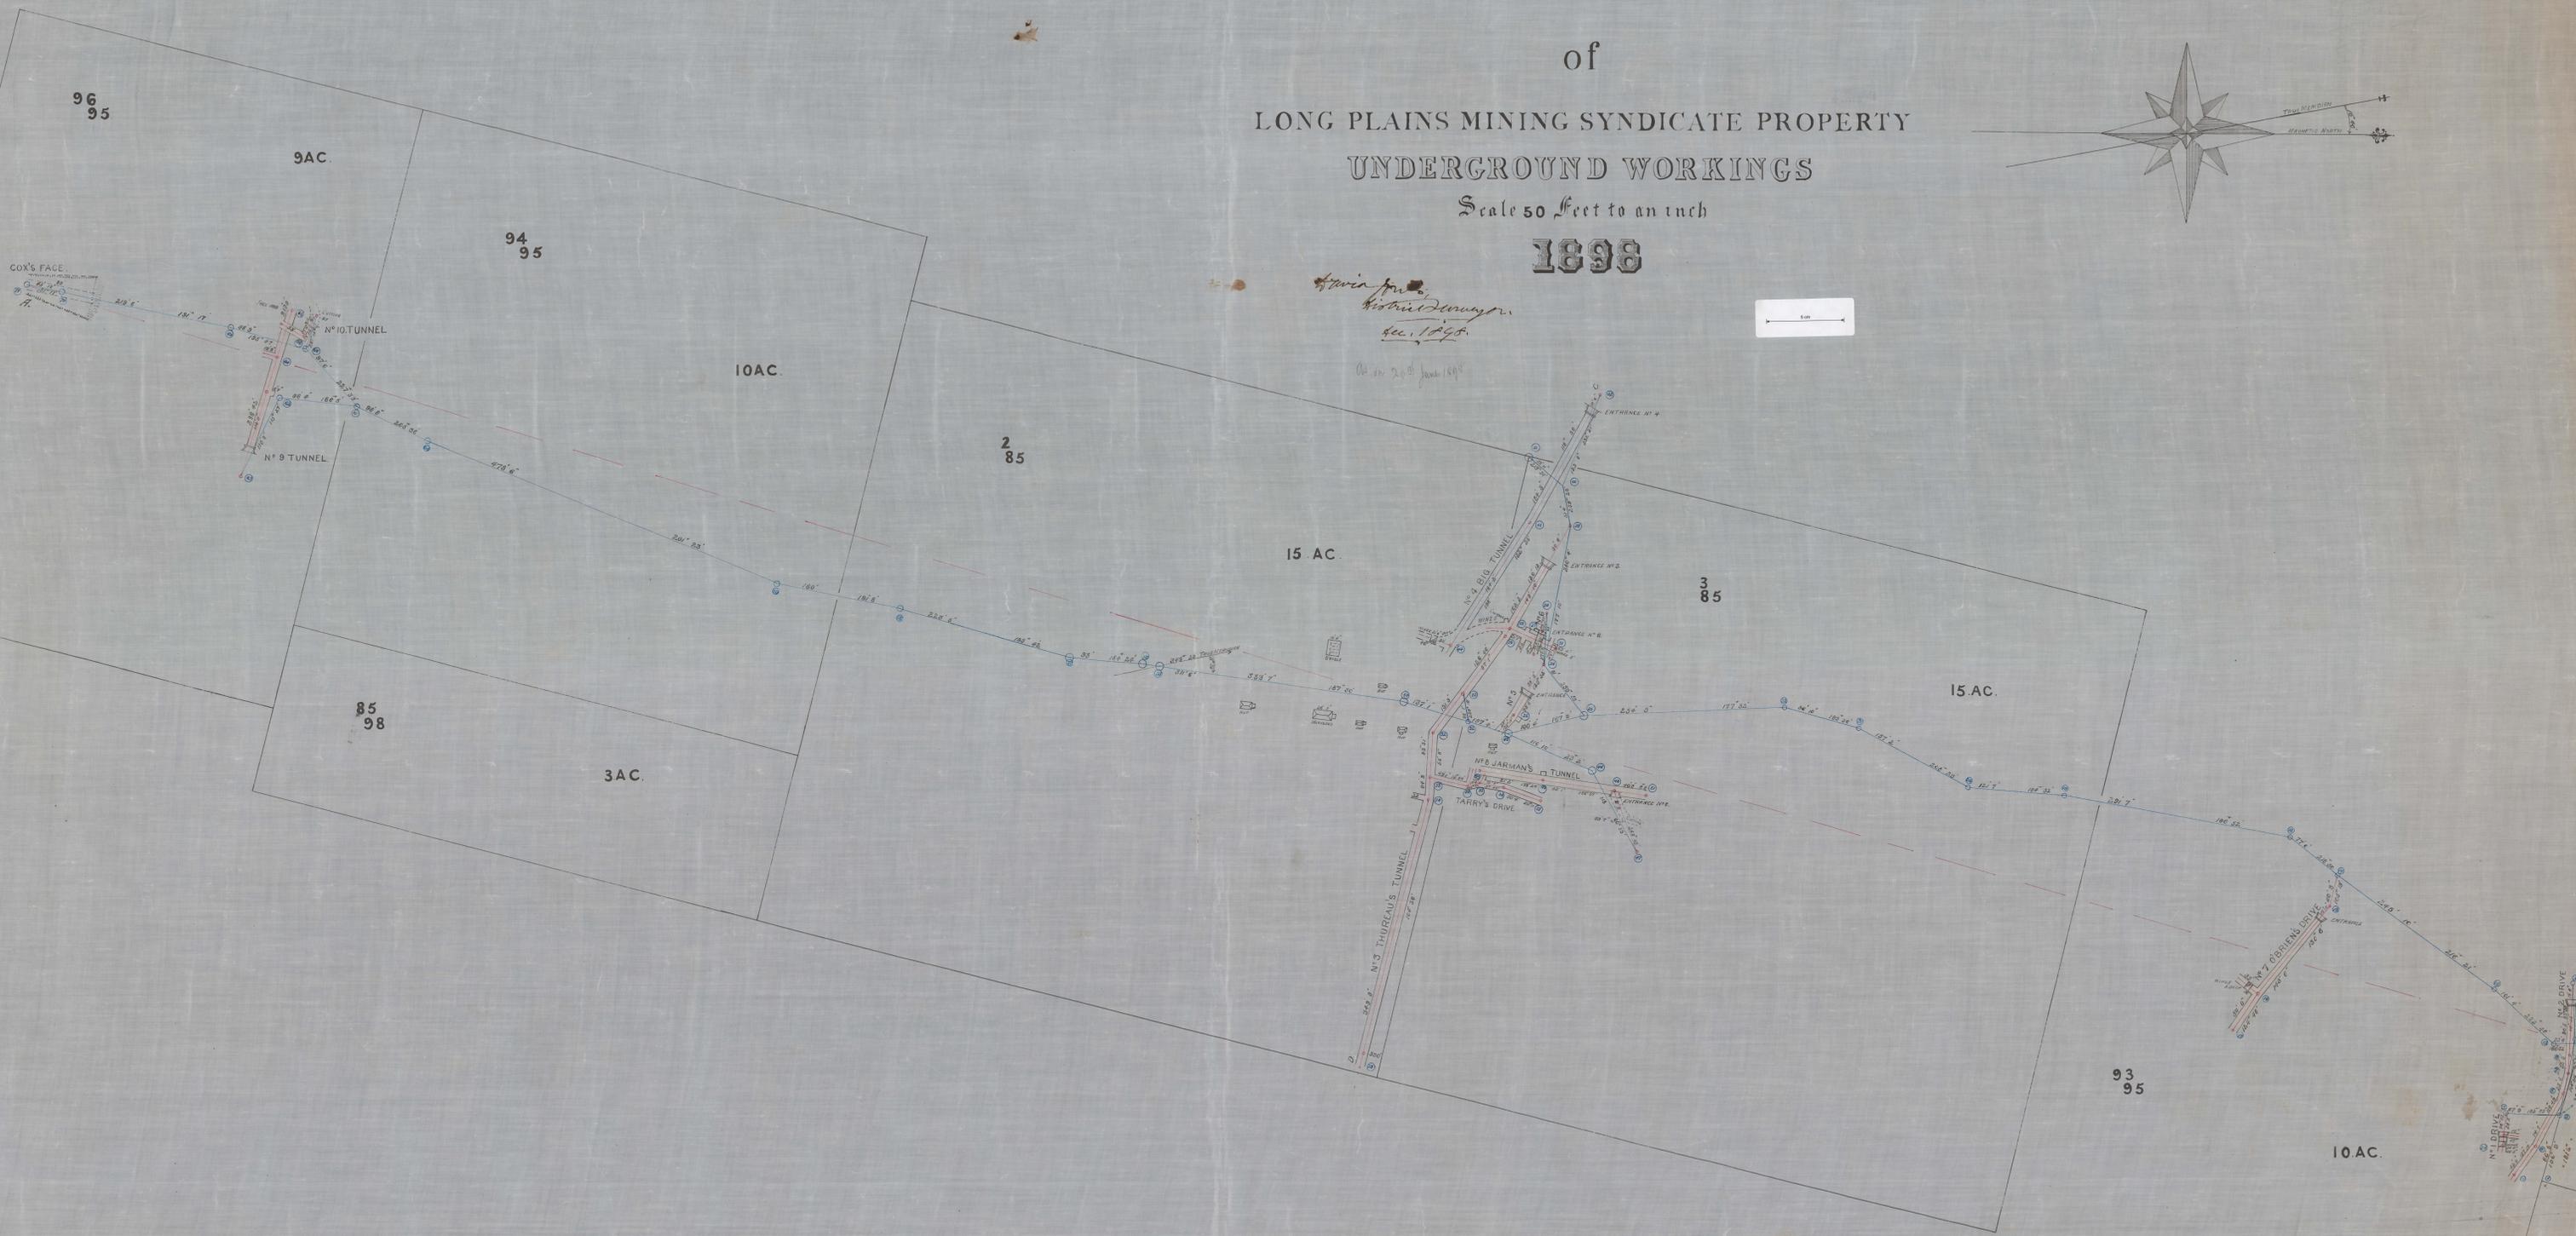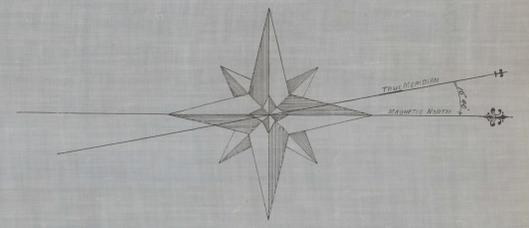

Wm. J. Jarman
District Engineer
Dec. 1898
Dec. 20th June 1899



115
95
10.