


604-93M 38 Ac
J. P. Madden

1857-91M 40 Ac
North Mount Lyell Consolidated M^cN.L.

1959-93M

Underground Workings
July 2 1900
Western Tharsis M^cN.L.
Scale 30 Feet to 1 Inch.
Survey made with theodolite & steel band chain

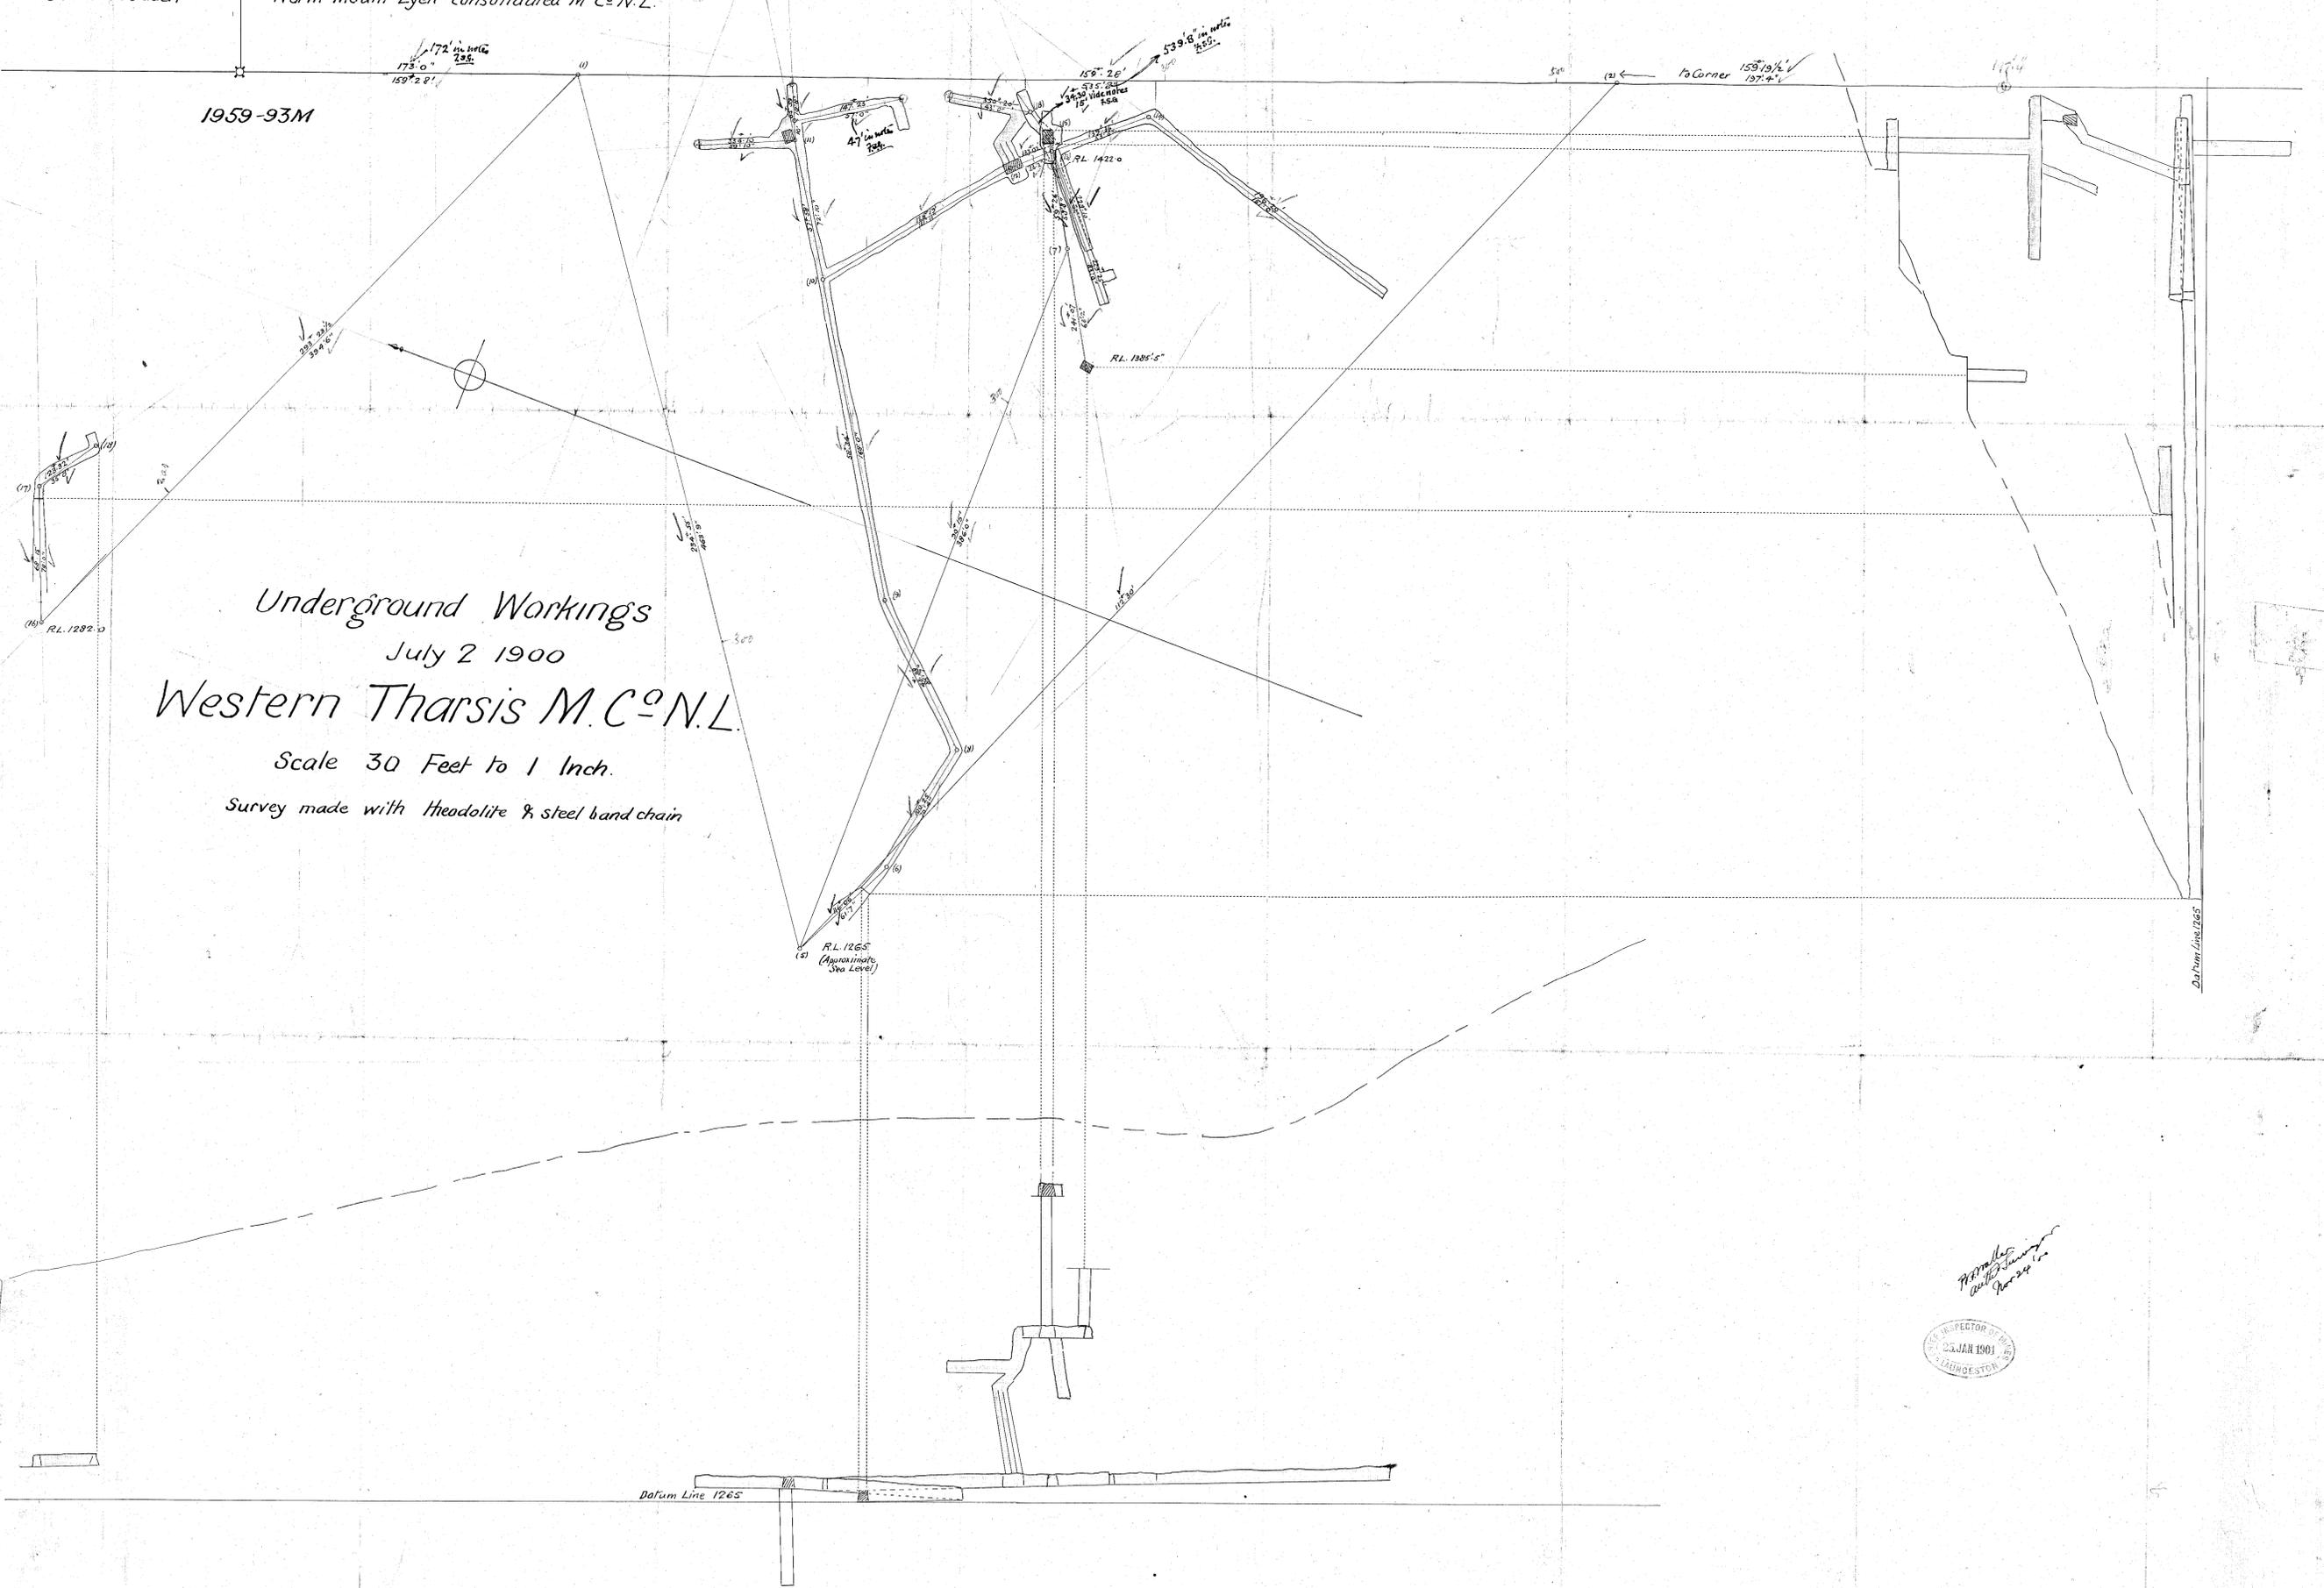

158-02

158-02

50.00
100.00
1000
900
800
700
600
500
400
300
200
100
0

Inspector of Mines
23 JAN 1901
LAUNCESTON

1000
900
800
700
600
500
400
300
200
100
0

NOVEMBER 1900