


5 cm

Mt Lyell 1881 plan map 139-01

SOUTH M^t Lyell Mining Coy

Underground Extension for 1896

Scale 25Ft to an inch

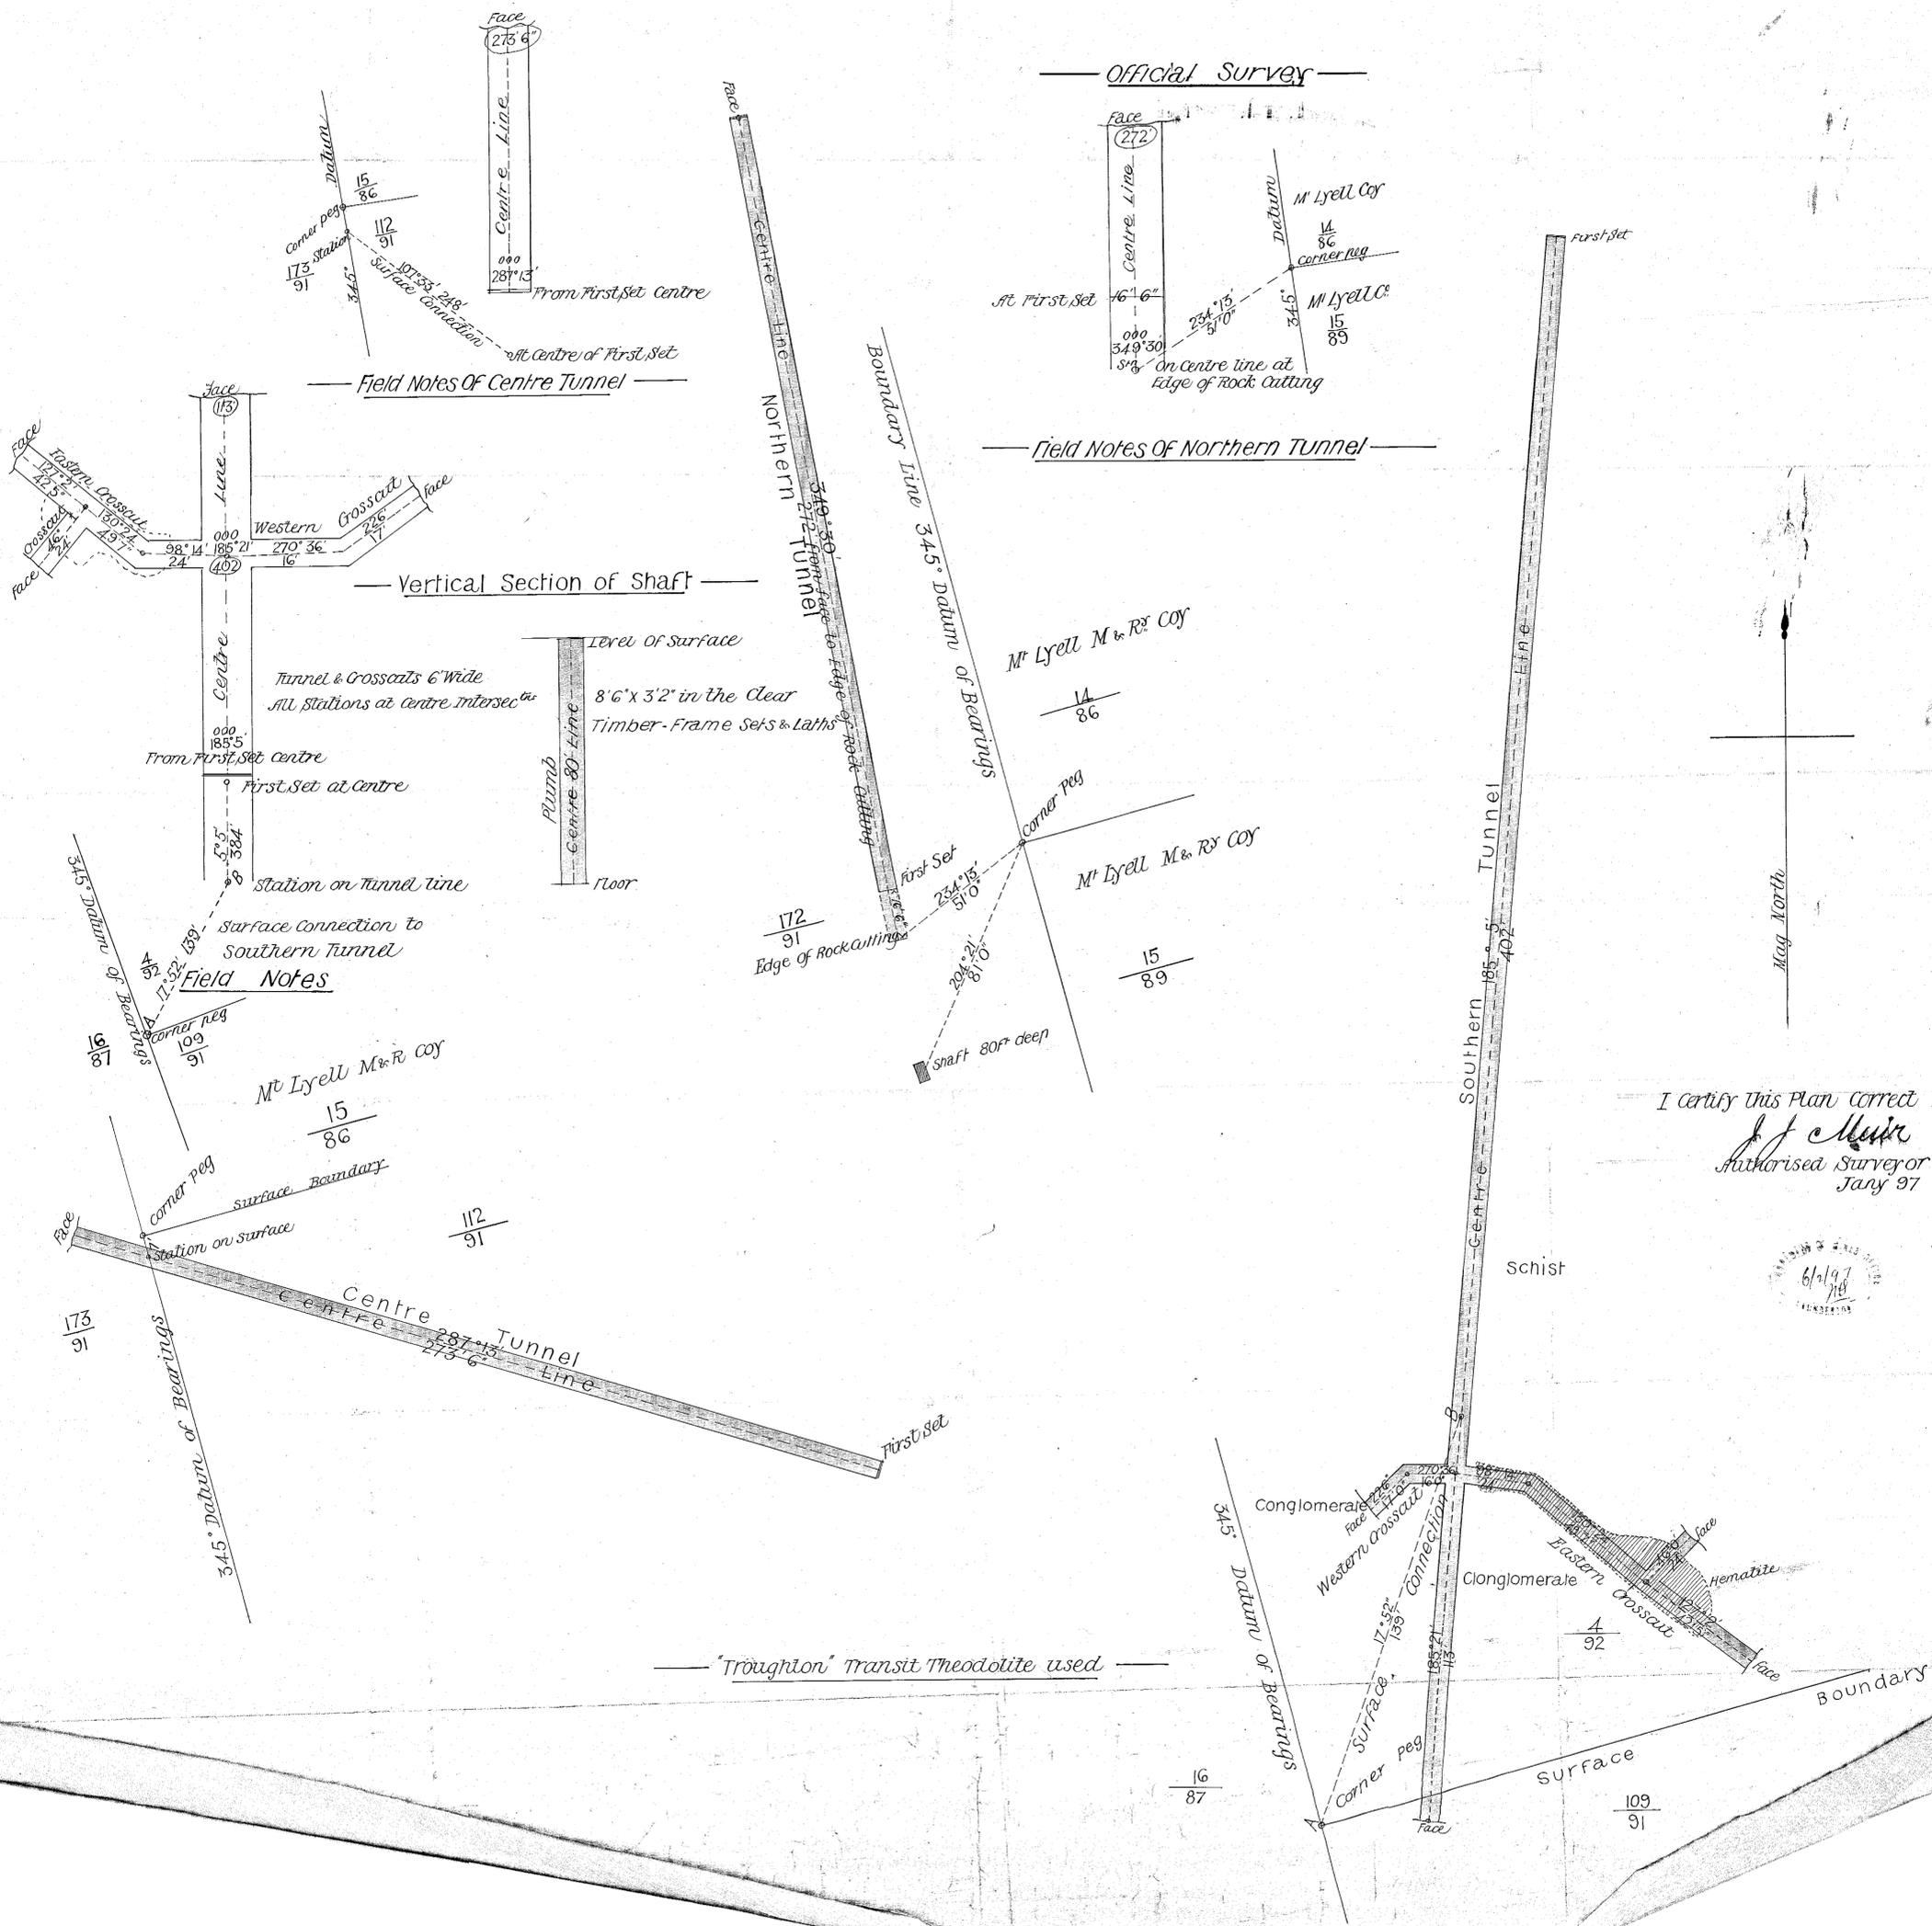

Official Survey

Field Notes Of Centre Tunnel

Field Notes Of Northern Tunnel

Vertical Section of Shaft

Field Notes

"Troughlon" Transit Theodolite used

I certify this Plan correct
J. J. Muir
 Authorised Surveyor Lyell
 July 97

