

5 cm

139-02

139-02

Sumner & Co. 1897
Surveying


— SOUTH M^t Lyell Mining Co. —

— Underground Extension for 1897 —

Scale 25ft to an inch

Certified Correct
J. J. Kinn
Authorized Surveyor.
May 9th.
J. J. Kinn

16 MAY 1898
TWO

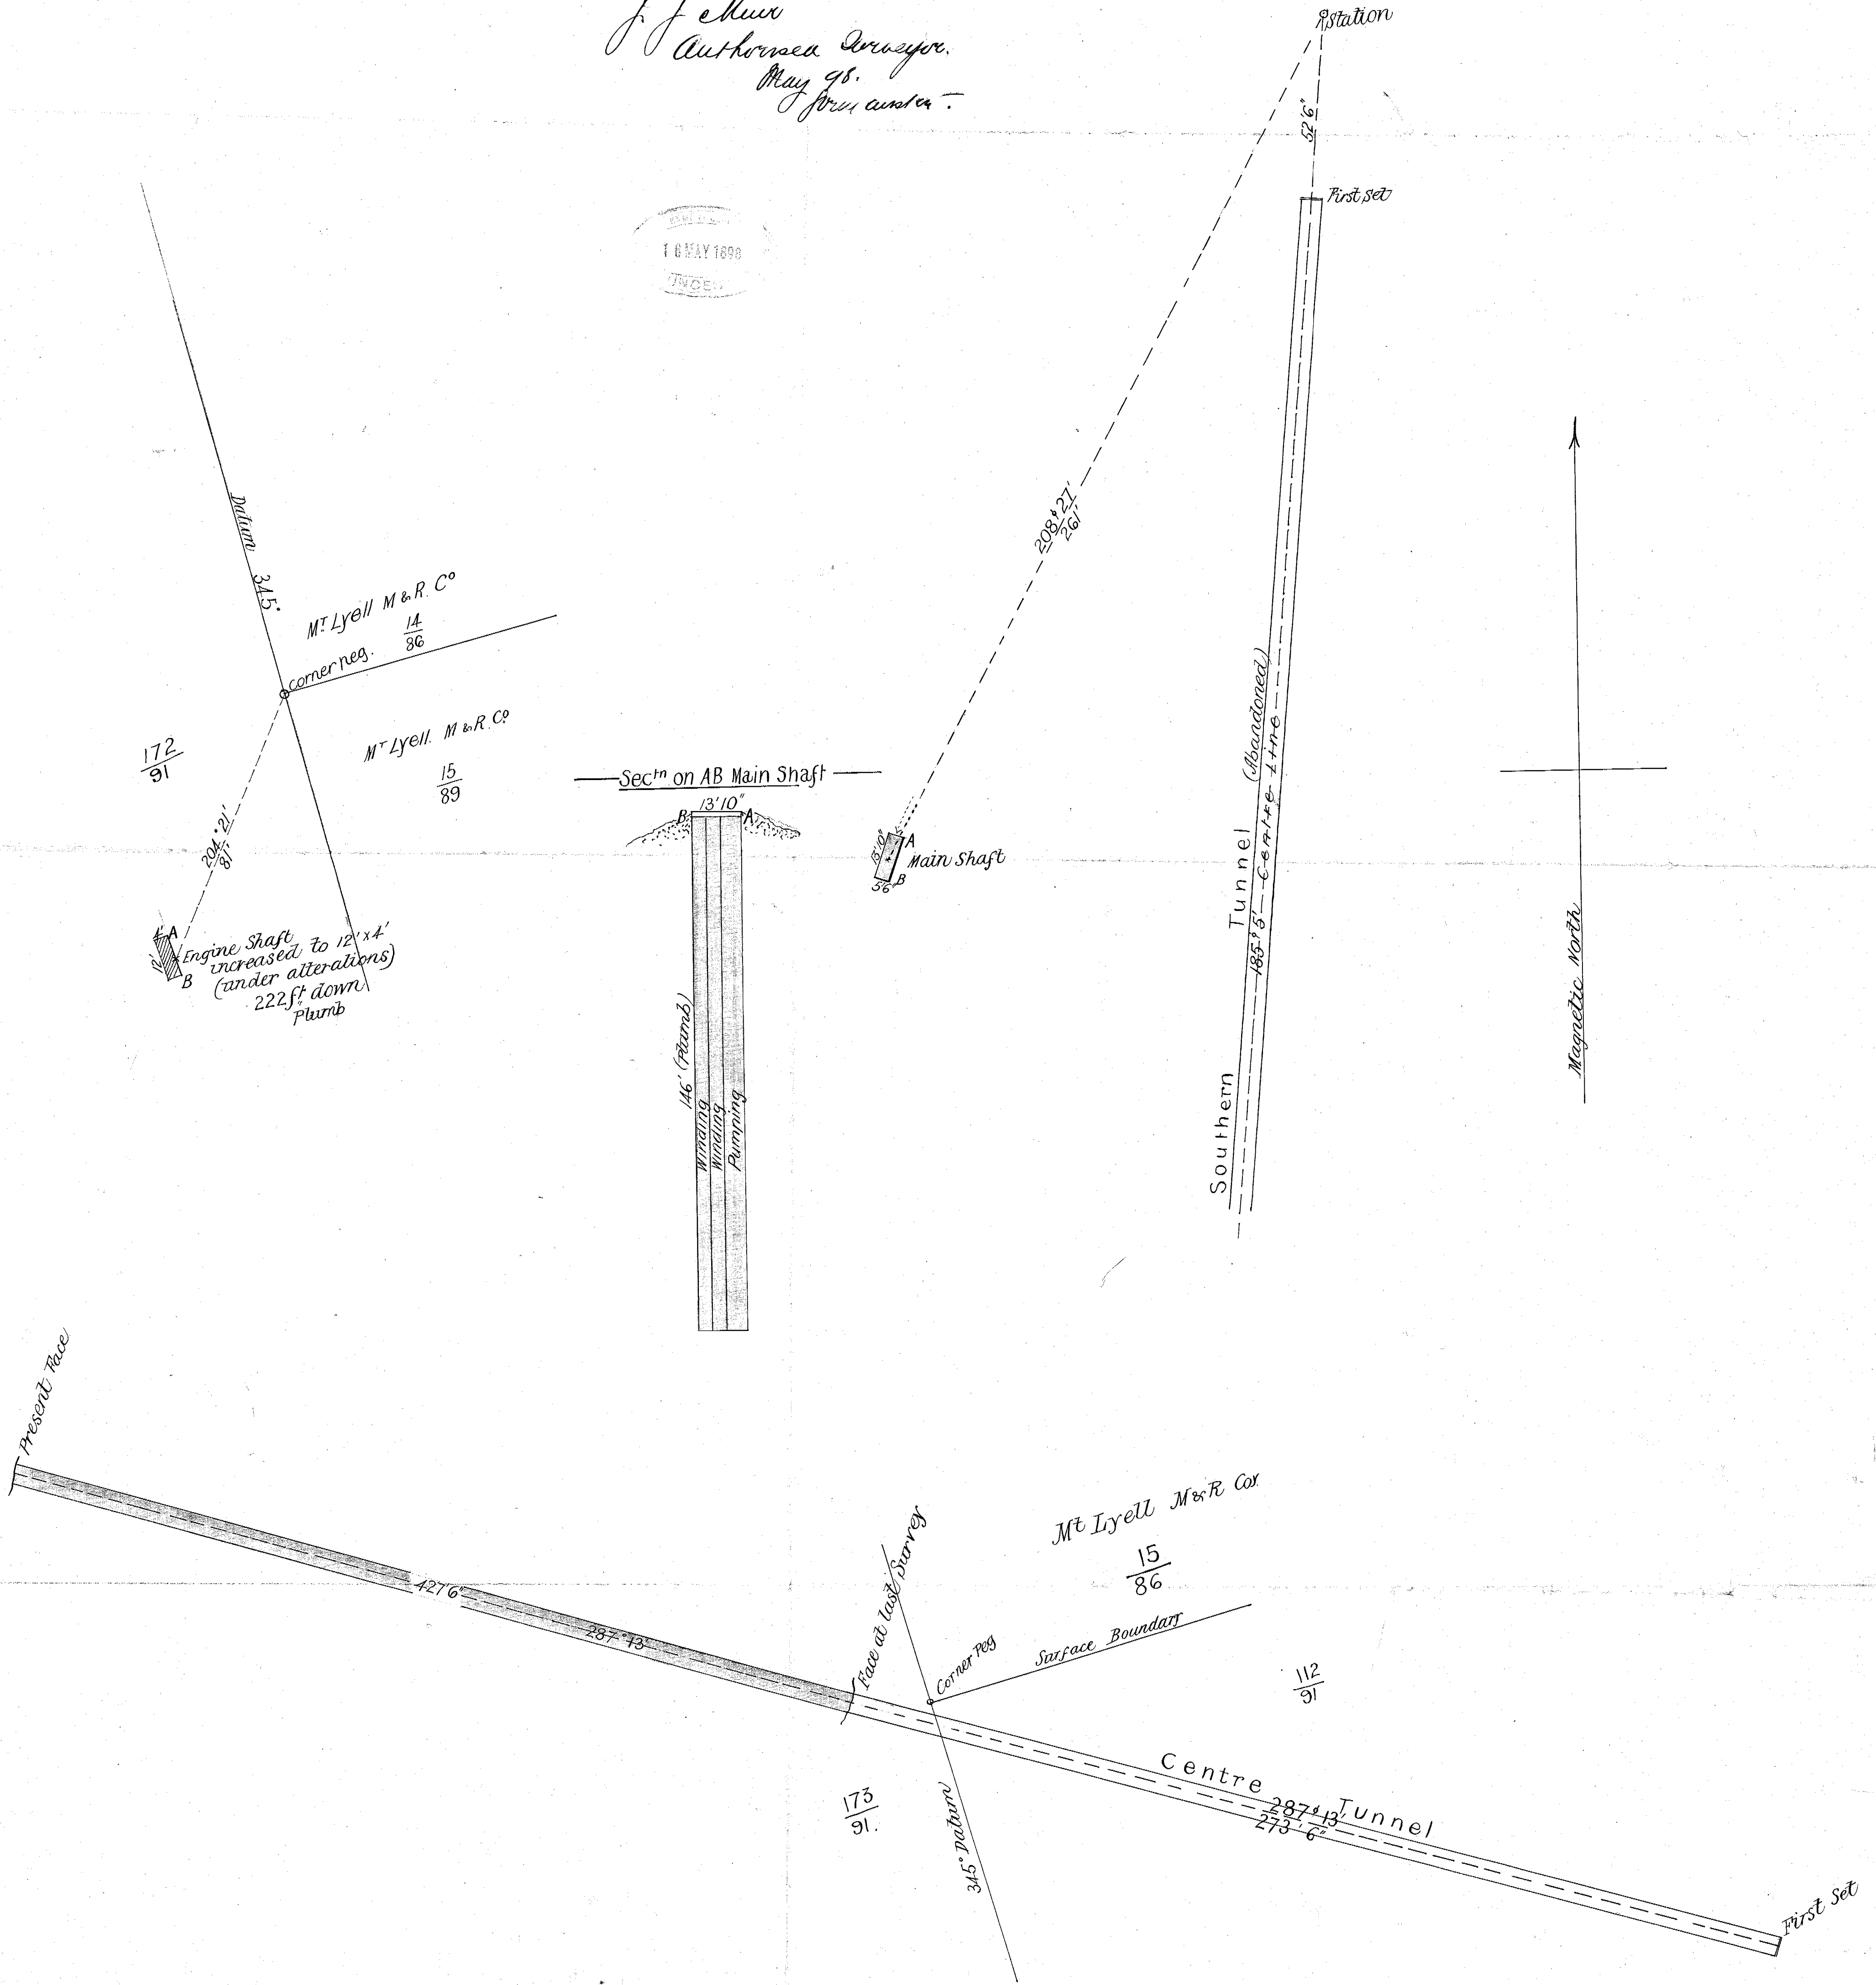

16 MAY 1898
TWO