
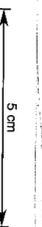


— Section on AB —

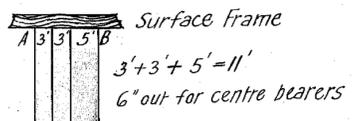


— **SOUTH MT LYELL MINING CO** —
 — **Underground Survey 1898** —

— Scale 25 Feet to an Inch —

February 1898 *J. J. Collins*
 Authorized cert.



— Scale 20 Feet to an Inch —

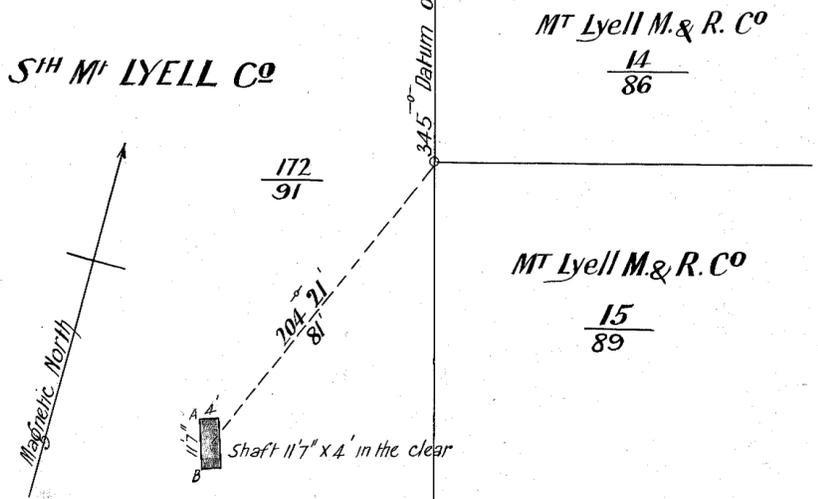

— Plan —
 25 Feet to an Inch

871 10
 2 1/2" dia shaft top & not round
 888 1/2