


140-01

140-01

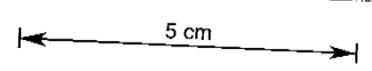

2

M^r Lyell Comstock Mine
Extensions for 1901
Scale 20 feet to an inch

J. J. Ullis
Authorized Surveyor
15th February 1902.

