


140-02

140-02

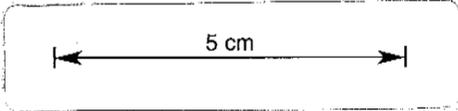

— M^r Lyell Comstock Mine —
 — Extensions for 1901 —
 — Scale 20 feet to an inch —

J. J. Ellwood
 Authorized Surveyor.
 15th February 1902.

