



140-03

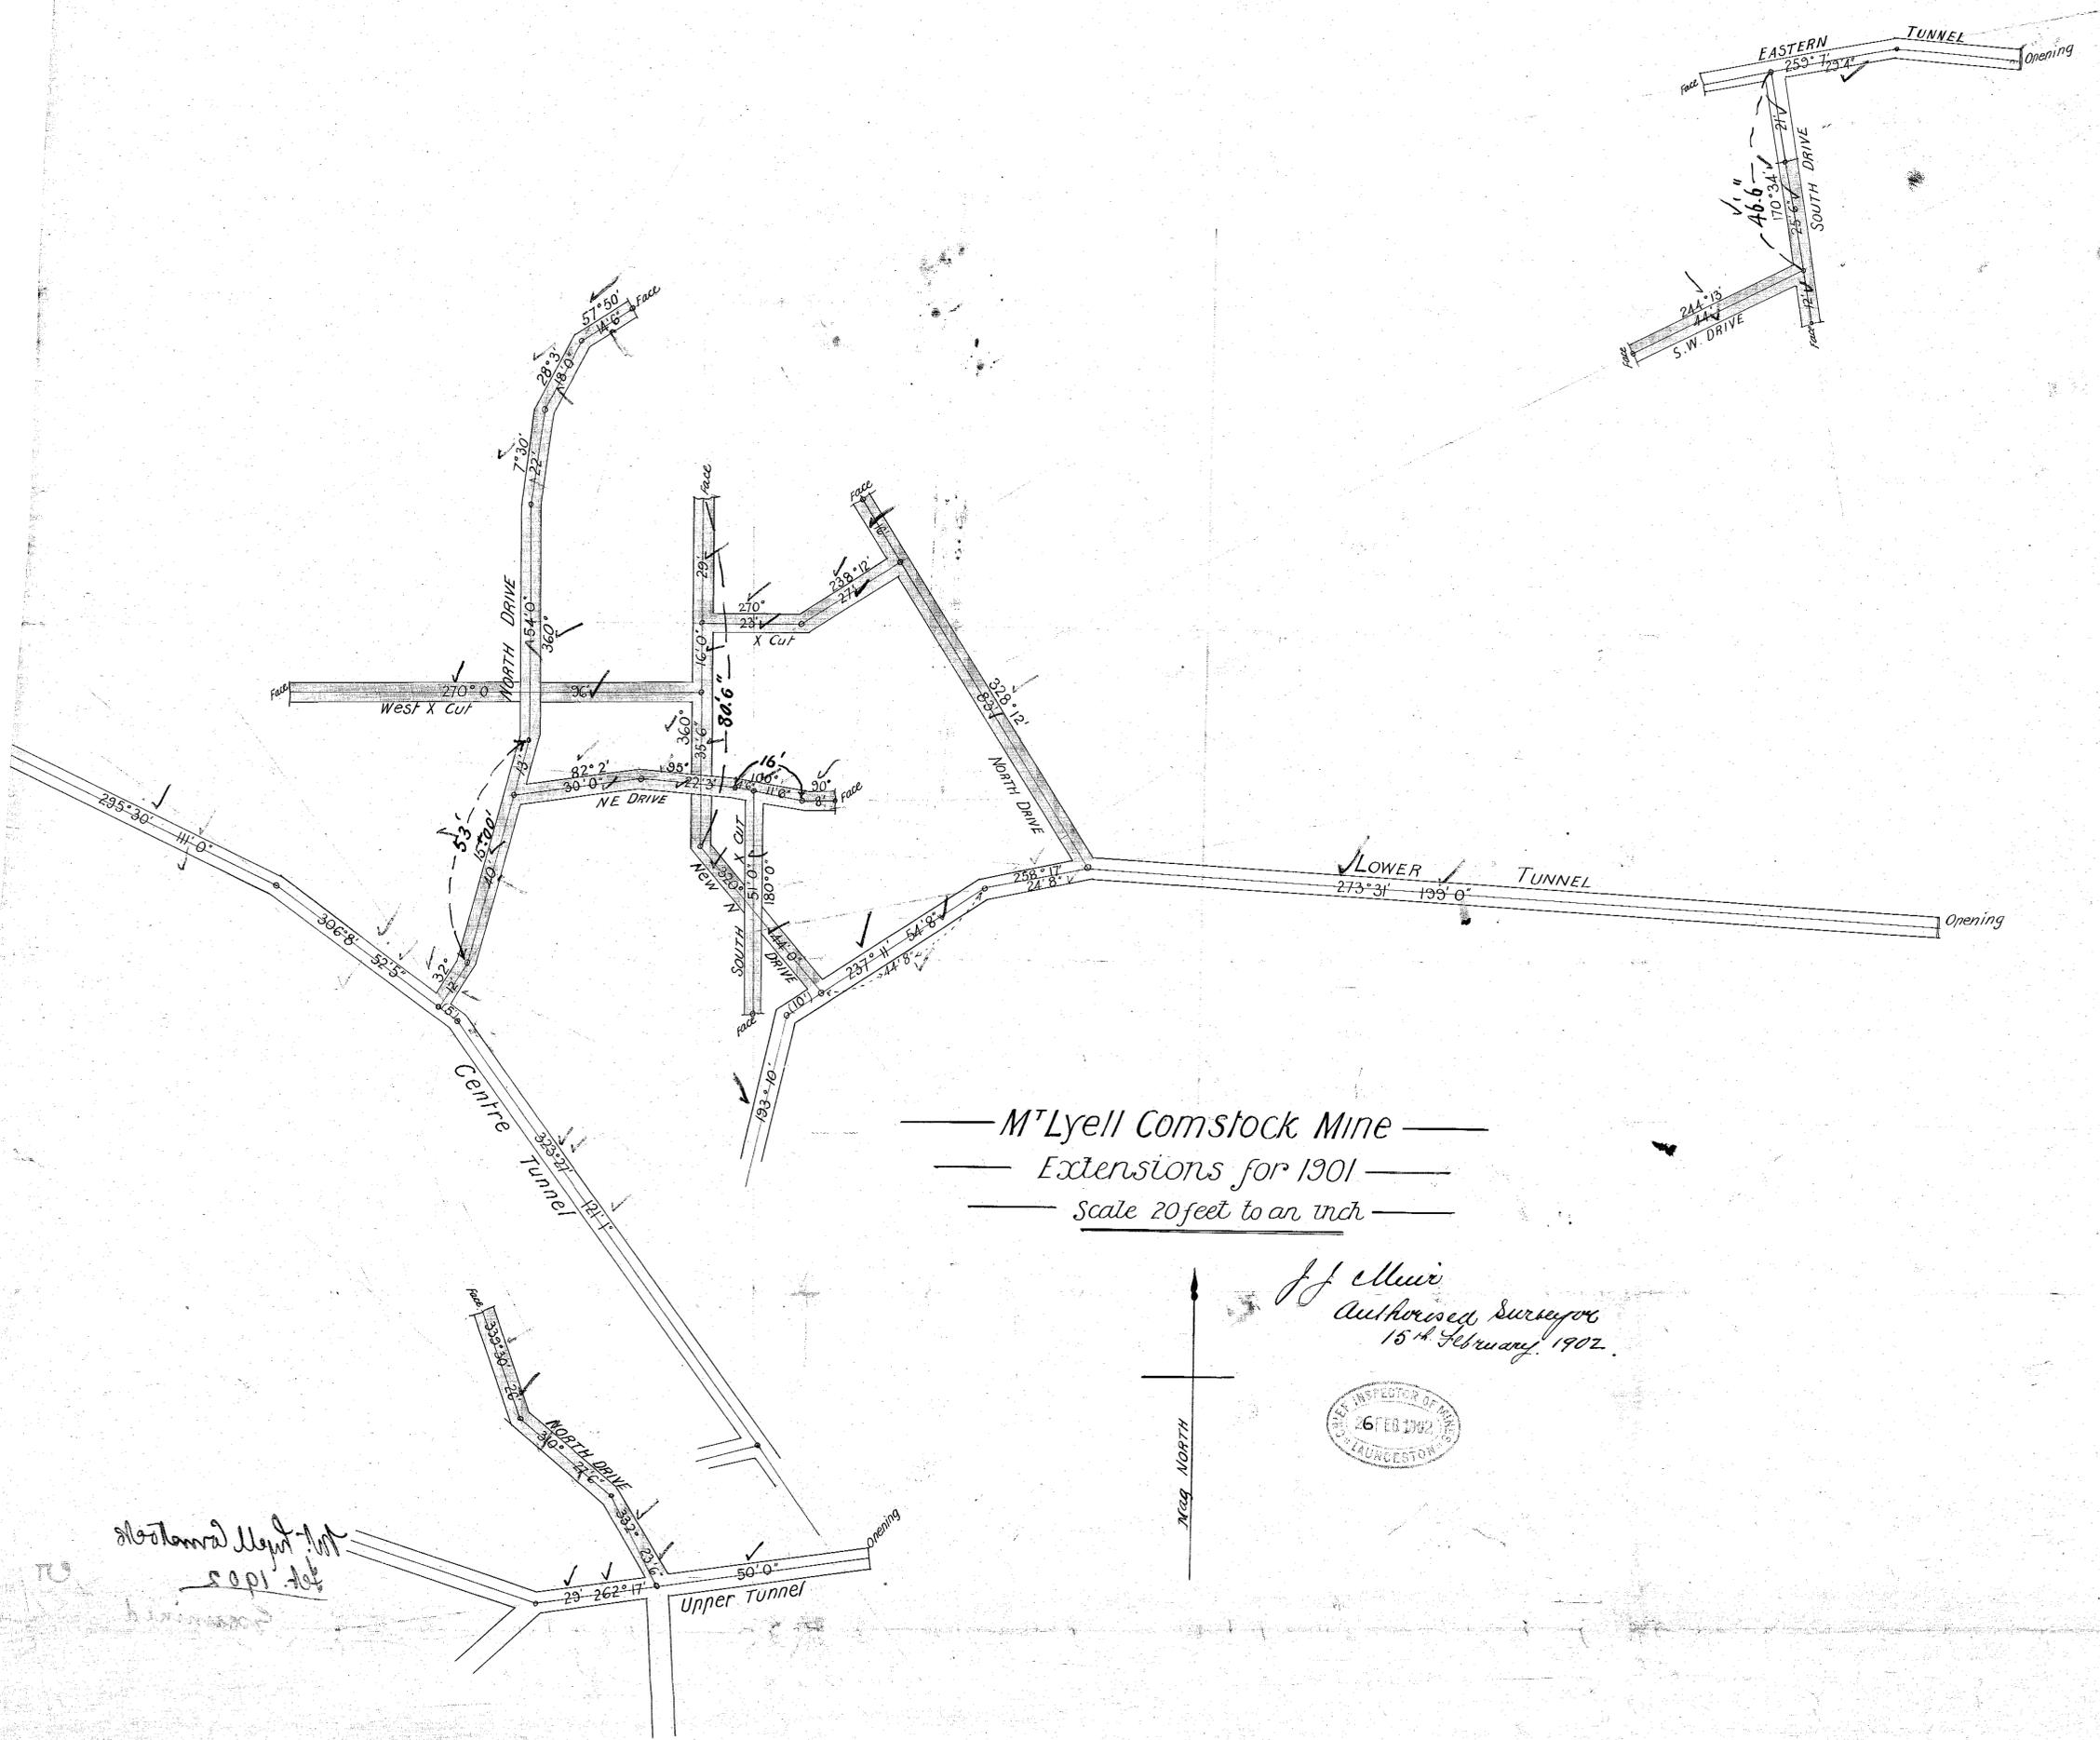

— M^t Lyell Comstock Mine —
— Extensions for 1901 —
— Scale 20 feet to an inch —

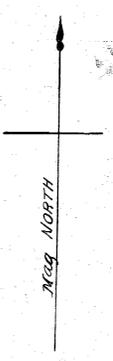

J. J. Muir
Authorized Surveyor
15th February, 1902.



Stock and Map of
M^t Lyell Comstock
1901

M^t Lyell Comstock
1901

101