

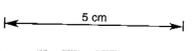


140-04

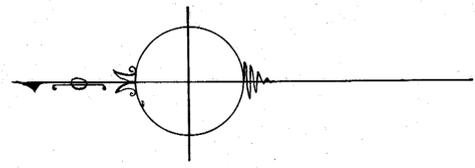

LYELL COMSTOCK CON. COPPER CO. LIM.

19 97 CL. 10 Ac. 76 Ac. 2136 91 M ML.

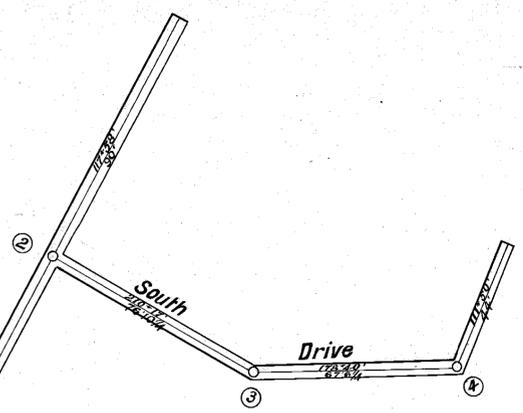

MAIN TUNNEL

J. J. Muir (Old Queen Lyell) 536 M 28 Ac.

LYELL COMSTOCK CON. COPPER CO. LIM. PLAN OF QUEEN TUNNEL Showing Extensions to Dec 31st 1904 Scale: 1"=30'



585 M 9 Ac.

FIELD NOTES Instrument Used: 5" Theodolite

2'	Face 44'	2'
	00	
	111°50'	
2'	① 67°6 1/4'	2'
	00	
	178°40'	
2'	③ 76°10 1/4'	2'
2'6"	9'	2'6"
1'	2'6"	5'
	00	
	210°17'	
	Again at ② South Drive	
	Face 90'	
	00	
	117°58'	S. Drive
	② 581'2"	216°12'
	27'	Mouth
Start of	7'	Approach
	00	
	117°58'	
Iron pipe near	① 125'2 1/2'	mouth of tunnel
	00	
	126°41'	
Start at	①	N.E. Cor. Sec. 585 M

619 M 6 Ac.

M. LYELL M. AND R. CO. LIM.

602 93 M

Handwritten signature and date: R. B. Murray & Co. 3/11/05