


140-05

140-05

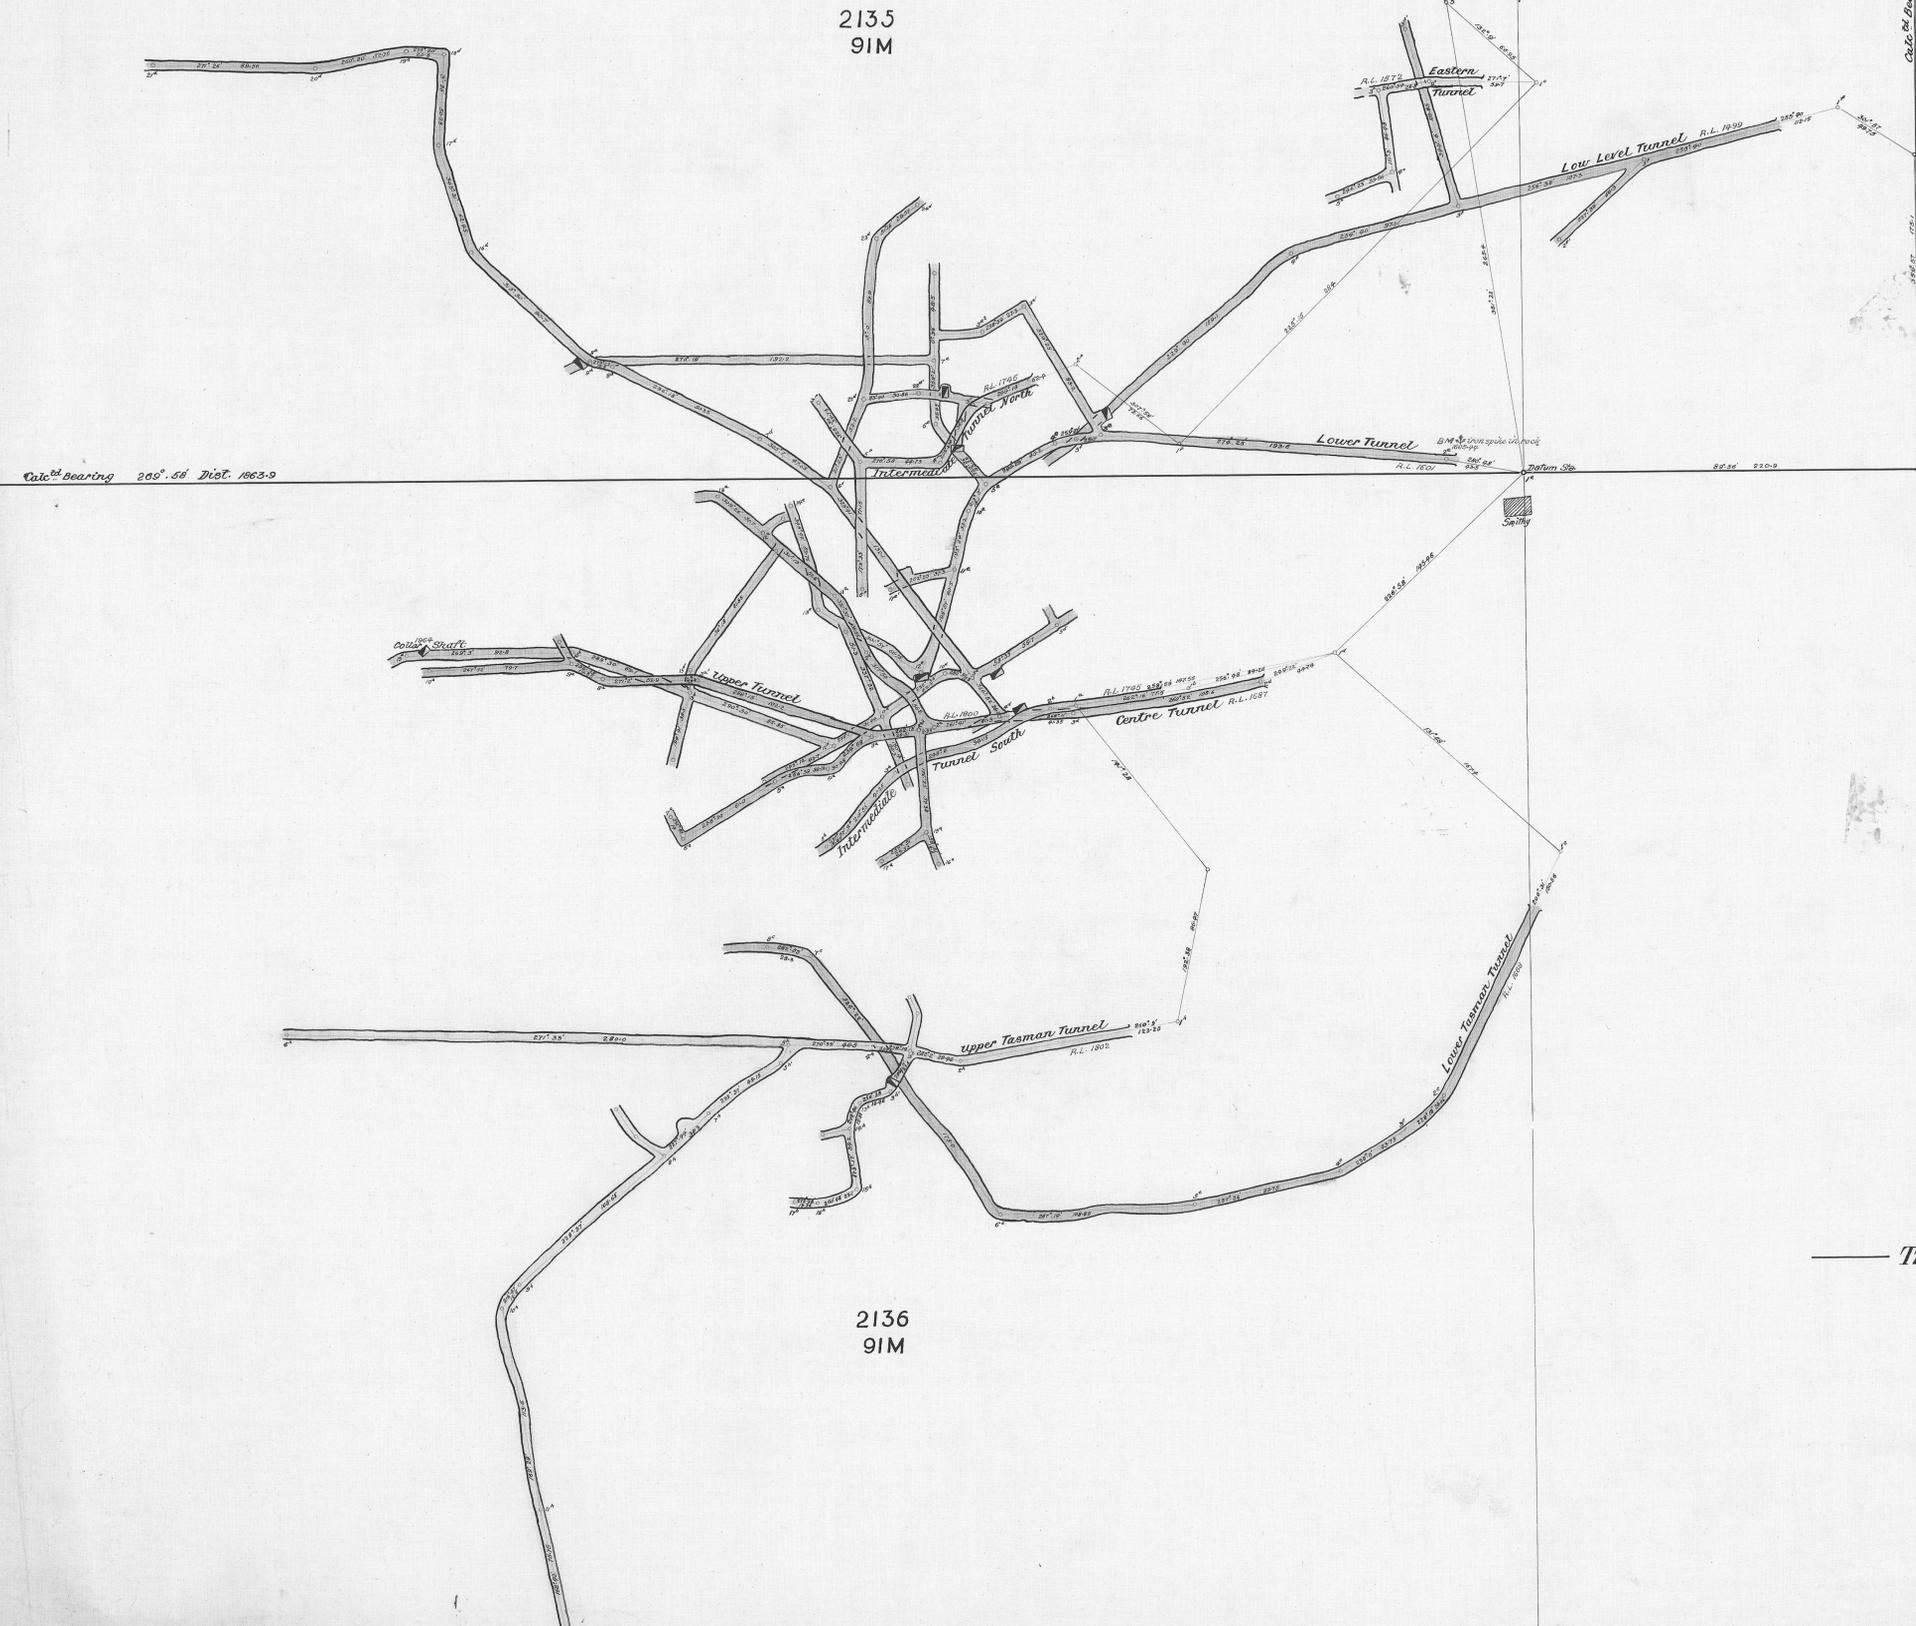

2135
91M

2136
91M

Tasman & Crown Lyell Extended Coy. No. 114.

The Mount Lyell Comstock Copper Coy. Ltd.

— UNDERGROUND PLAN —

— Scale 40' = 1" —

— Instrument used 3 Transit —
— Measurements in Feet —

— Brought up to date May 20th 1908

Supd. J. H. ...
24/5/08

Handwritten notes and signatures in the bottom right corner.