


140-06

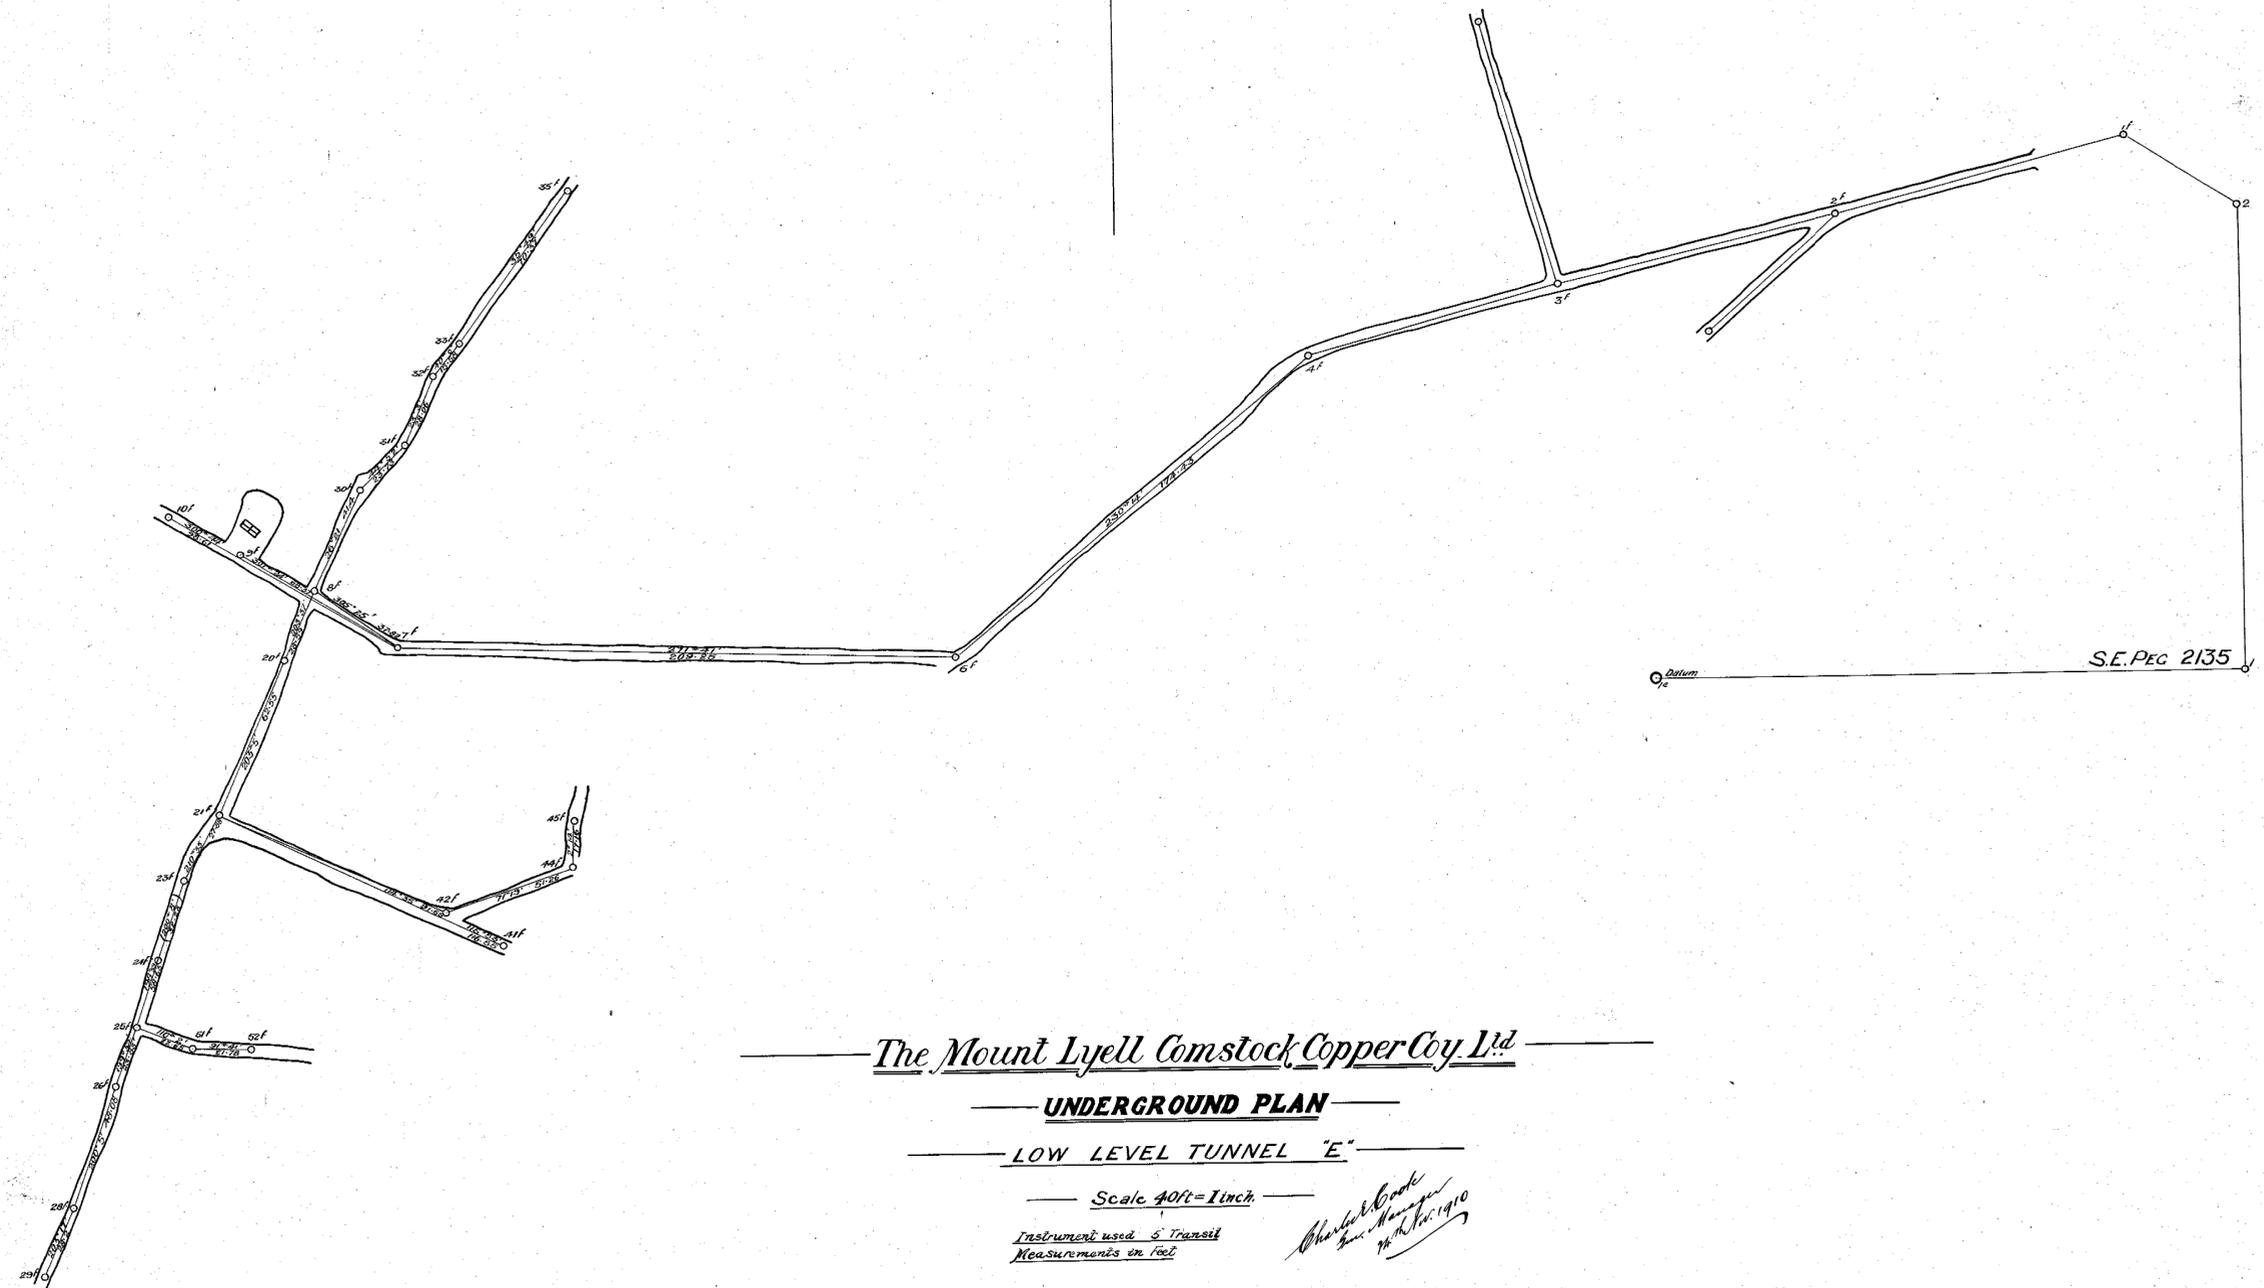

The Mount Lyell Comstock Copper Coy Ltd

UNDERGROUND PLAN

LOW LEVEL TUNNEL "E"

Scale 40ft = 1 inch

Instrument used 5" Transit
Measurements in feet

*Charles Cook
Supt. Mount Lyell
26th Dec 1910*

*Mount Lyell Comstock
Copper Coy Ltd
S.E. Peg 2135*

*105
S.E. Peg 2135*