

Lyell Comstock Consolidated Mine

Underground Extensions for 1903

Scale 20 feet to an Inch

Surveyed with Six Inch Transit Theodolite





J. J. Muir

Authorized Surveyor



J. J. Muir 536/M.

Lyell Comstock Consolidated Copper Co 2136/91M

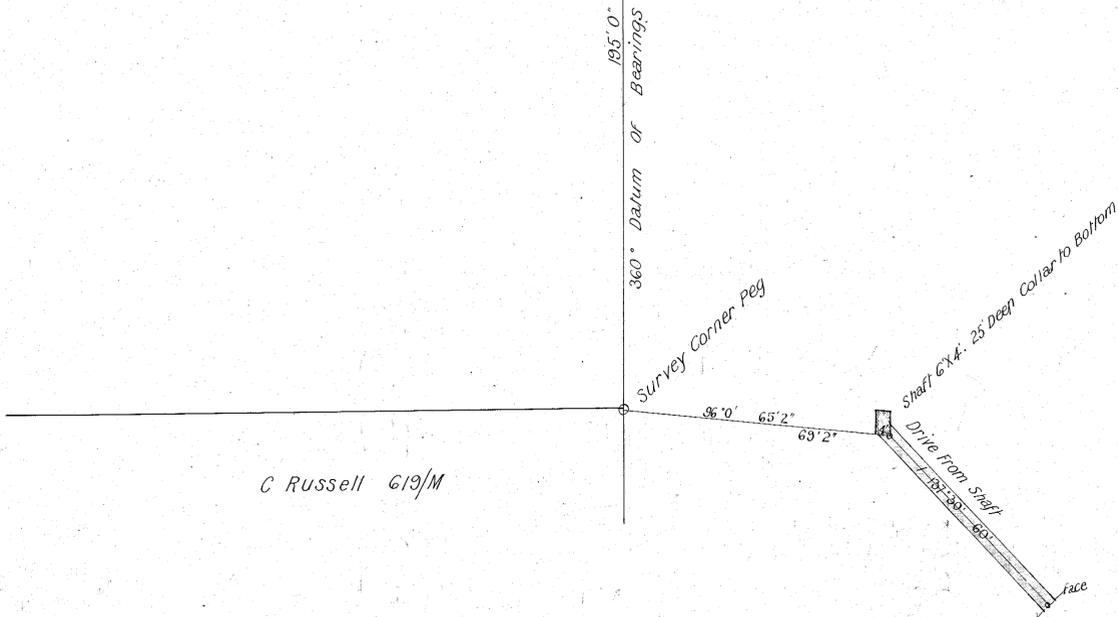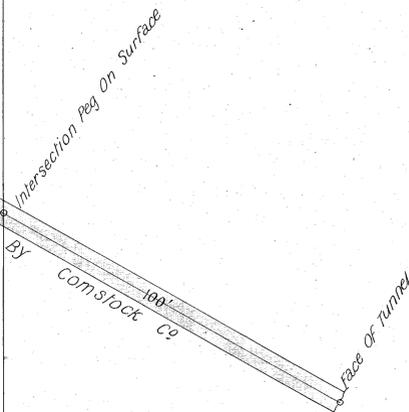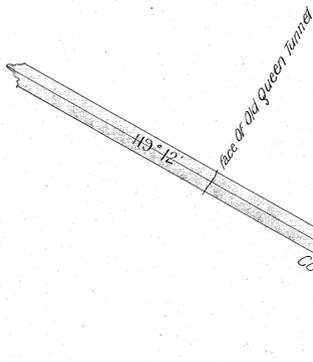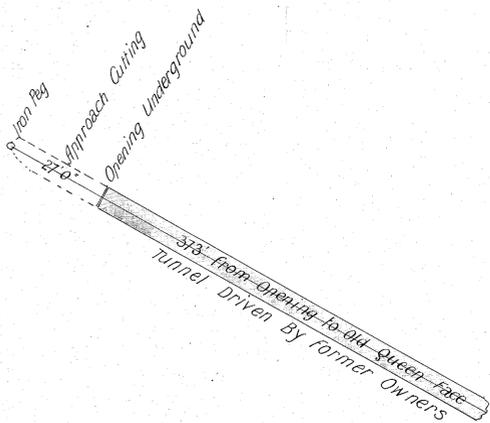

C Russell 619/M

