

10


140-09
7881 with
J. Muir

M^r Lyell Comstock M^r Coy
Underground Survey for 1896
Scale 25F^t to an Inch

Official



I certify this Plan correct
J. Muir
Authorized Surveyor
Lyell Jan^y 1897.

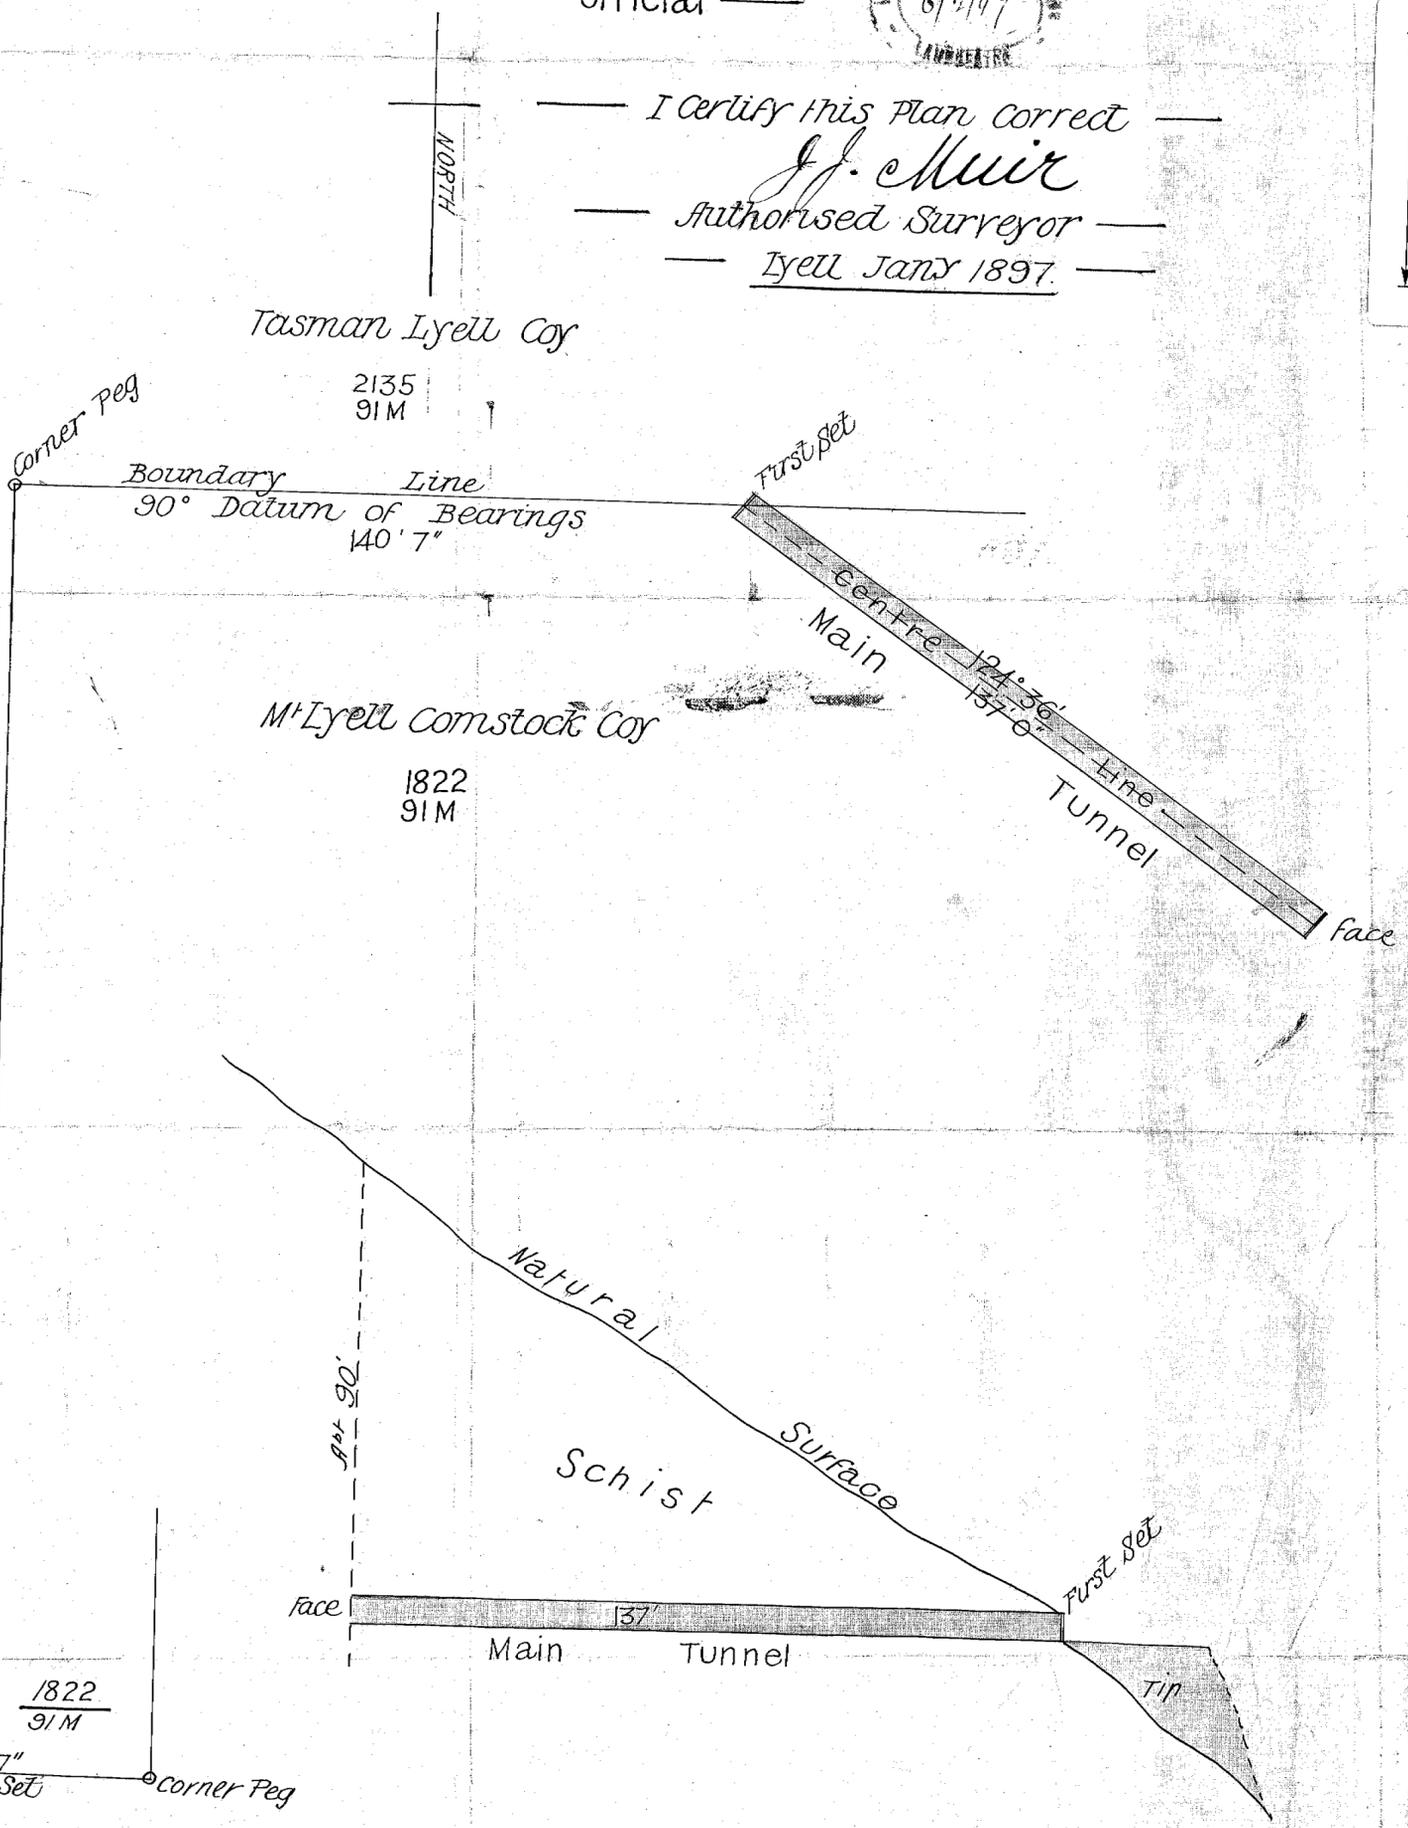

Tasman Lyell Coy

2135
91M

Boundary Line
90° Datum of Bearings
140' 7"

First Set

Centre Line
Main Tunnel

M^r Lyell Comstock Coy

1822
91M

Face

Face
(137)

Centre Line
Tunnel

Natural
Schist
Surface

Face

Main Tunnel

First Set

TIP

1822
91M

90° Datum
124' 36"
From Centre of First Set

Corner Peg

Field Notes

140-09