

140-10



140-10


*Mr. J. J. Sullivan  
106  
12  
13*

# — MT LYELL COMSTOCK M<sup>C</sup> CO —

## — Underground Survey 1898 —

— Scale 25 Feet to an Inch —

*J. J. Sullivan  
Asst. Surveyor  
Feb. 99*

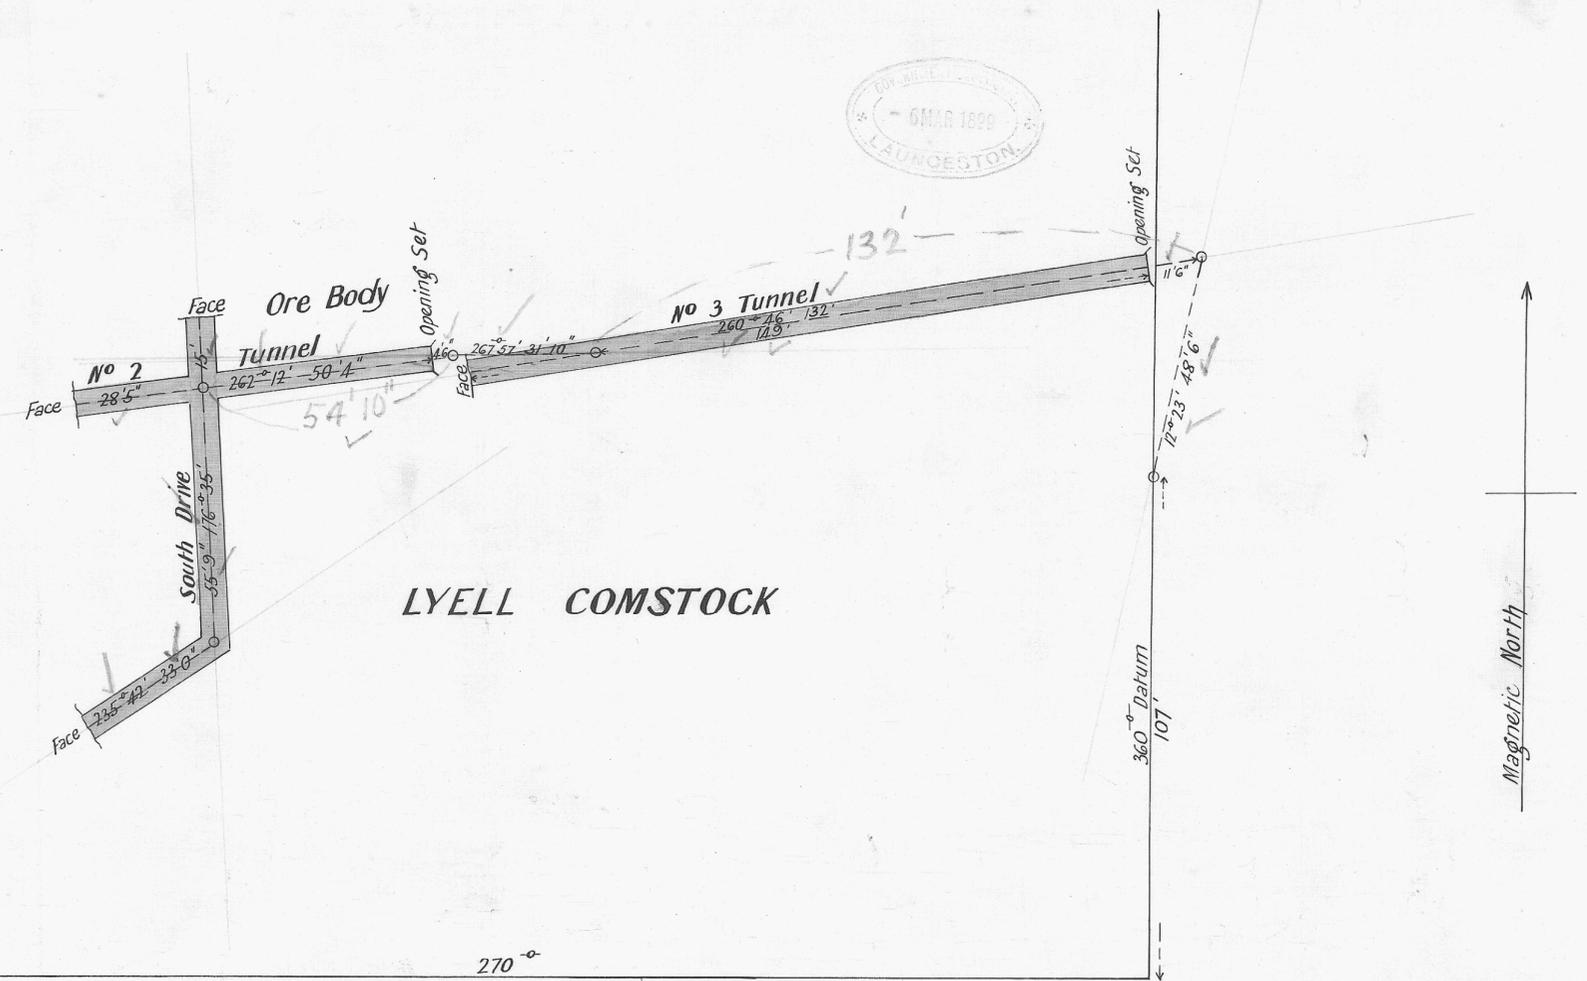

LYELL COMSTOCK

TASMAN LYELL