

M^r LYELL COMSTOCK MINING CO

Underground Survey to end of January 1900

20 Feet to an Inch

J. J. Ellis
Aukhausen Surveyor
Jan. 1900.


199
20
179

29° 30'
159' 10"
200 160' 11"


This not in notes

119.4"
scale 118'
107-10
11-56
119.04

scale 46'

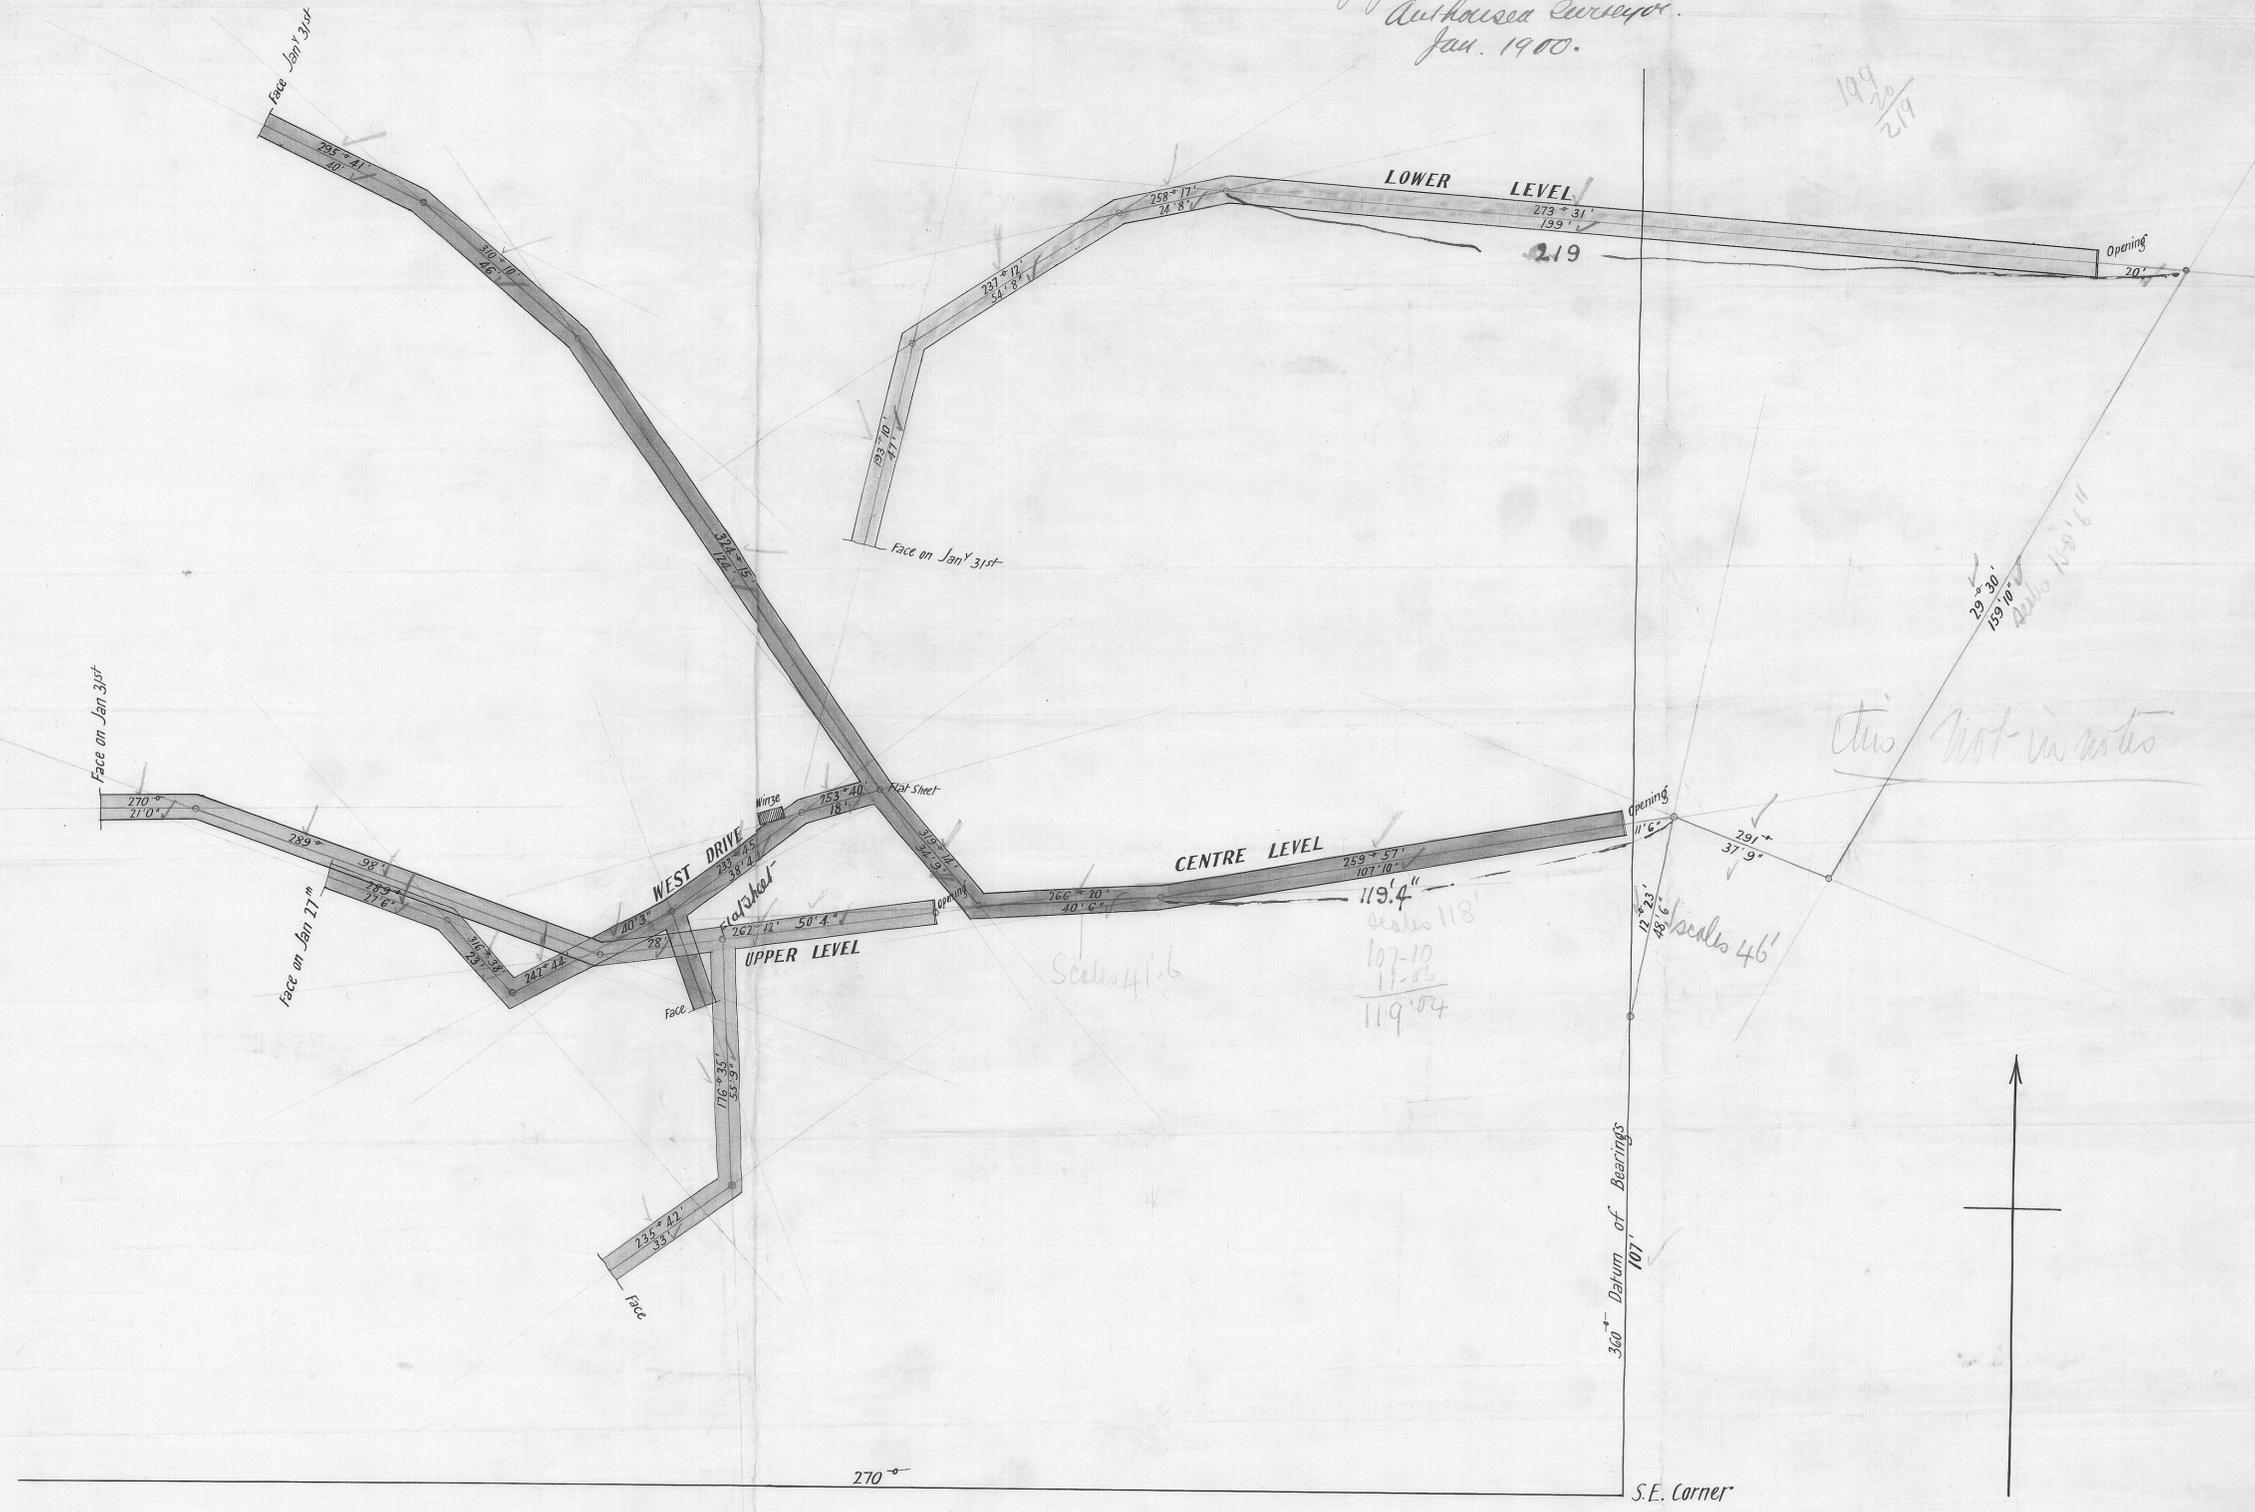

TASMAN CO

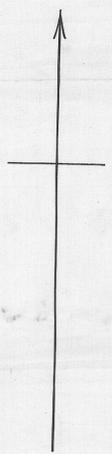

360° Datum of Bearings
107'

S.E. Corner

270°