


14076

140-16

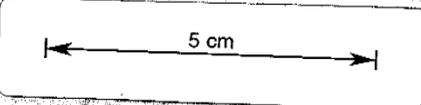

# The Mount Lyell Comstock Copper Coy. Ltd.

## PORTION OF UNDERGROUND PLAN


Showing Work from May 20<sup>th</sup> 1908 to Dec. 31<sup>st</sup> 1908  
Scale 40' = 1"



Instrument used 5' Transit  
Measurements in Feet

*Charles Clarke*

2574-40  
230-09  
24.31

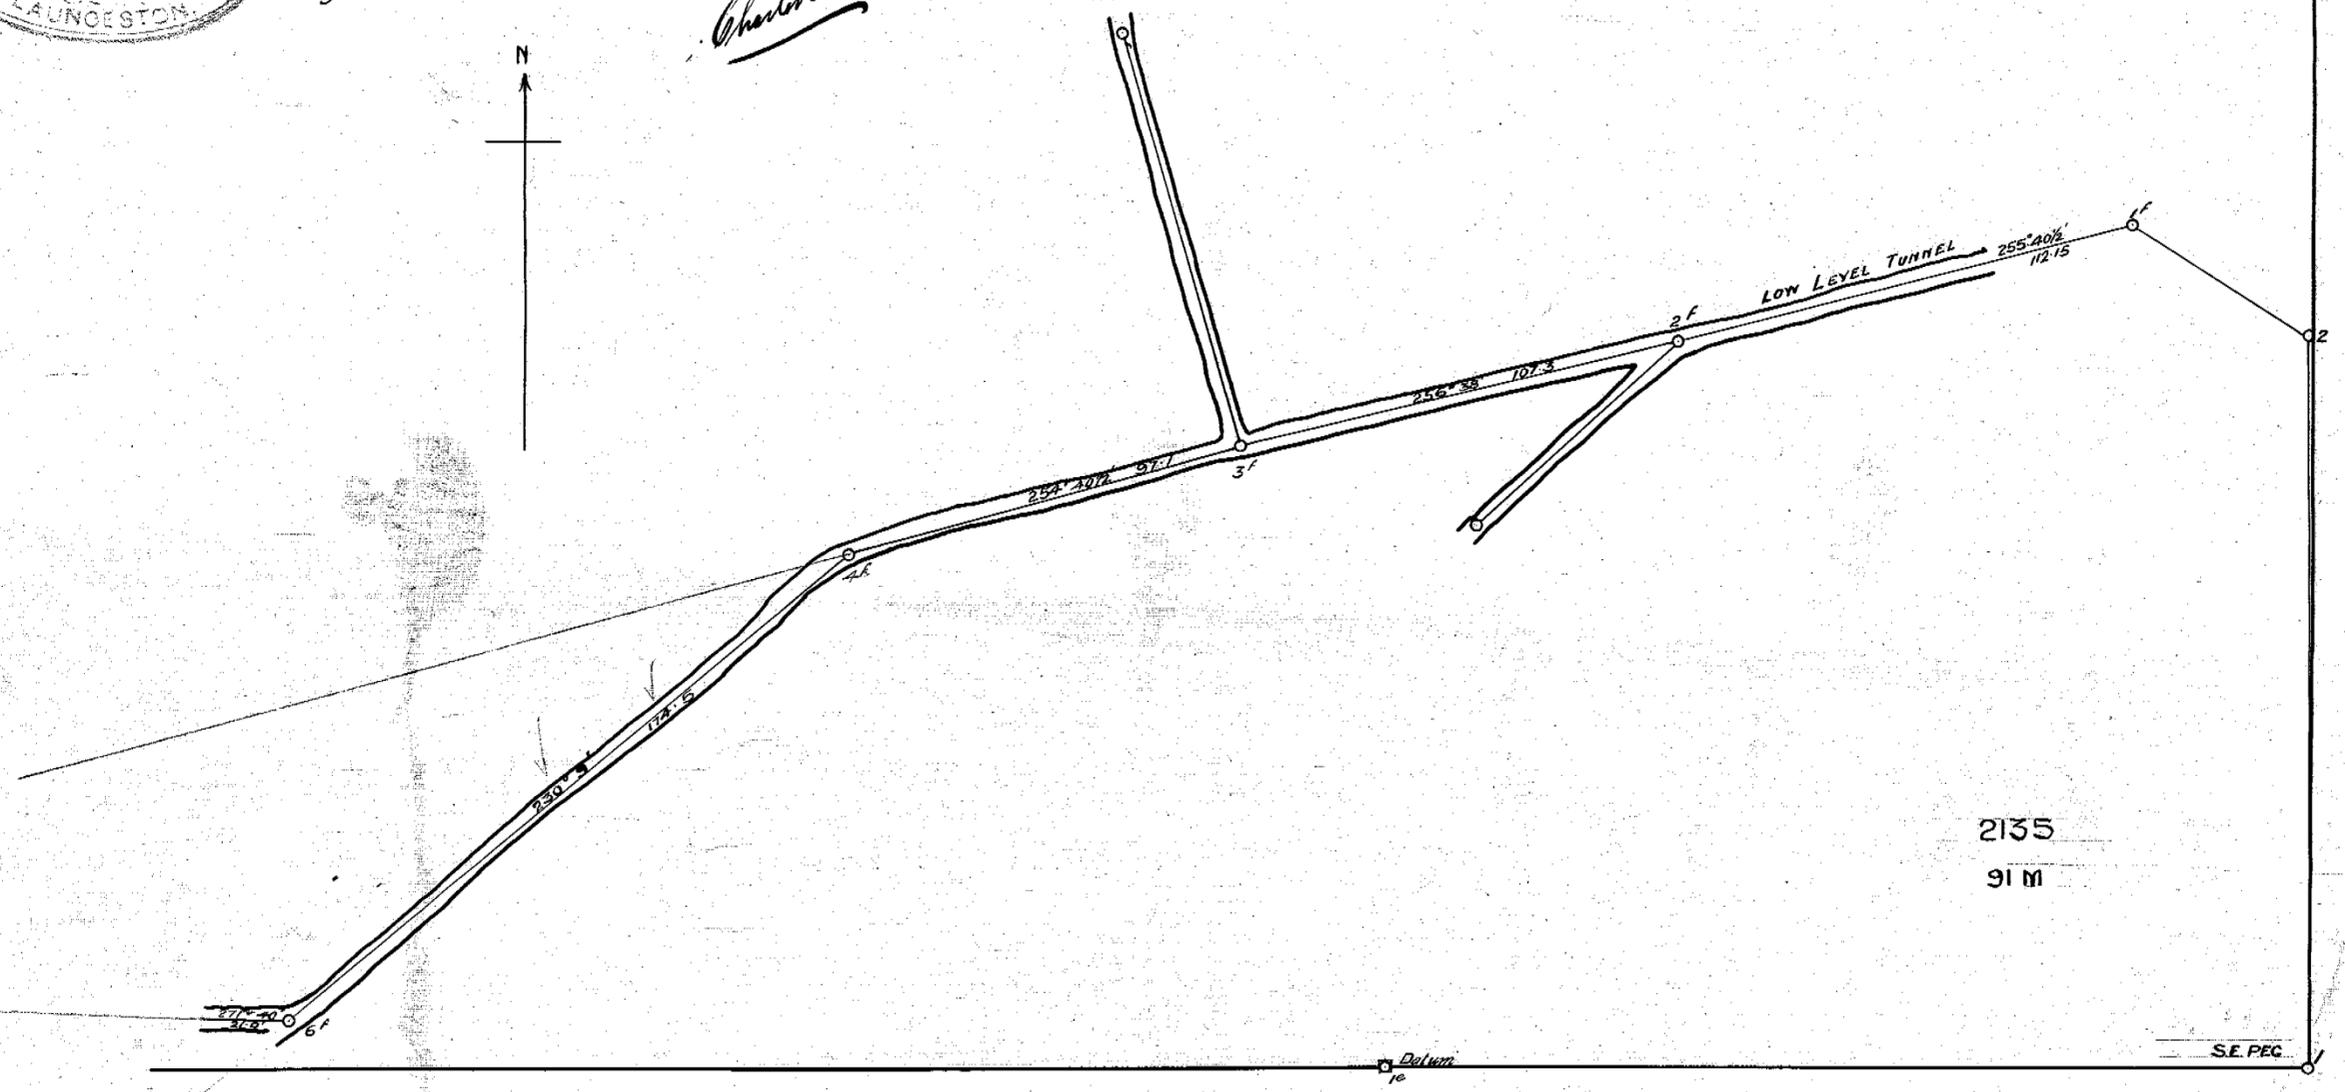

*right shown West of  
2135 of 91 m*