
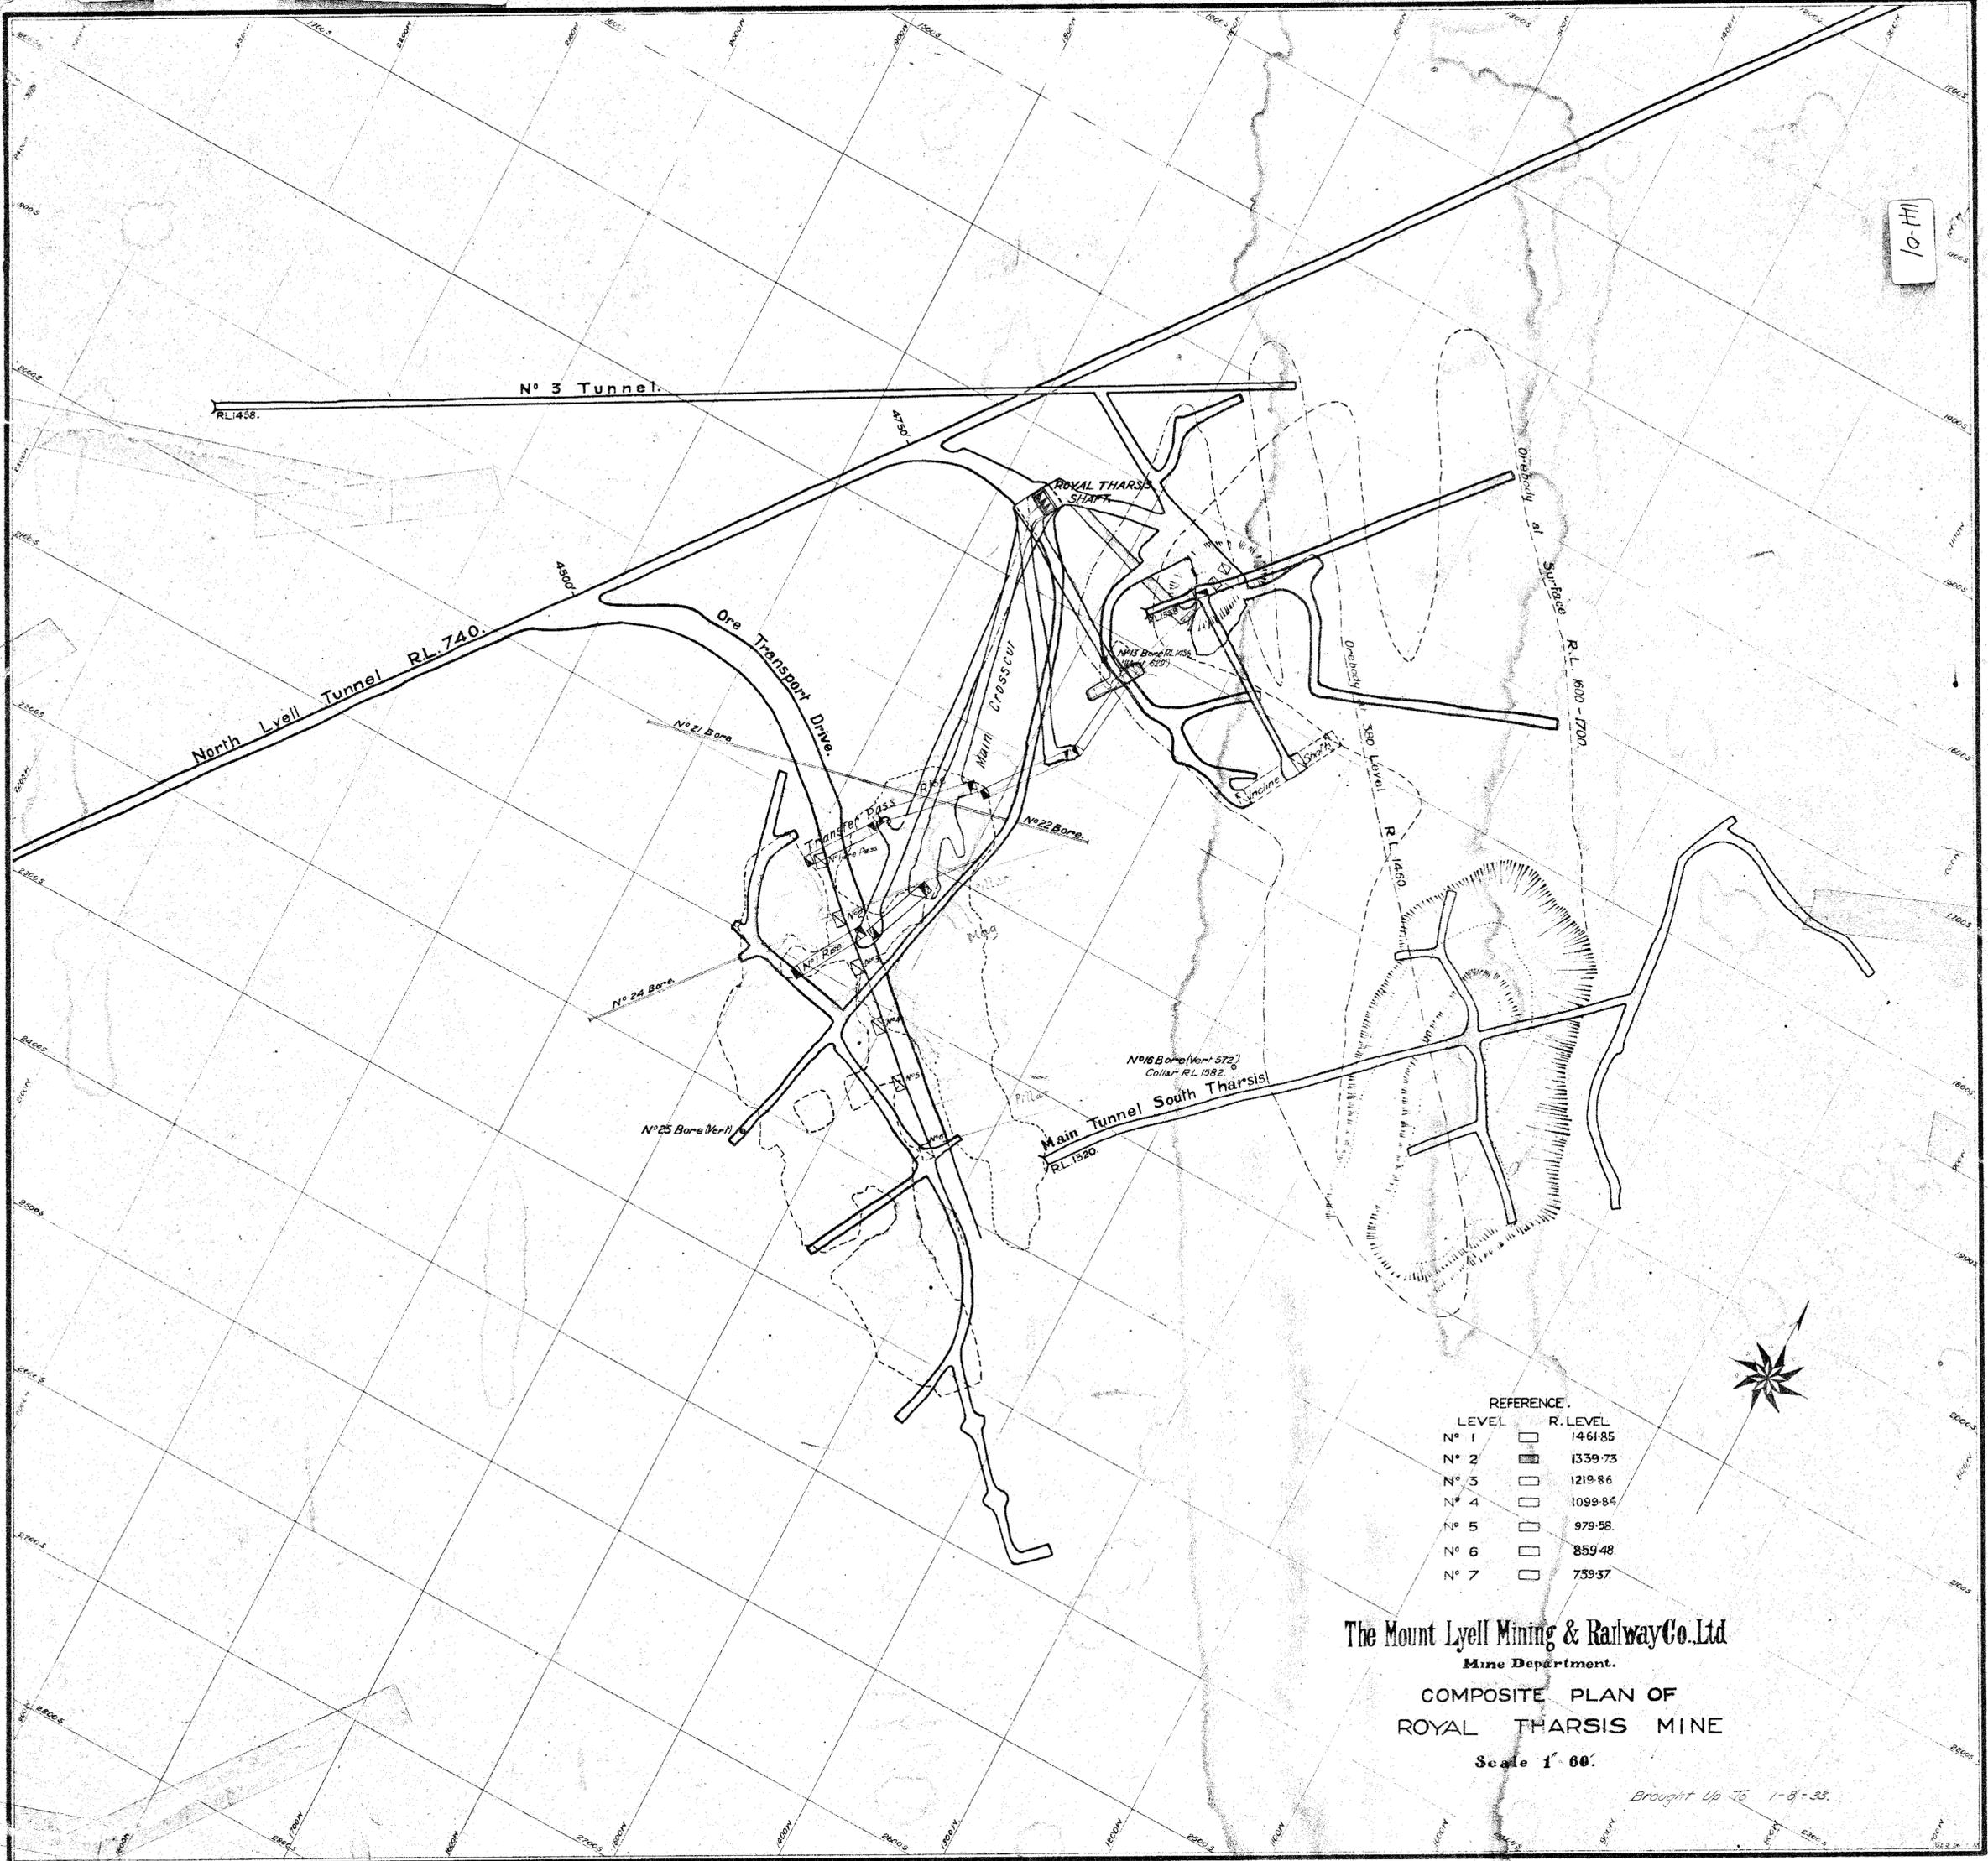


141-01

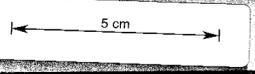

REFERENCE.

LEVEL	R. LEVEL
N° 1	1461.85
N° 2	1339.73
N° 3	1219.86
N° 4	1099.84
N° 5	979.58
N° 6	859.48
N° 7	739.37

The Mount Lyell Mining & Railway Co. Ltd  
 Mine Department.

COMPOSITE PLAN OF  
 ROYAL THARSIS MINE

Scale 1" = 60'

Brought Up To 1-8-33.