


144-03

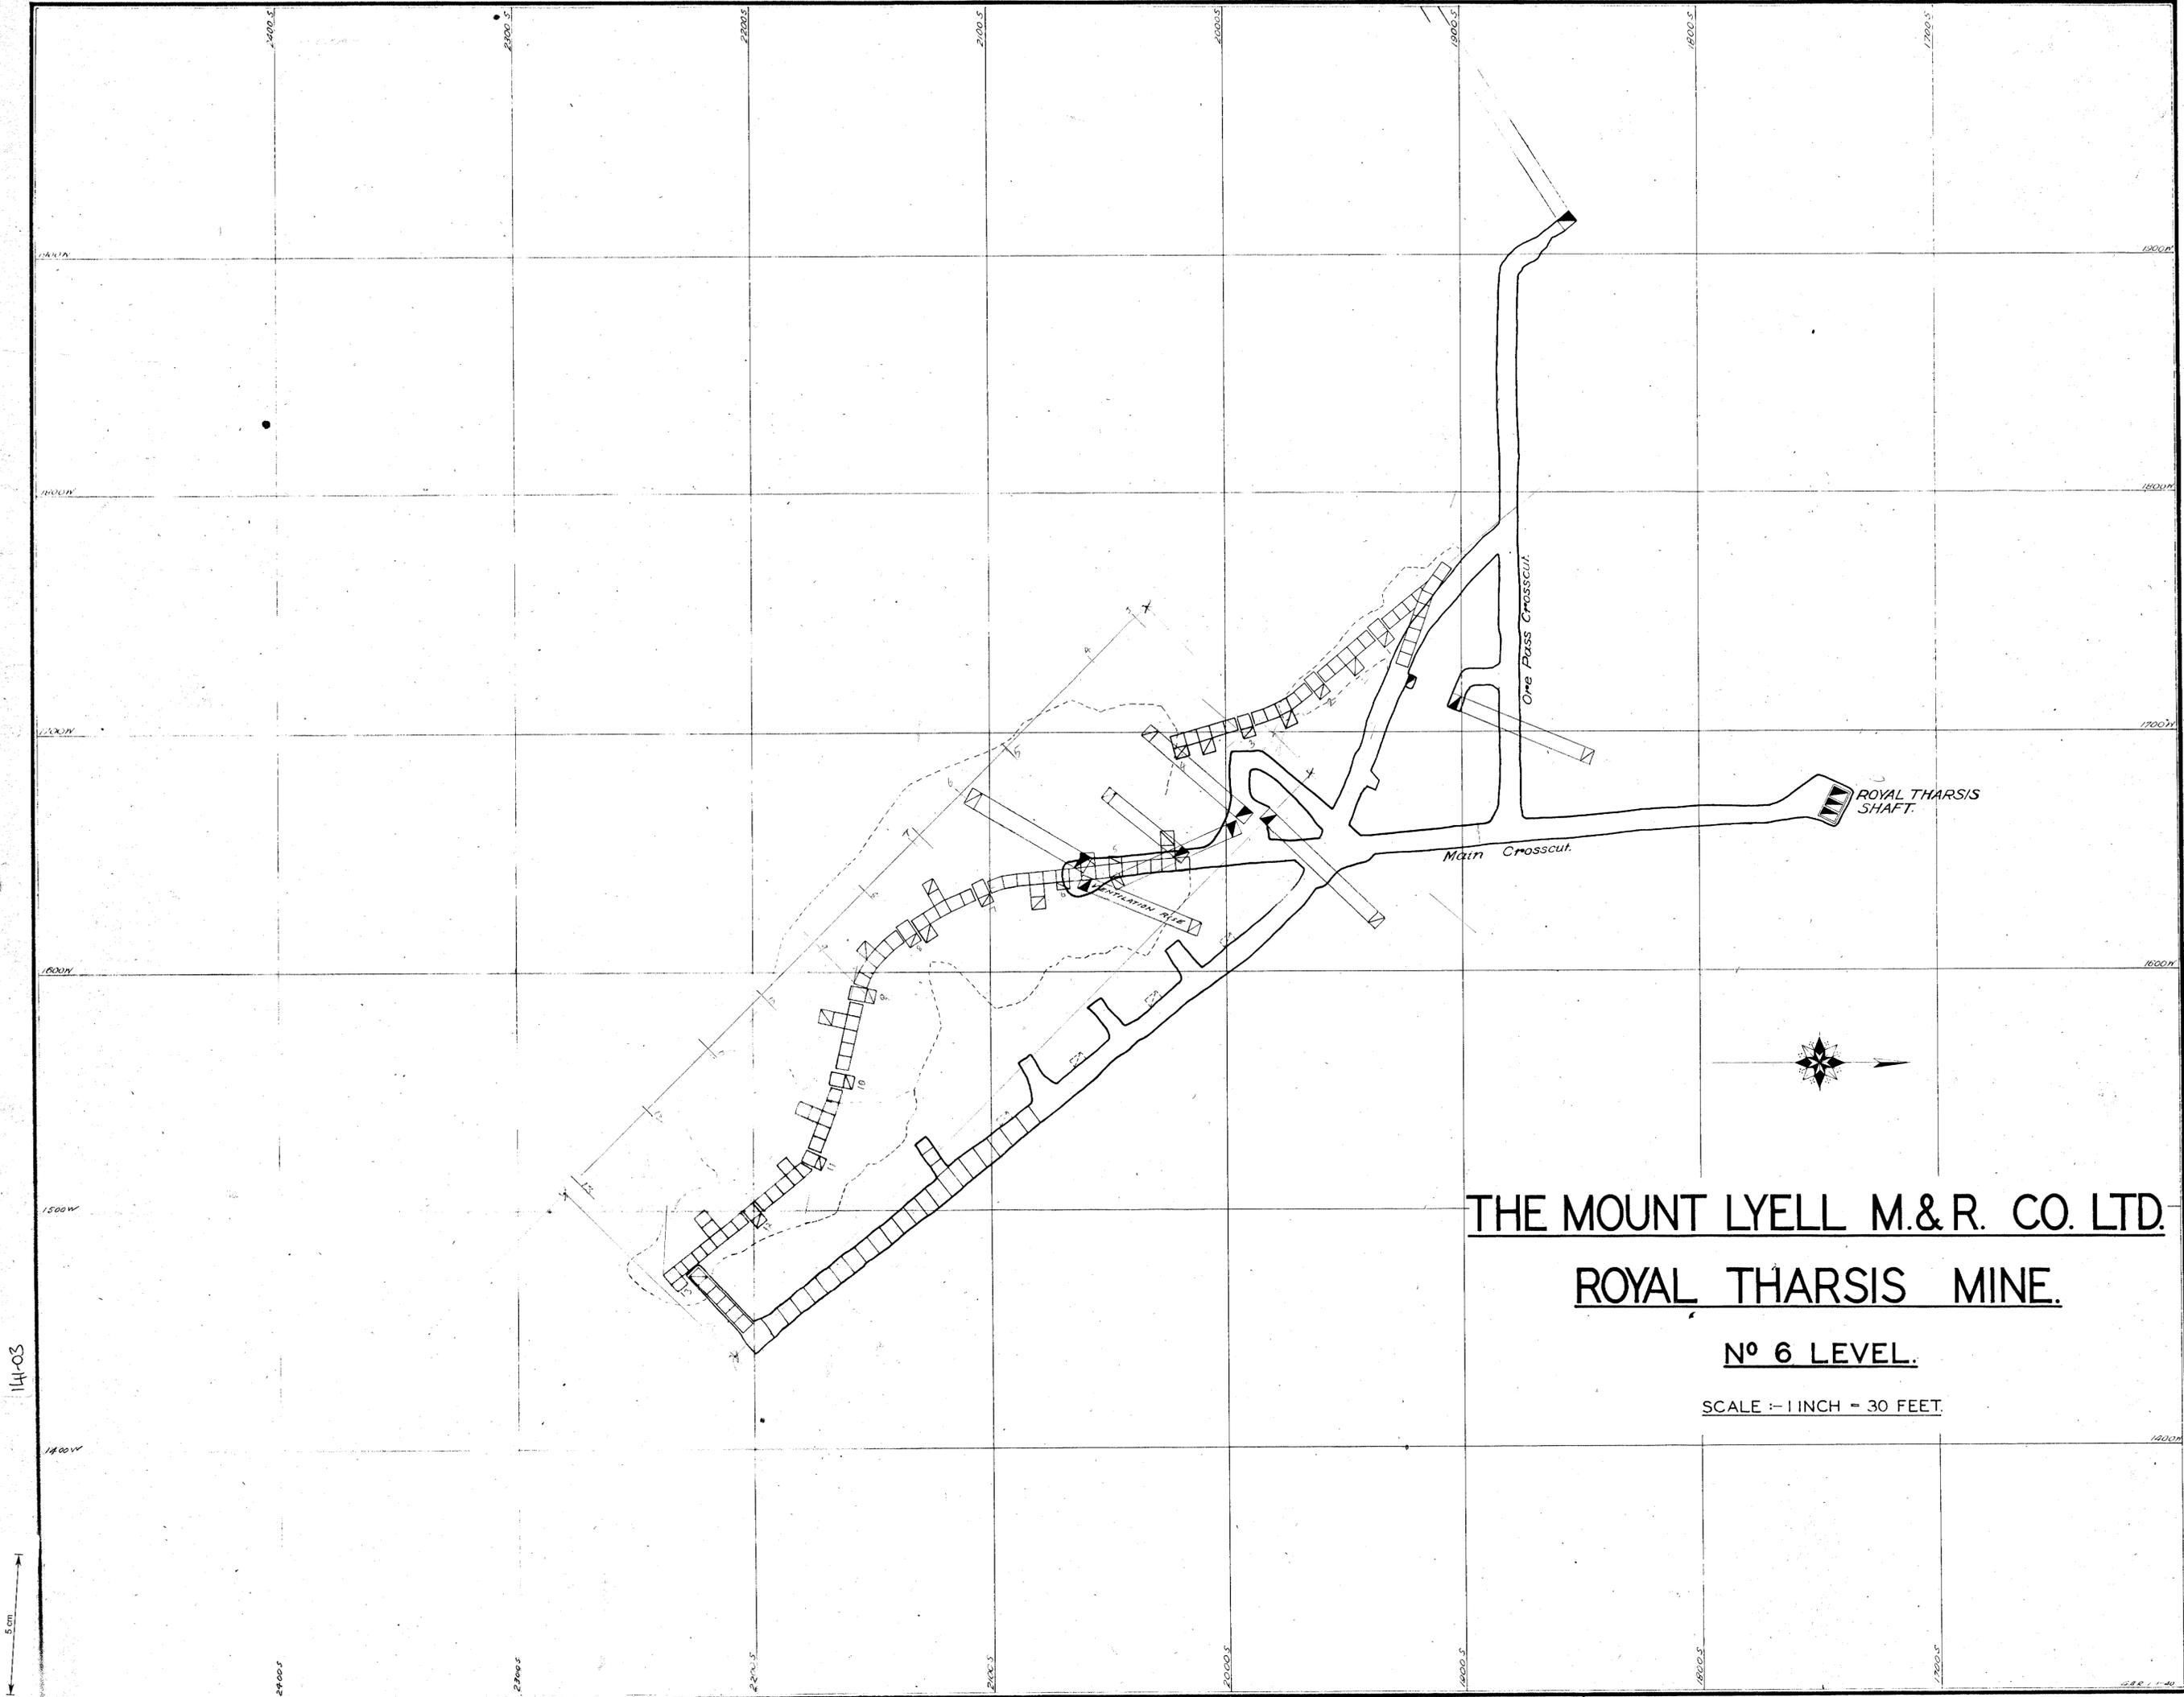

THE MOUNT LYELL M.&R. CO. LTD.

ROYAL THARSIS MINE.

No 6 LEVEL.

SCALE :- 1 INCH = 30 FEET.

144-03

5 cm