


141-07

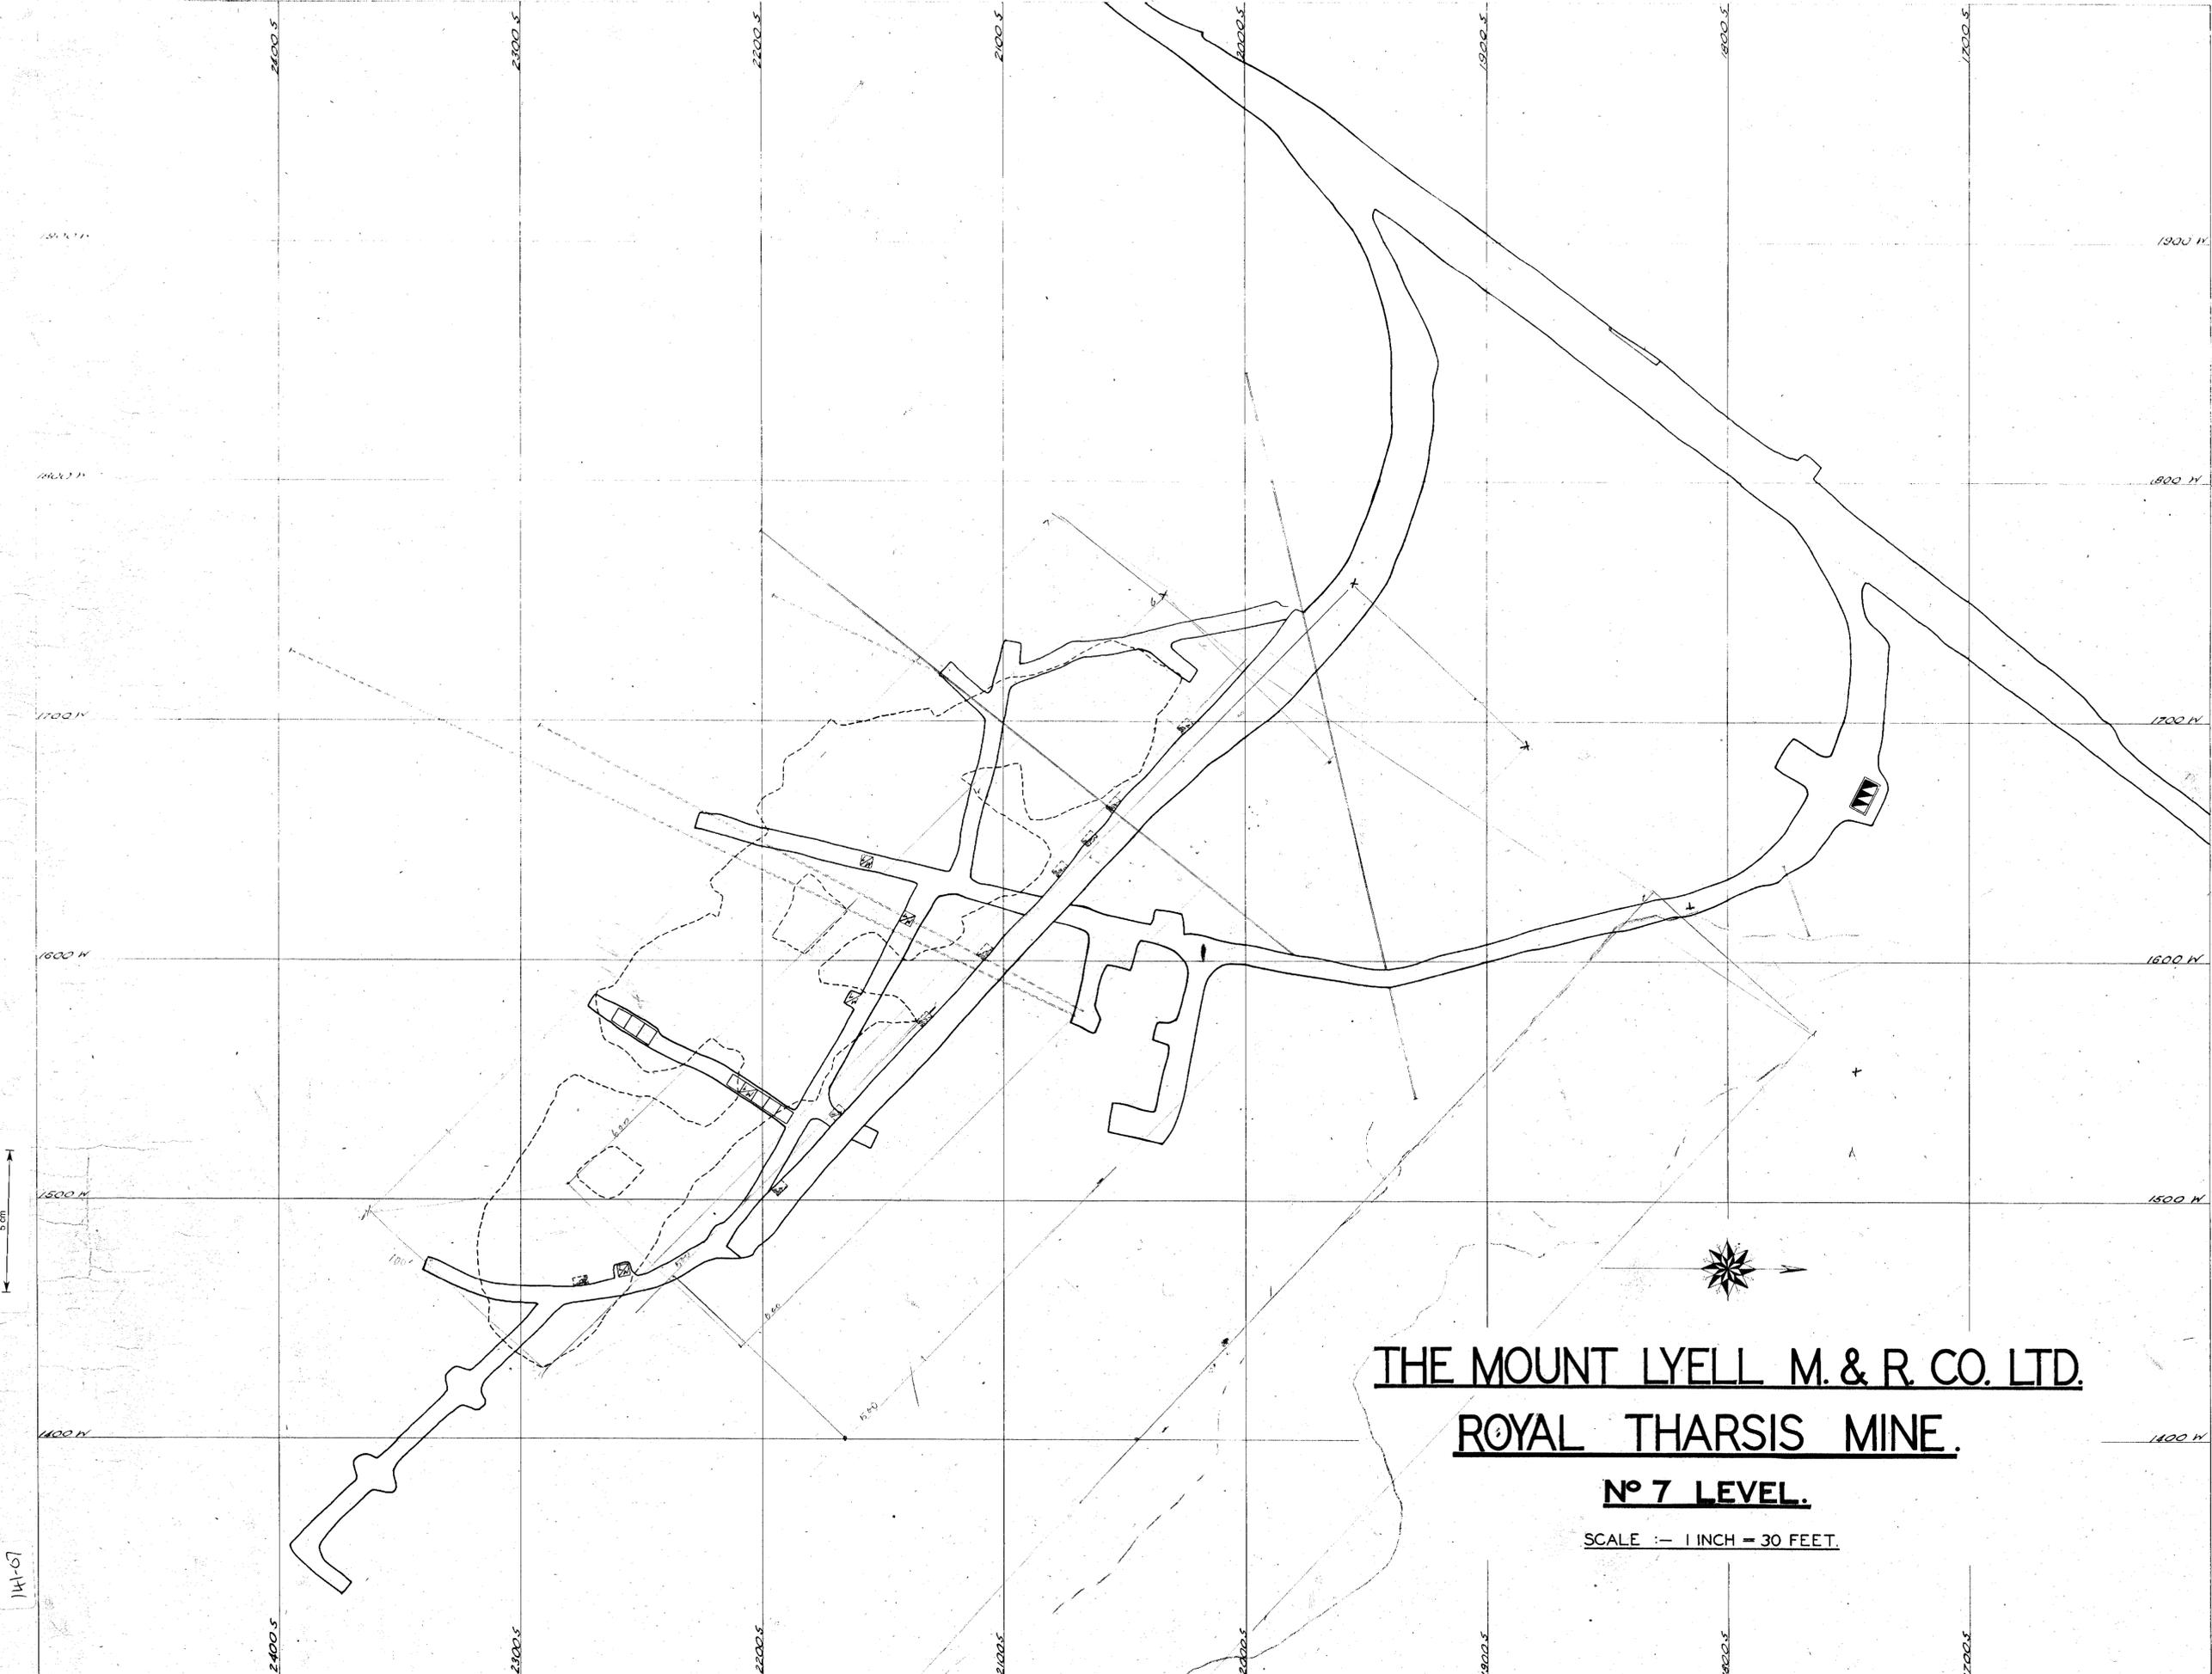

THE MOUNT LYELL M. & R. CO. LTD.

ROYAL THARSIS MINE.

Nº 7 LEVEL.

SCALE :— 1 INCH = 30 FEET.

141-07