


141-08

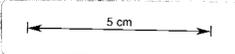

UNDERGROUND WORKINGS 1900

(Extension 12 Feb 1901)

ROYAL THARSIS MINING CO N.L.


SCALE OF FEET



*Survey made with theodolite & steel band chain
John Power
Arthur Symonds
18th Feb 1901*


R.L. 132.00 N° 2 Tunnel

R.L. 0'00 N° 3 Tunnel

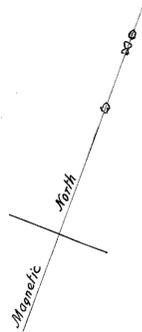

ROYAL THARSIS M. CO N. L.

935 93 M.

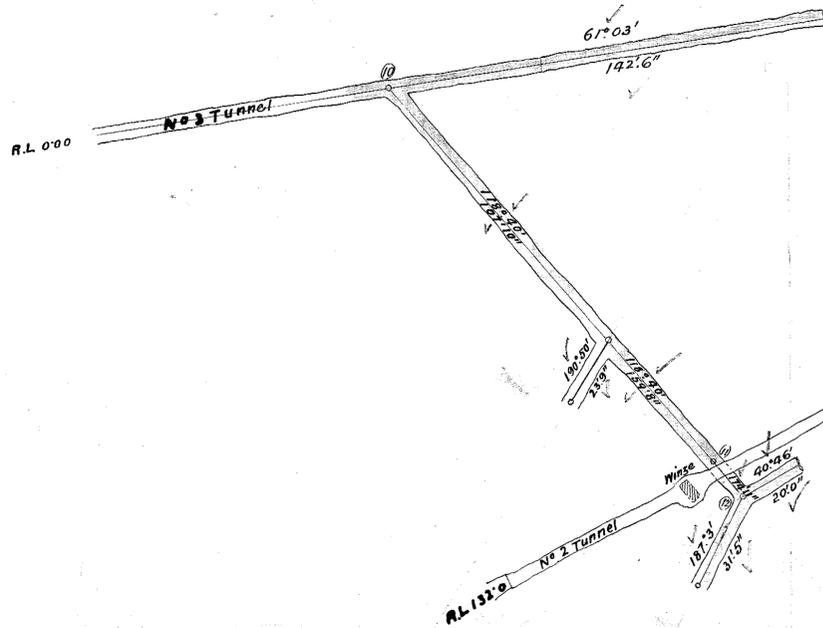

LYELL THARSIS M. CO. N. L.

2105 91 M.

132.0' N° 2 Tunnel

N° 3 Tunnel R.L. 0'00



SOUTH THARSIS M. CO N. L.

1805 91 M

*Great depth for work
1001 ft of
1901*

25