


UNDERGROUND WORKINGS 1899

ROYAL THARSIS MINING CO N.L.

SCALE OF FEET 

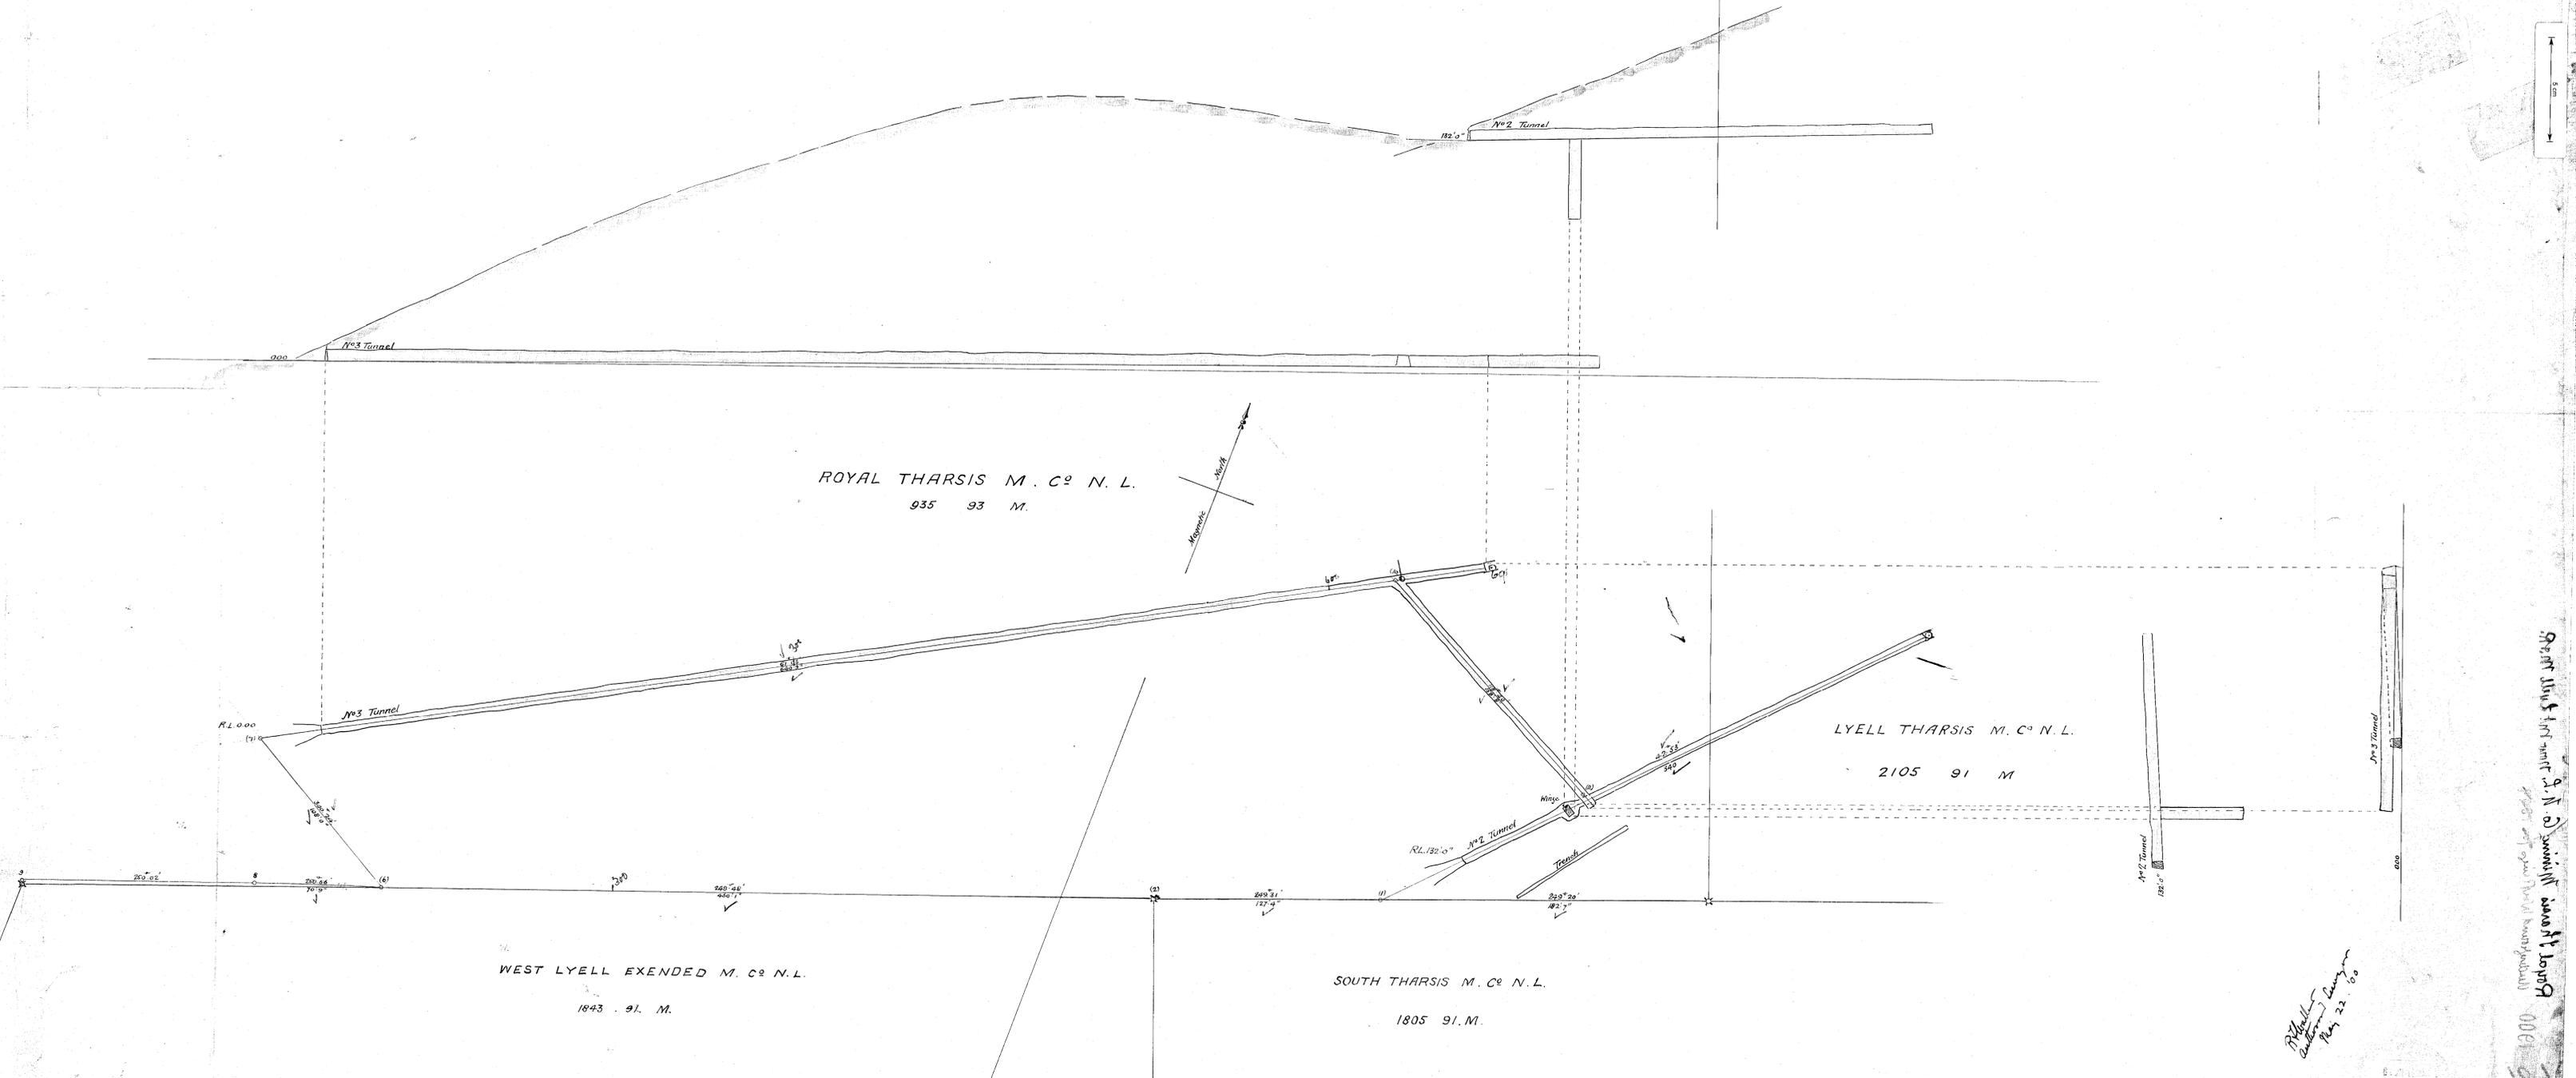

Handwritten note:
R. Lyell
1899
May 22 1899

Vertical handwritten note:
Report of the Survey of the
Underground Workings of the
Royal Tharsis Mining Co. N.L.
1899

60-171