


142-01

5 cm

33

103

The Lyell Tharsis Mining Co No Liability
Underground Survey 1900
Scale 20ft to 1 in.

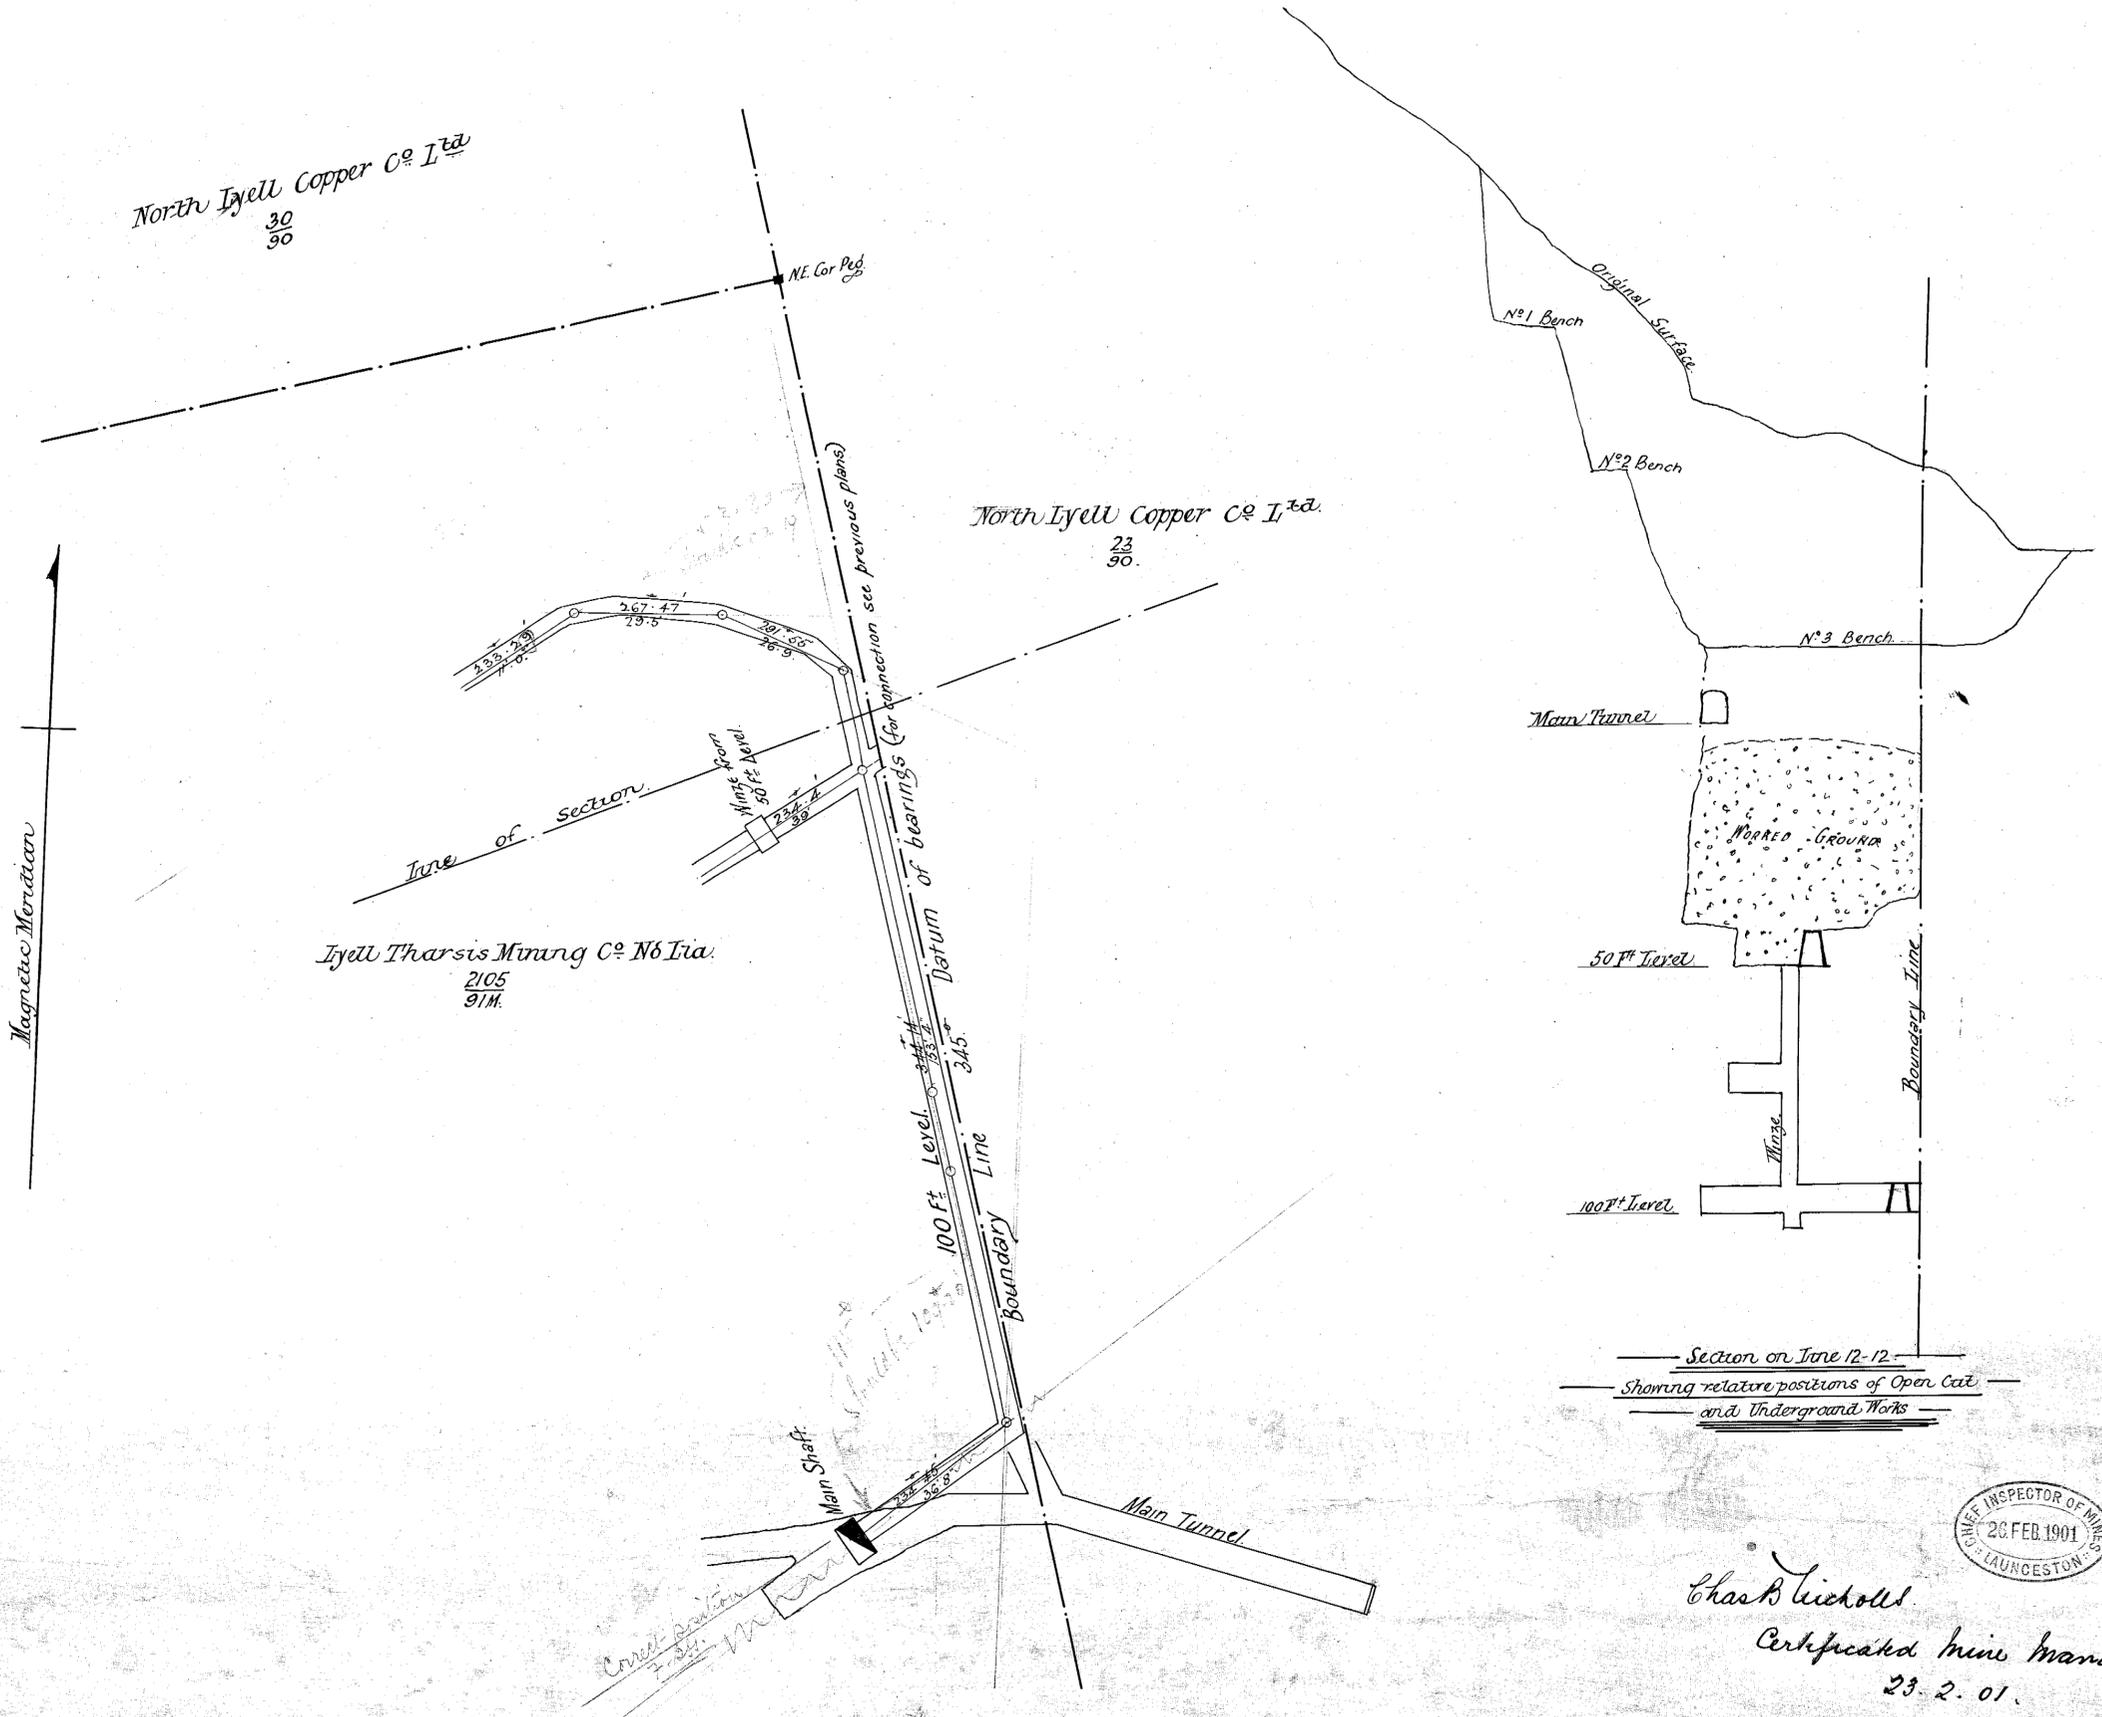

Magnetic Meridian

North Lyell Copper Co Ltd
30/30

North Lyell Copper Co Ltd
23/30

Lyell Tharsis Mining Co Ltd
2105
91M.

Section on June 12-12
 Showing relative positions of Open Cut
 and Underground Works



Chas. Nicholls
 Certificated Mine Manager
 23. 2. 01.

for 1001
 20/1/1901

Correct position
 2. 2. 01