

5 cm 142-03

... 0001 ...

# LYELL THARSIS M<sup>NG</sup> CO

Underground Survey 1899.

Scale 20ft to an Inch

Note. Dimensions relating to new work shown in blue

NORTH LYELL COY  
No 30/90

NORTH LYELL COY  
No 23/90


Magnetic Meridian

Natural Surface

Boundary Line

50<sup>th</sup> Level

Section on Line 12-12  
Showing relative positions of Open Cut  
and Underground Works  
Scale 20ft to an Inch

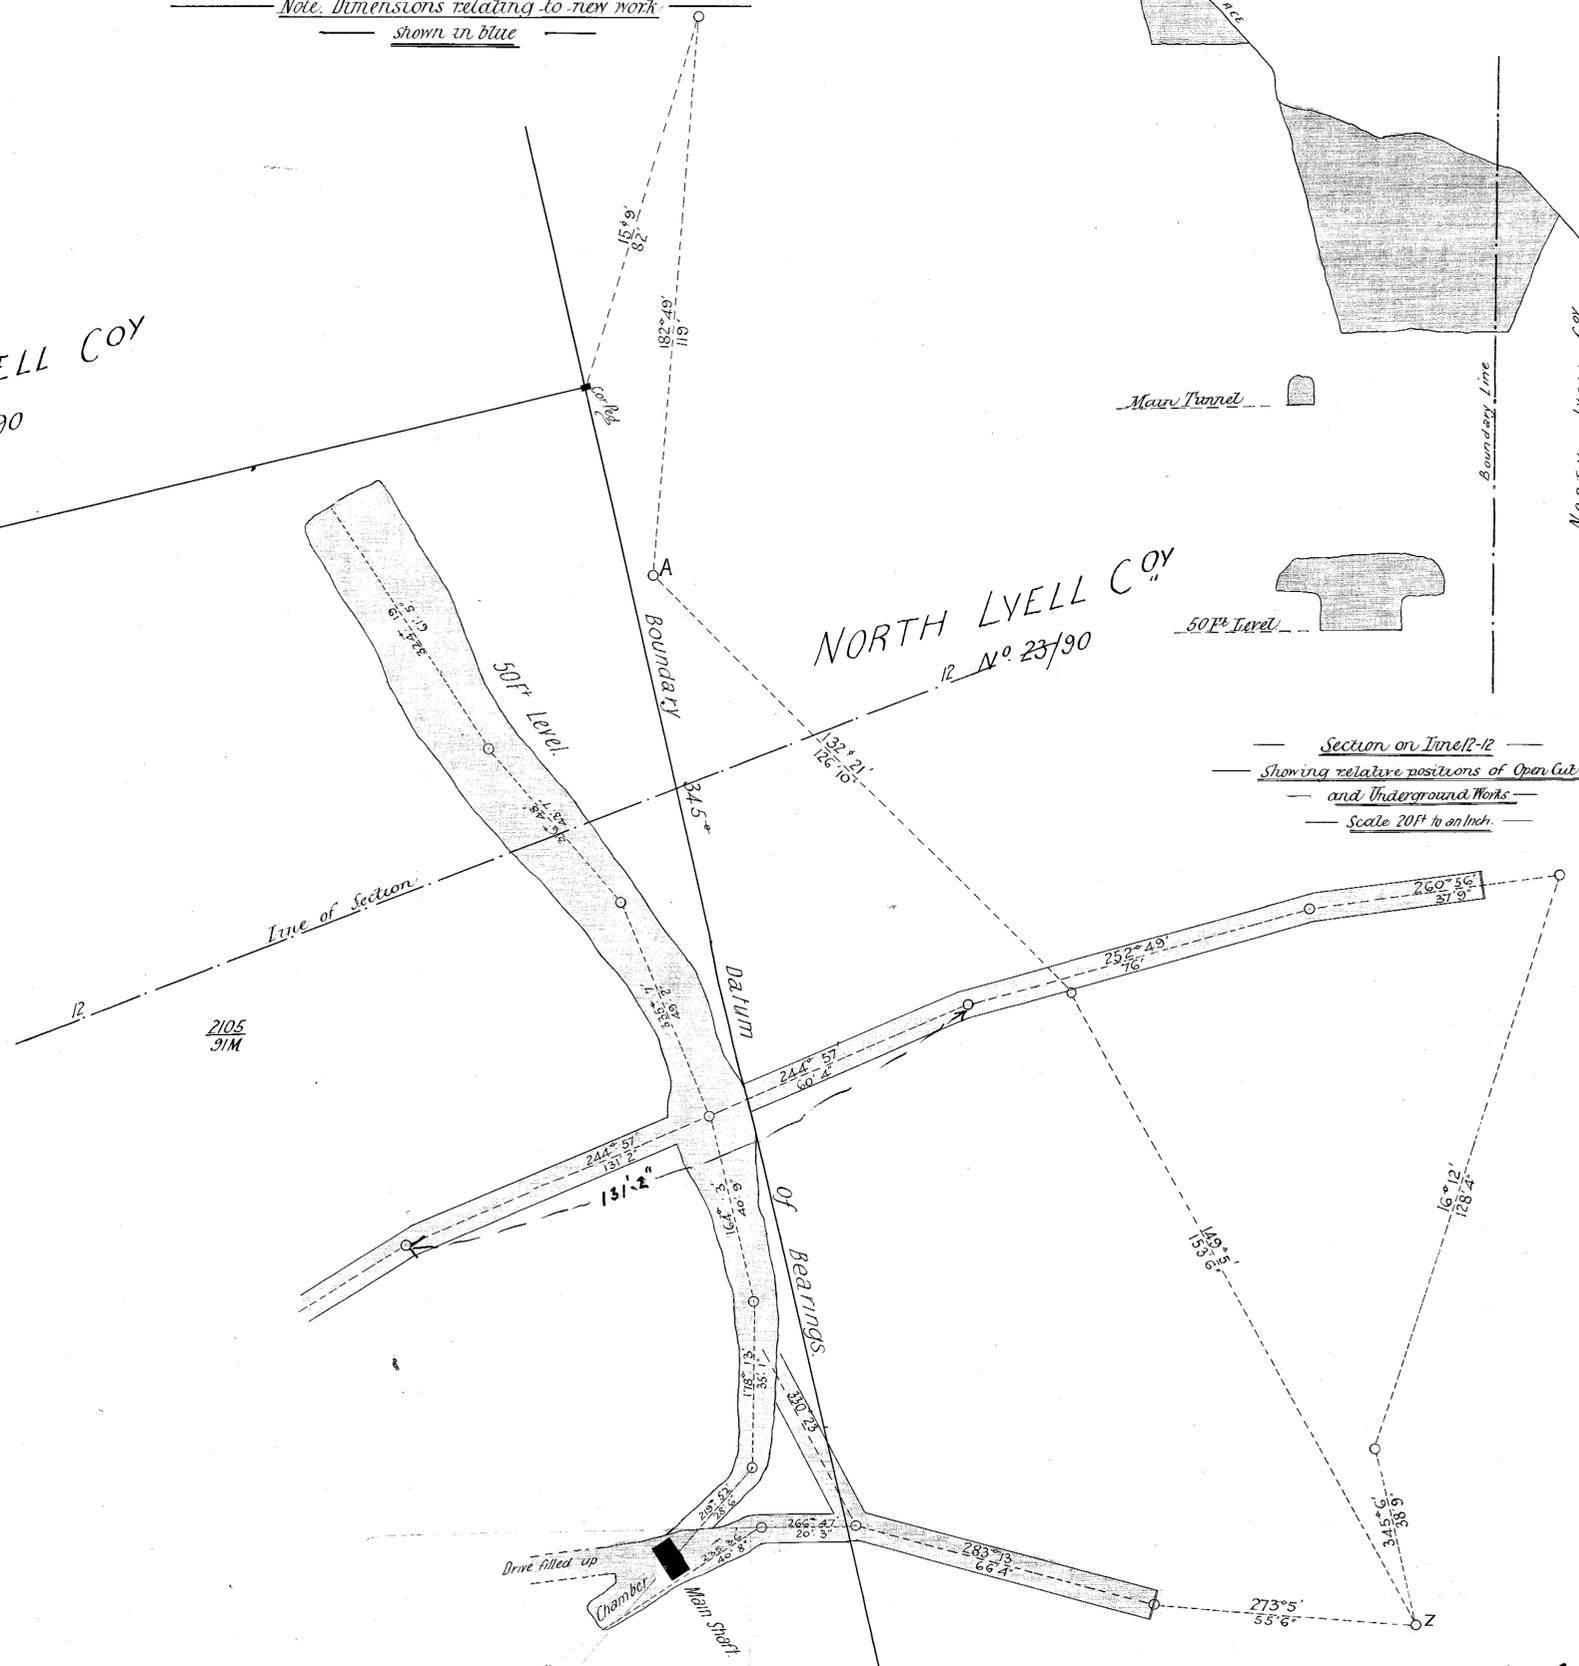

Chas. Nicholls  
Feb 14<sup>th</sup> 1900