

142

142-06

5 cm

142-06

ROYAL THARSIS M. CO. N. L.

935 - 93-M

249° 31' 127' 4"

(16) 249° 27' 30" 309' 11"

249° 20' 182' 7"

LYELL THARSIS M. CO. N. L.

2105 - 91 - M


1805 - 91 - M

UNDERGROUND WORKINGS

1899

SOUTH THARSIS M. CO.

SCALE - THIRTY FEET = ONE INCH

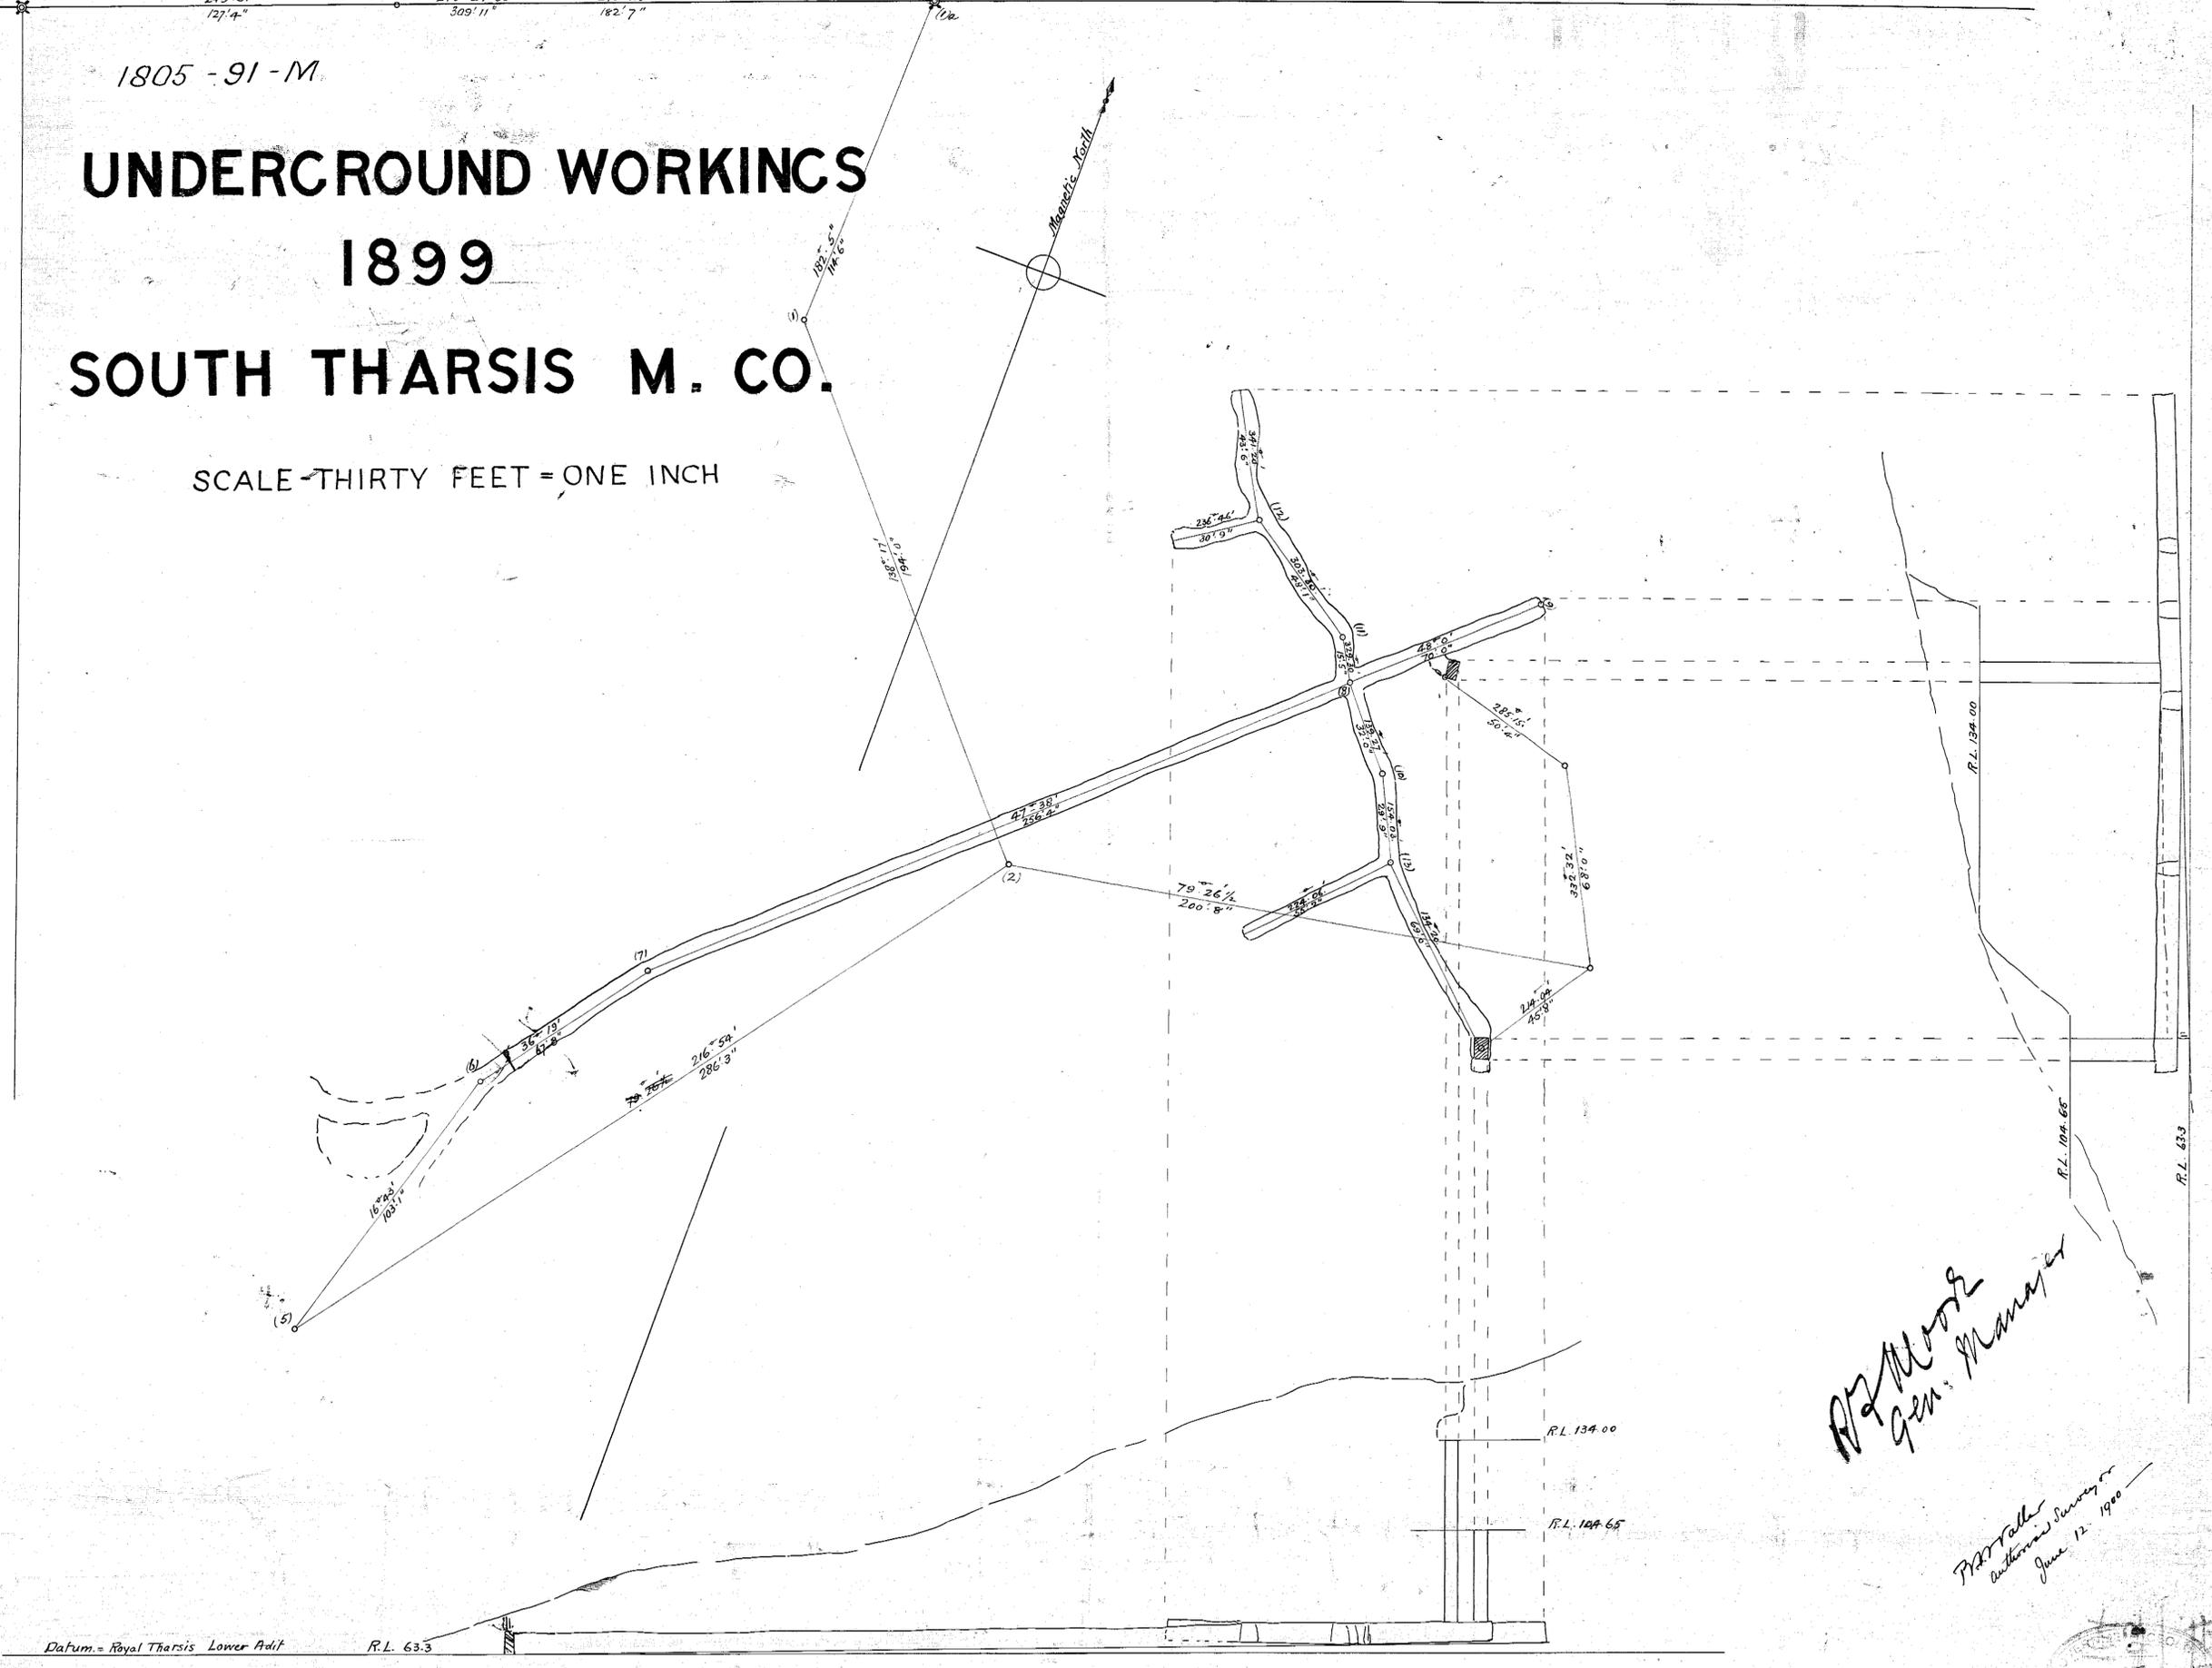

*AT Morse
Gen. Manager*

*P. H. Waller
Antonia Surveyor
June 12 1900*

Datum = Royal Tharsis Lower Adit

R.L. 63.3

R.L. 134.00

R.L. 104.65

R.L. 104.65

R.L. 63.3

*180 June 18 1900
Survey*

