


# —THE TASMAN LYELL COPPER CO. LTD.—

—Underground Survey for 1901—

—Scale—25 feet=1 inch—

Survey made with 5 inch Theodolite & steel band chain

*John Tower  
and his Surveyor  
March, 1902*

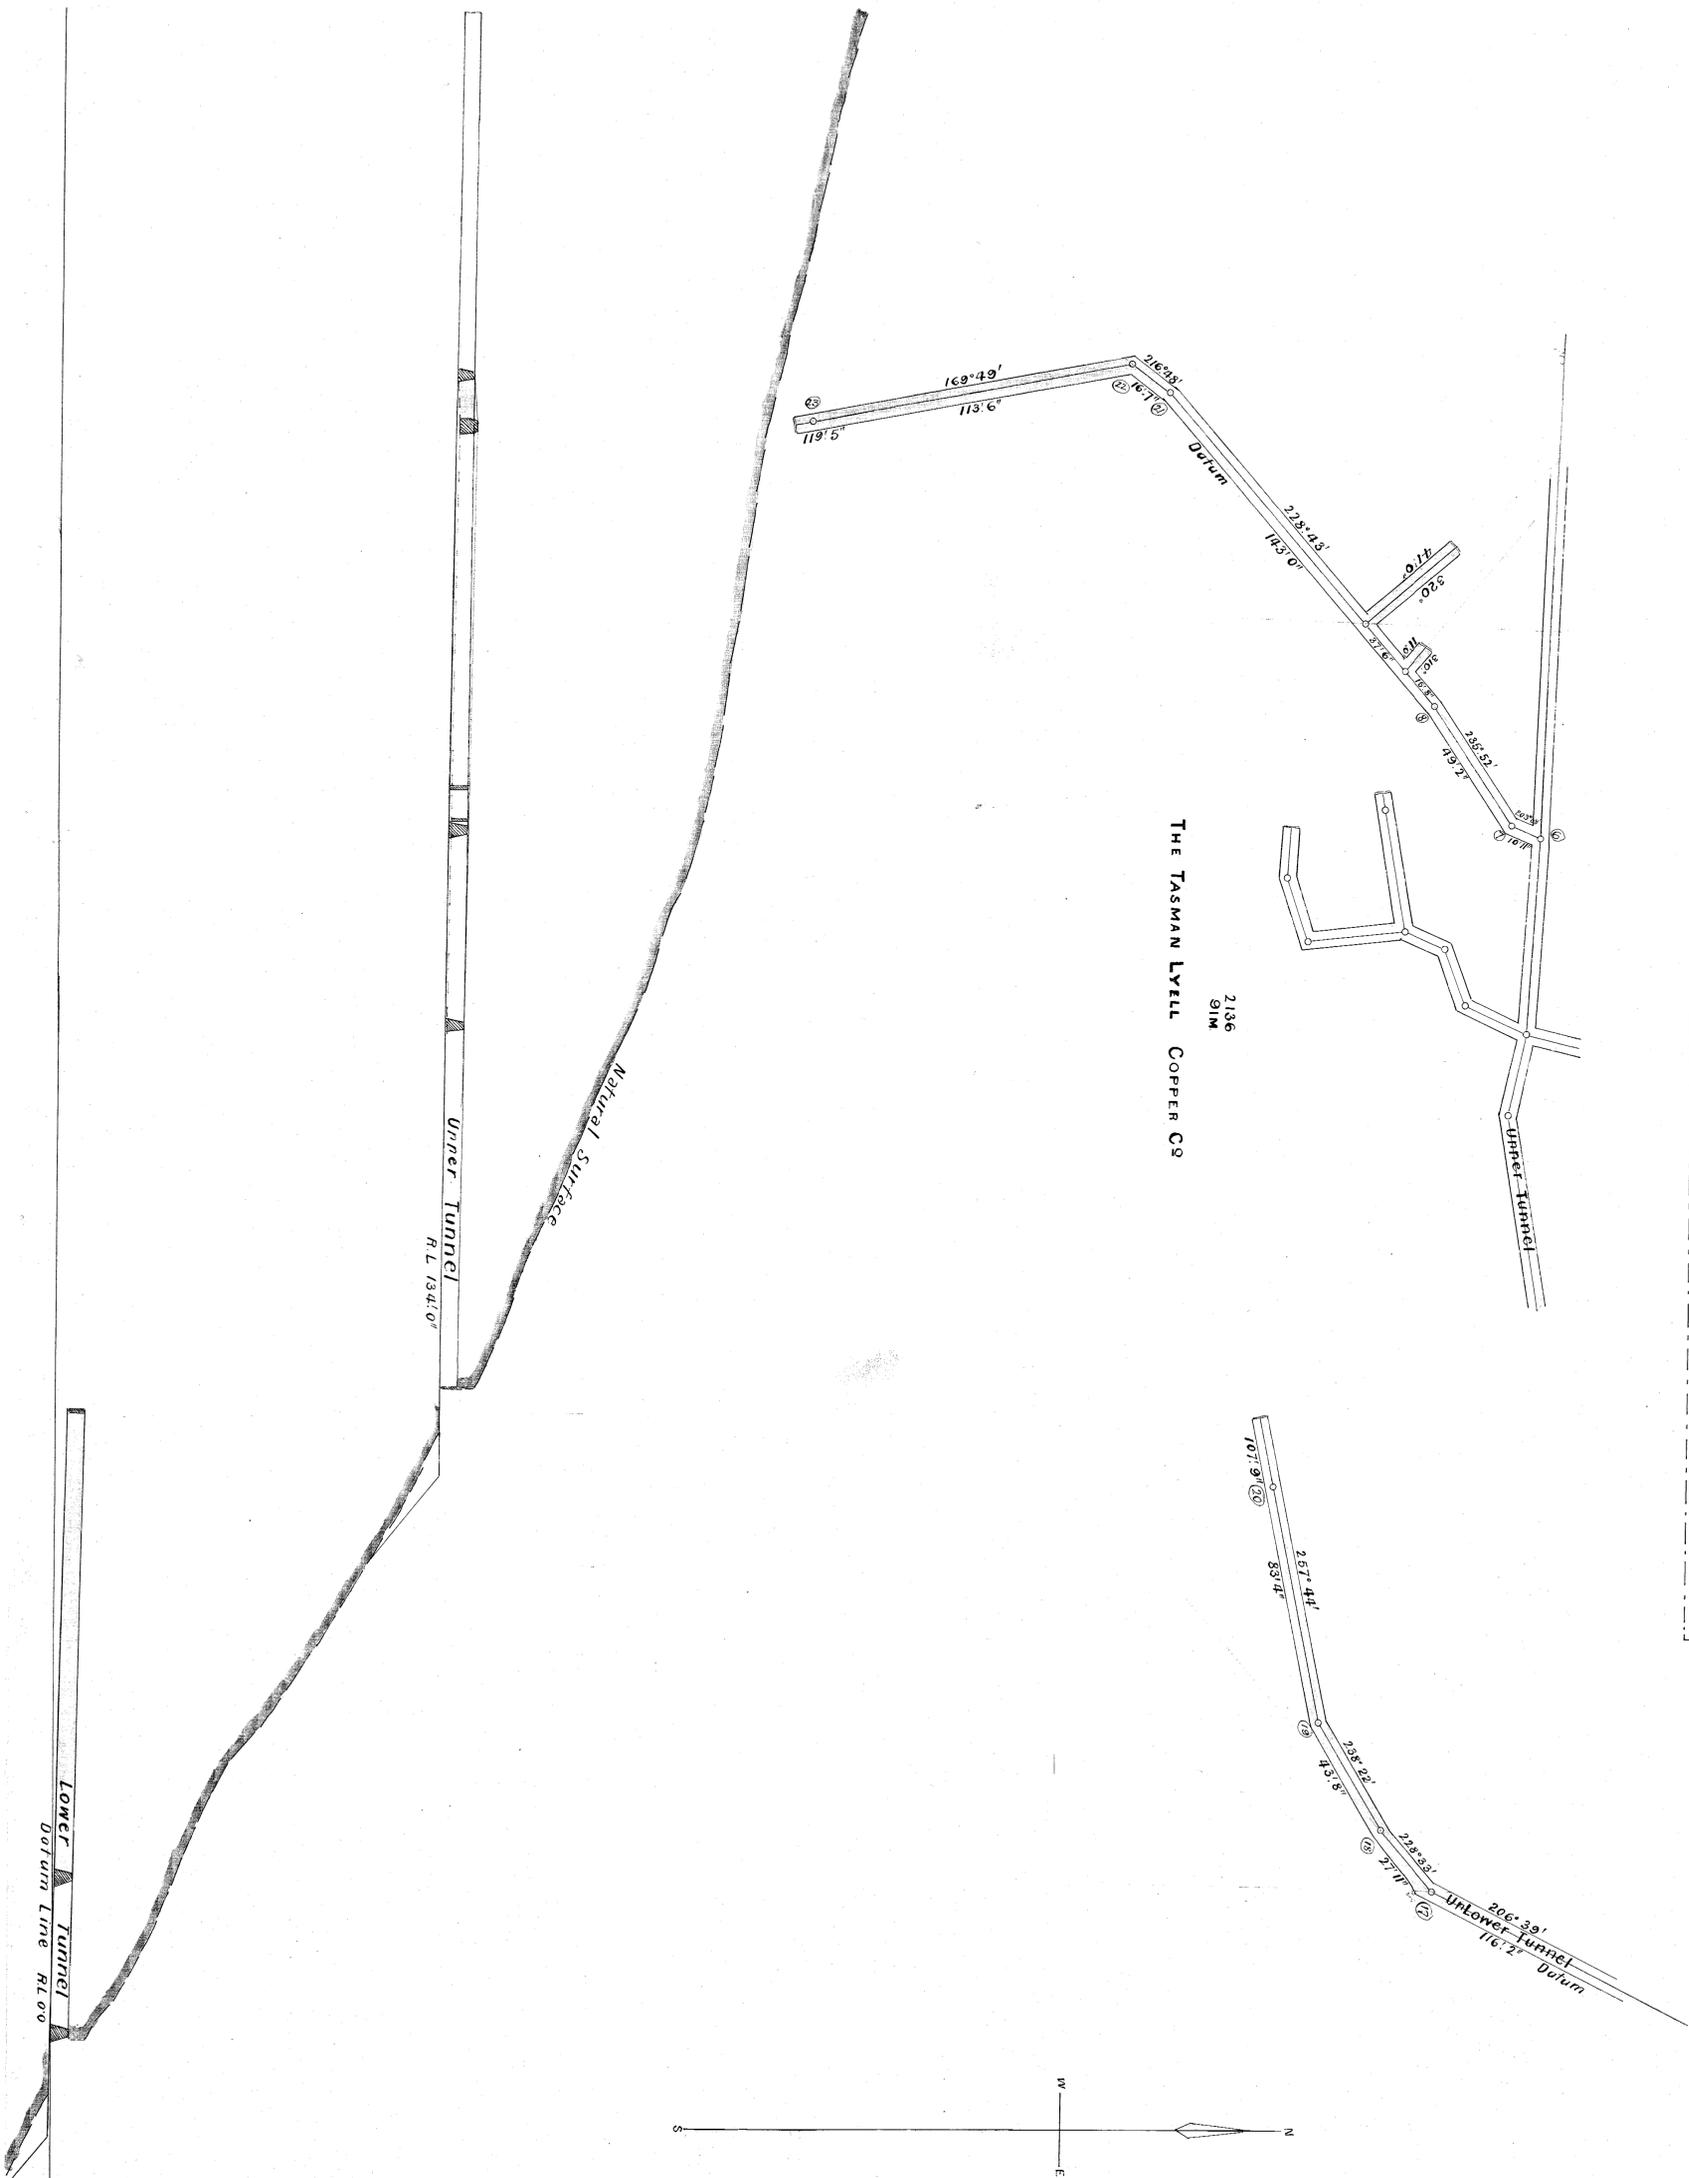

MT LYELL COMSTOCK  
1822  
S.M.