


143-03

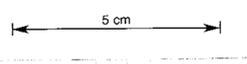


Handwritten notes:
143-03
D.L. 1898
D.L. 1898
D.L. 1898

Copper
TASMAN LYELL M^g CO *pat*
Underground Survey For 1898
25 Feet to an Inch

February 1898

J. J. Fellner
Asst. Surveyor
Feb. 27

MT LYELL COMSTOCK

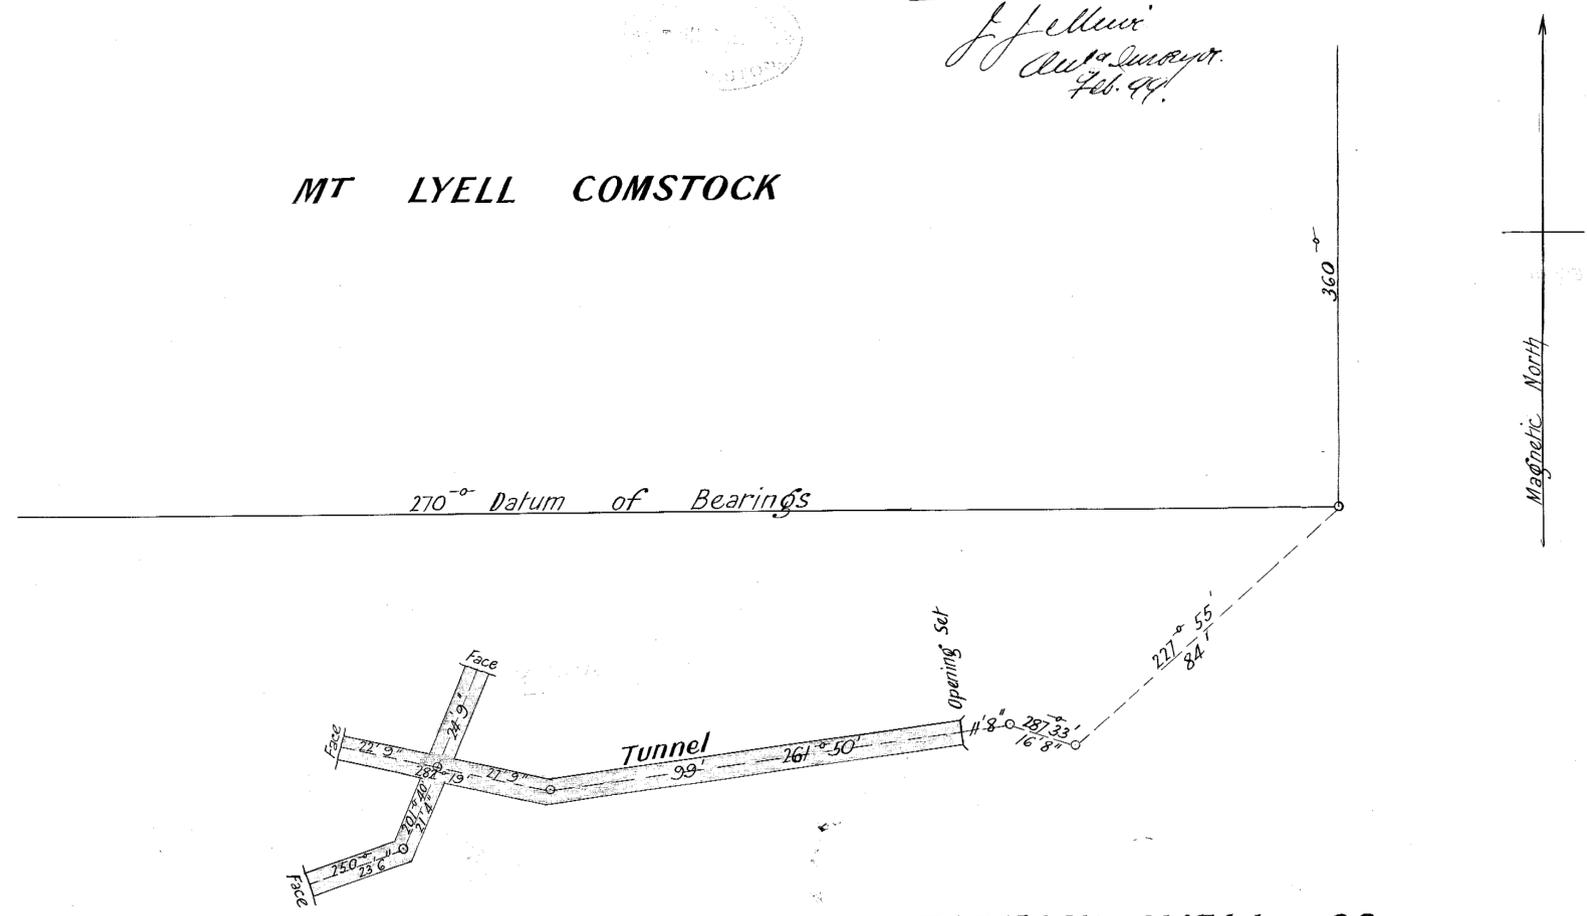

TASMAN LYELL CO

ae

ae