


THE TASMAN LYELL COPPER CO LTD

Underground Survey for 1900

Scale 25 feet = 1 inch

John Power
and his Surveyor
21st August 1901

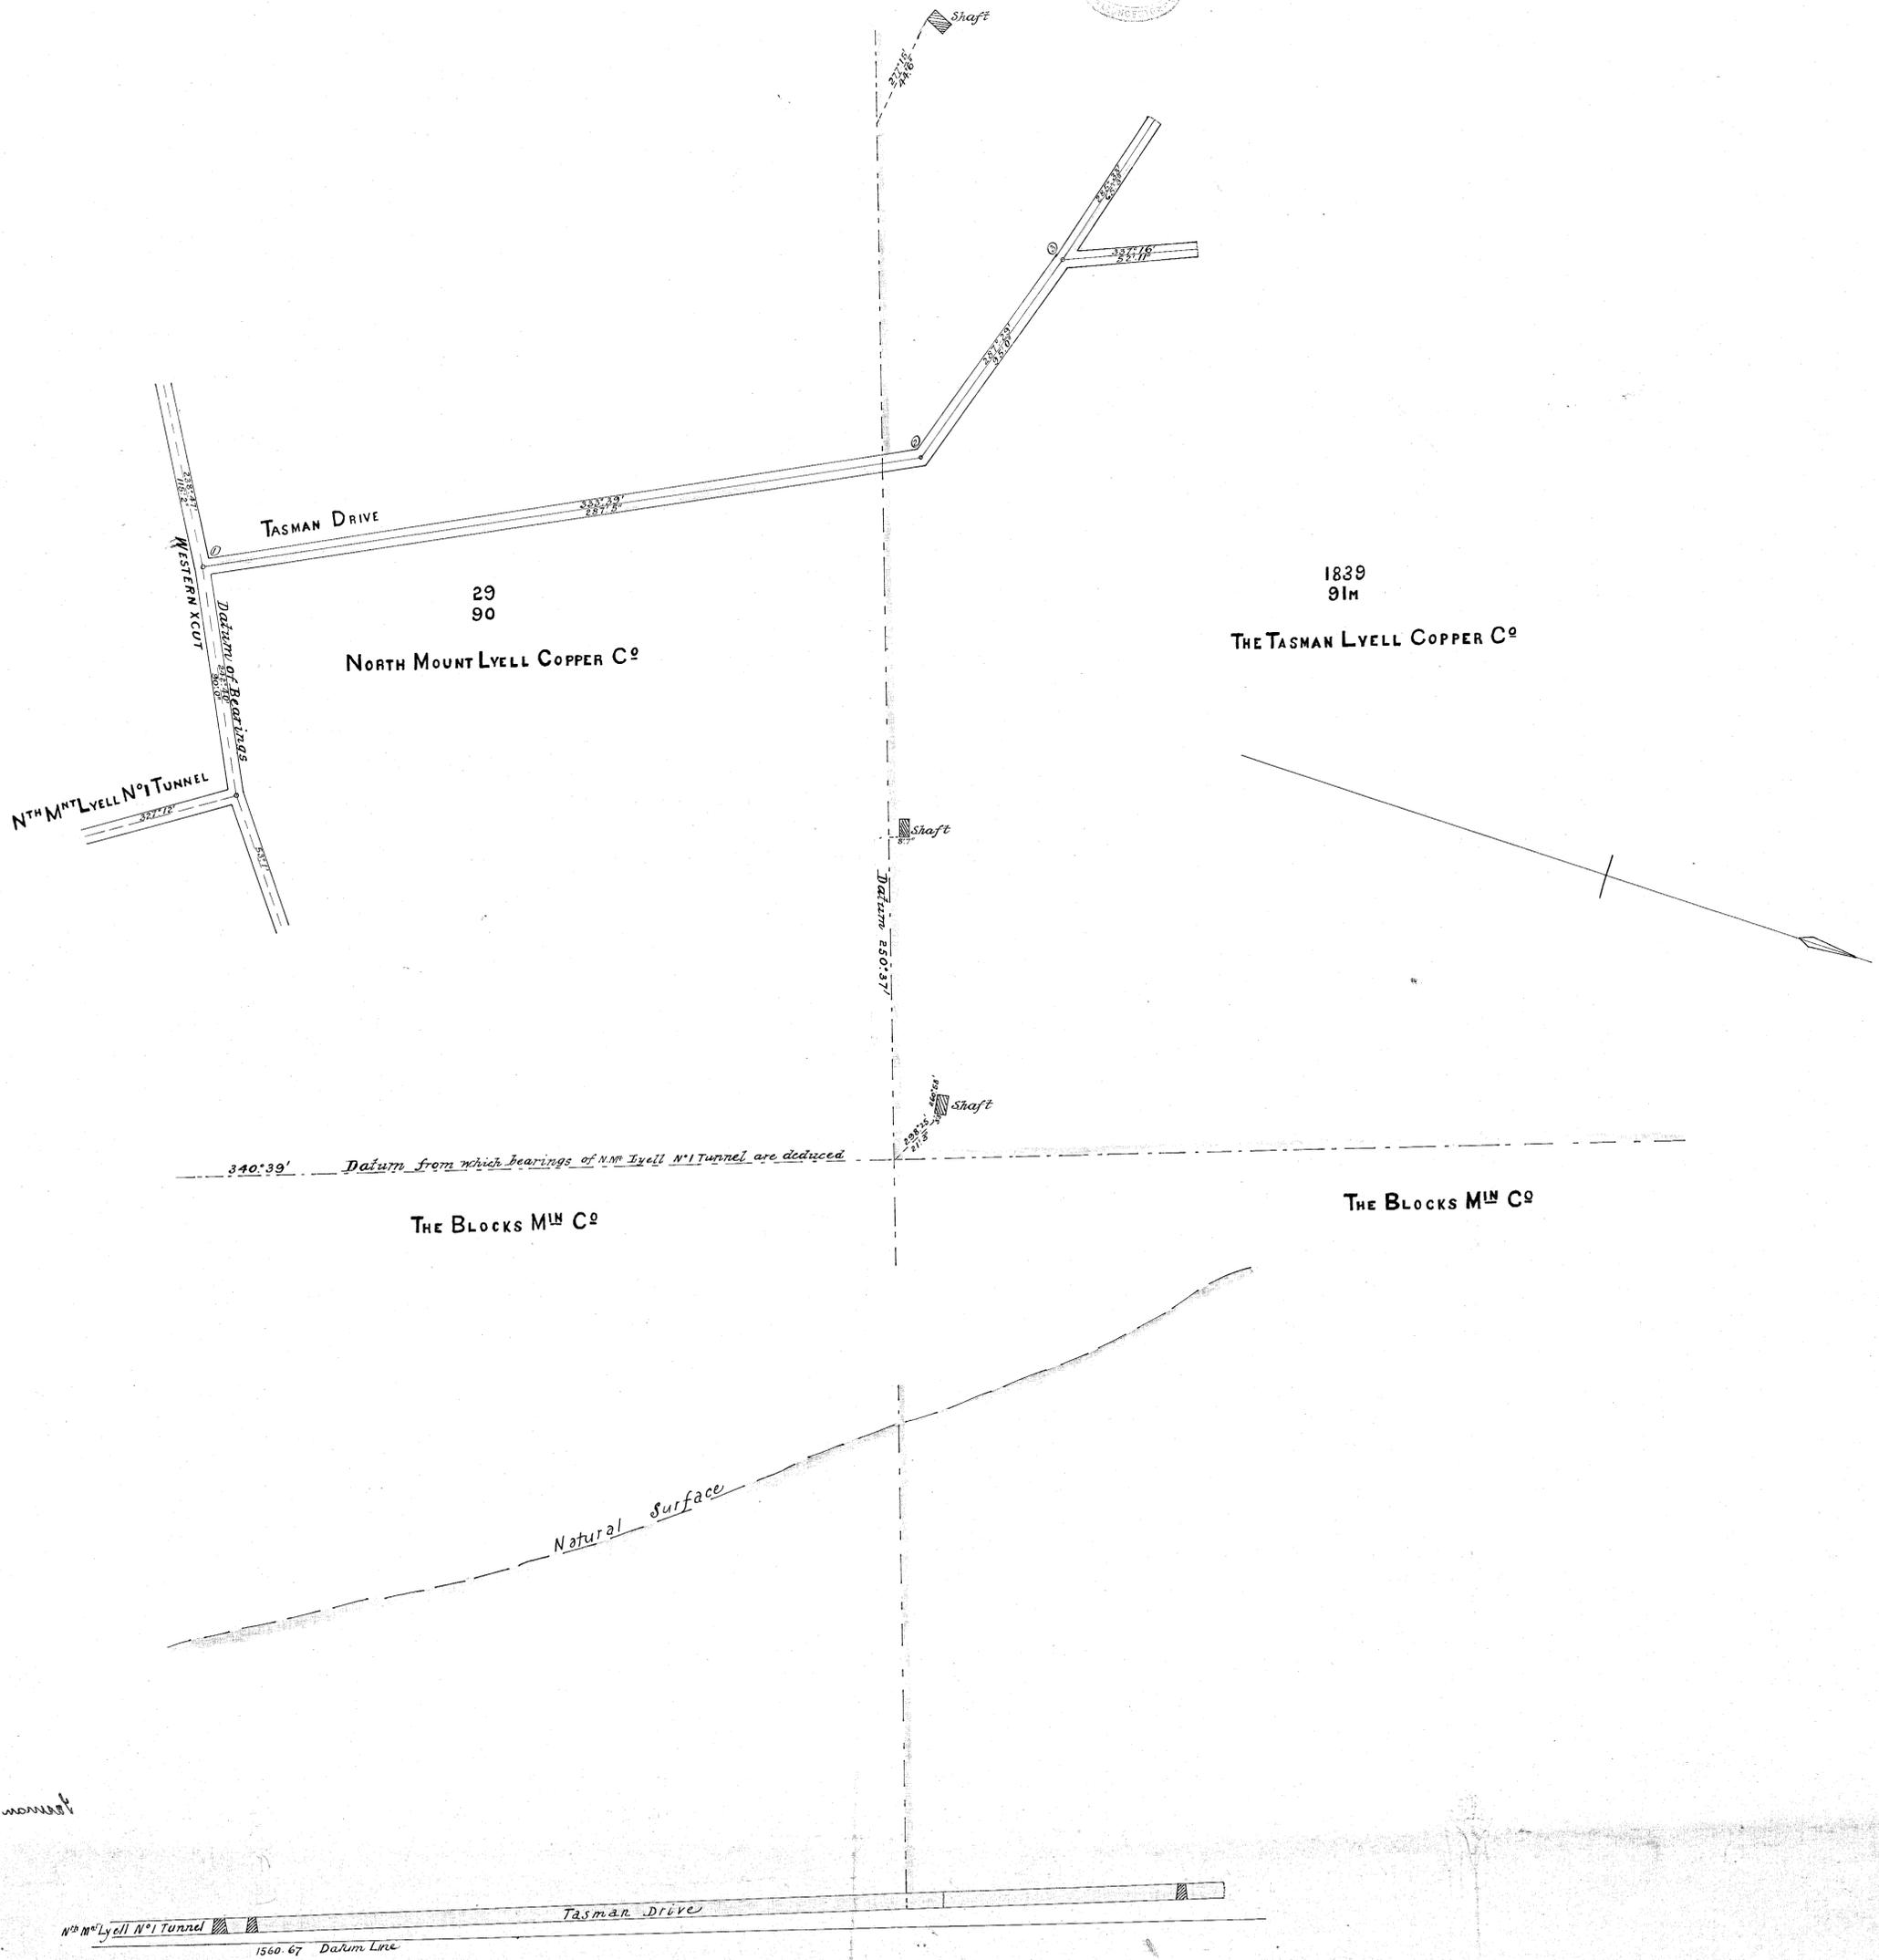

Handwritten note: The 2nd shaft is not shown on the plan

Handwritten note: 1901