



143-06

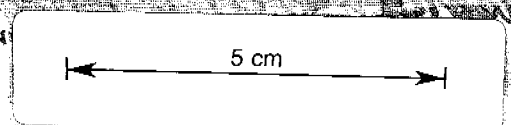

COMSTOCK MINING CO

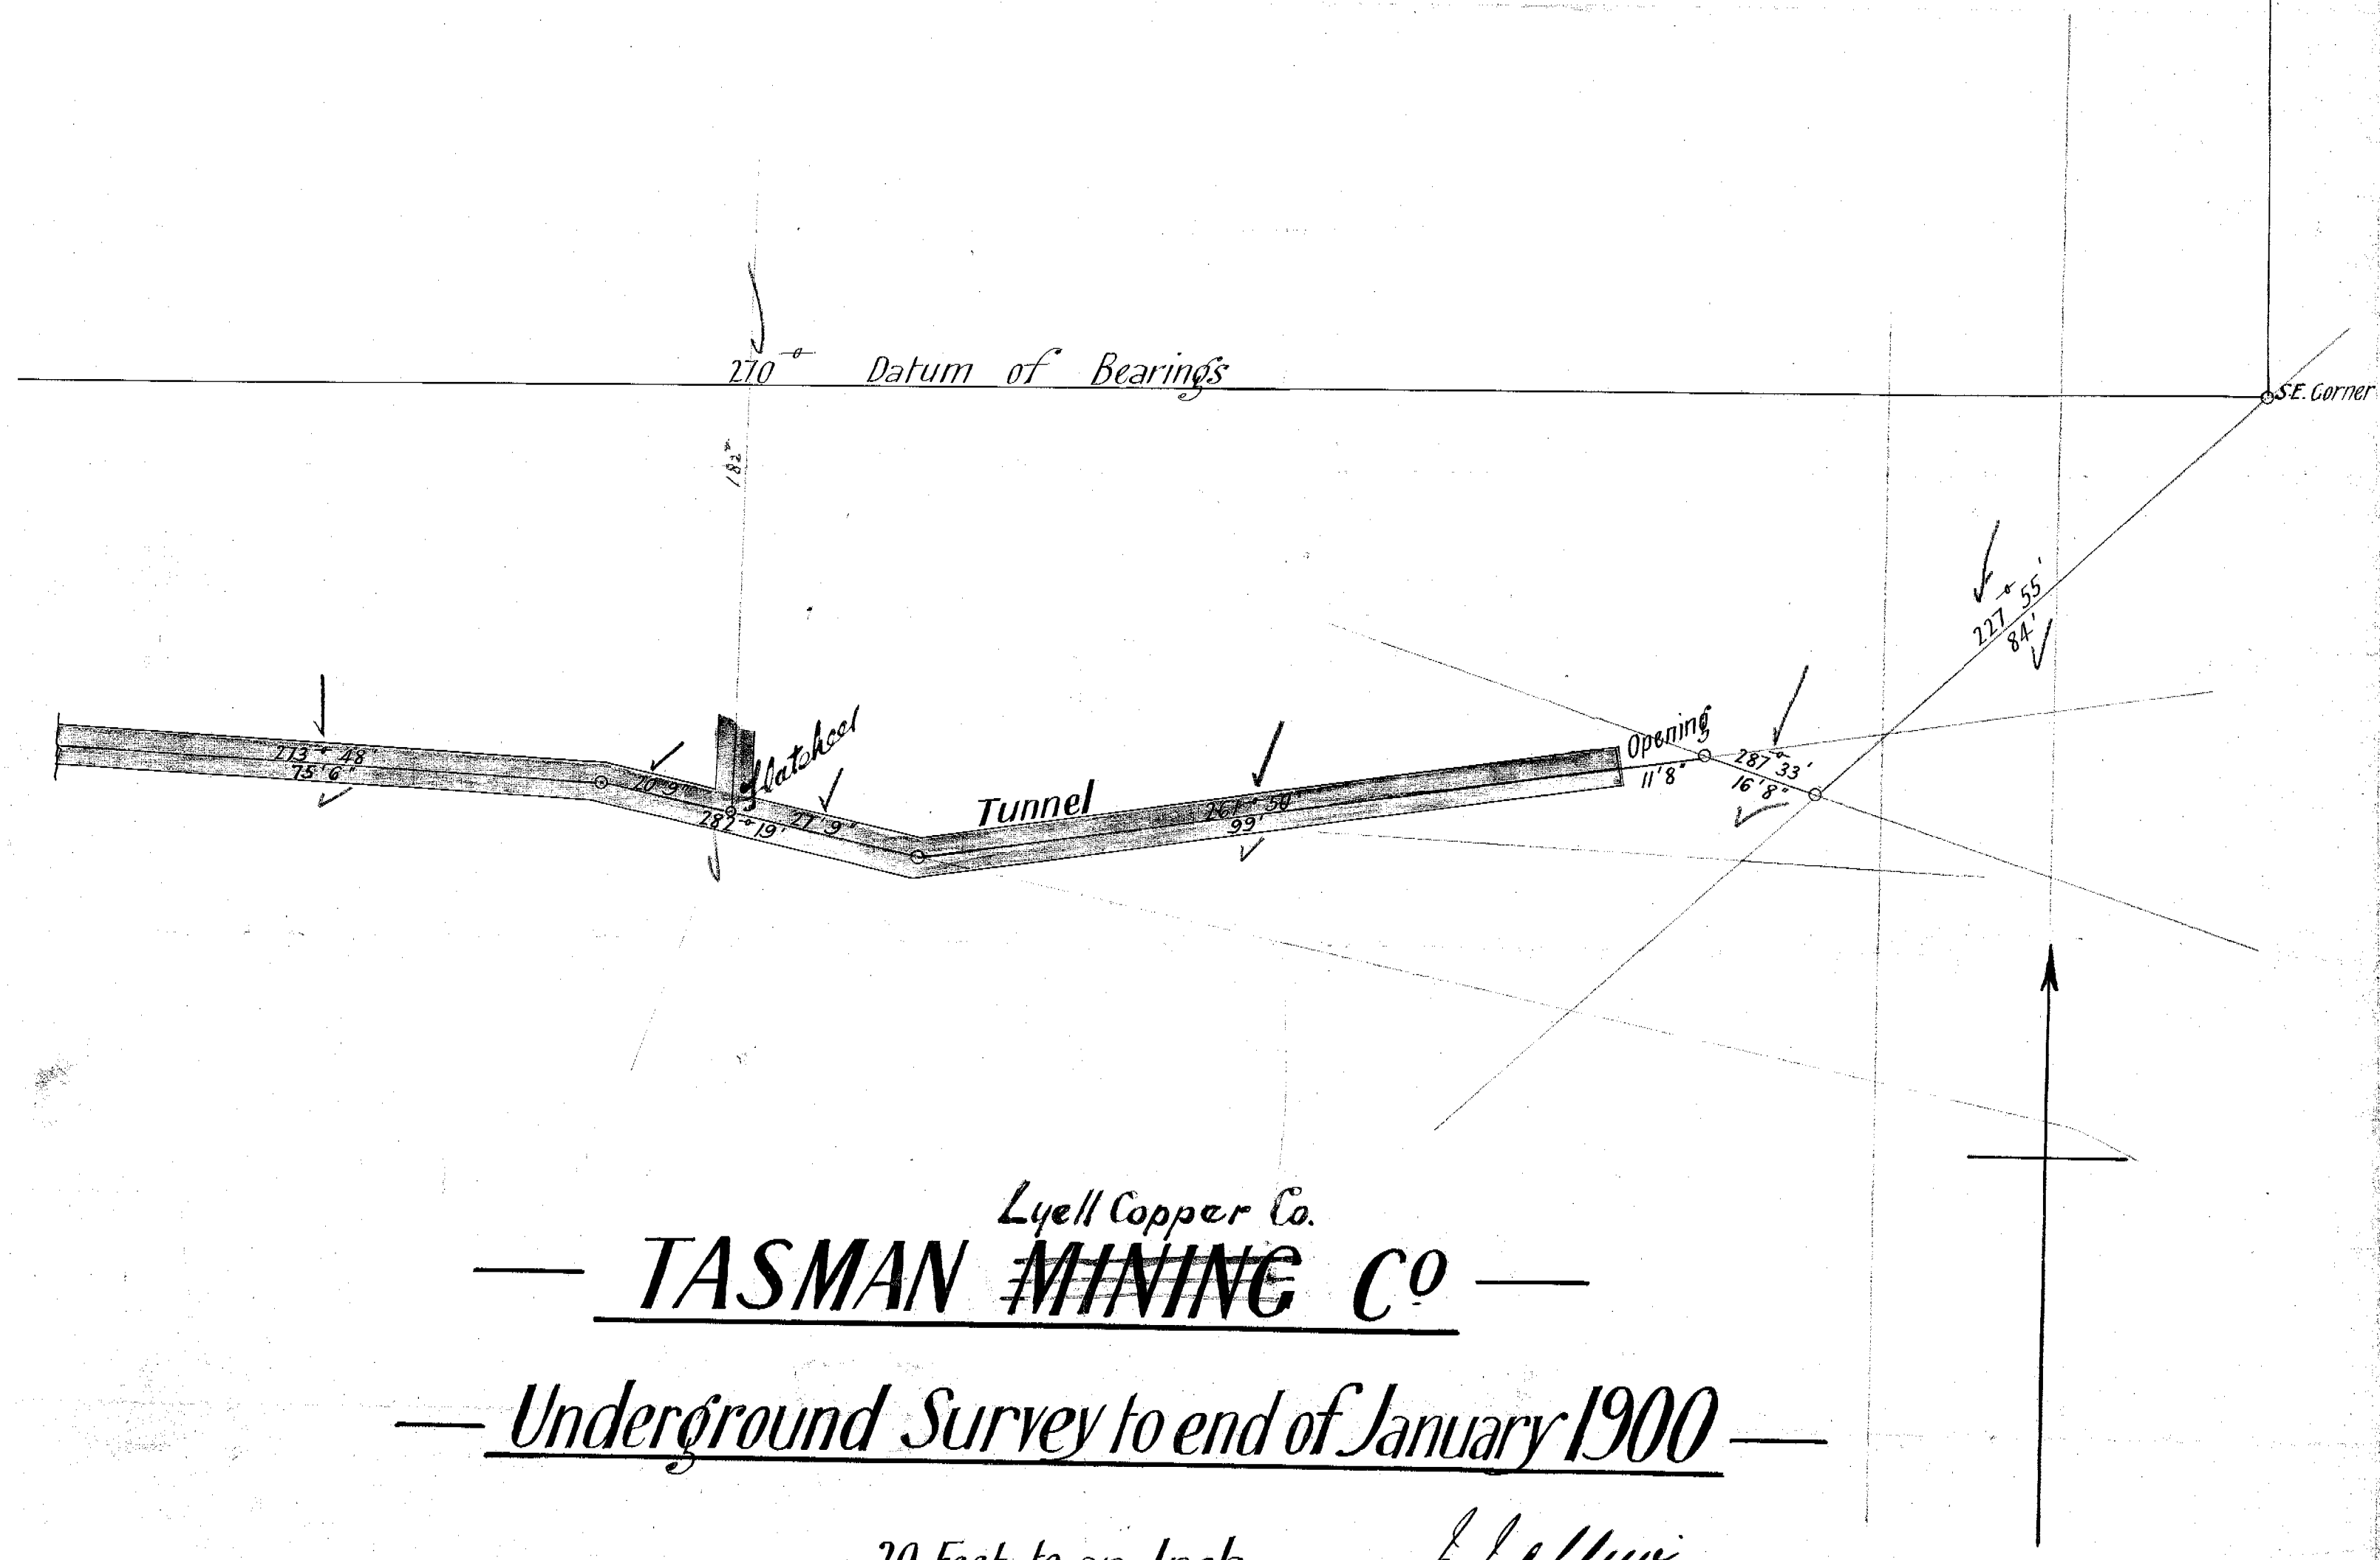

— *Lyell Copper Co.* —
TASMAN MINING CO —
— Underground Survey to end of January 1900 —

— 20 Feet to an Inch — *J. J. Ellwri*
Authorized Surveyor,
Jan'y. 1900.