

# M<sup>r</sup> Lyell Extended Mining C<sup>o</sup>

Underground Survey for 1896


Scale 25F<sup>t</sup> to an Inch

Official

I Certify this Plan Correct

*J. J. Hair*

Authorized Surveyor, Lyell Jan<sup>y</sup> 1897

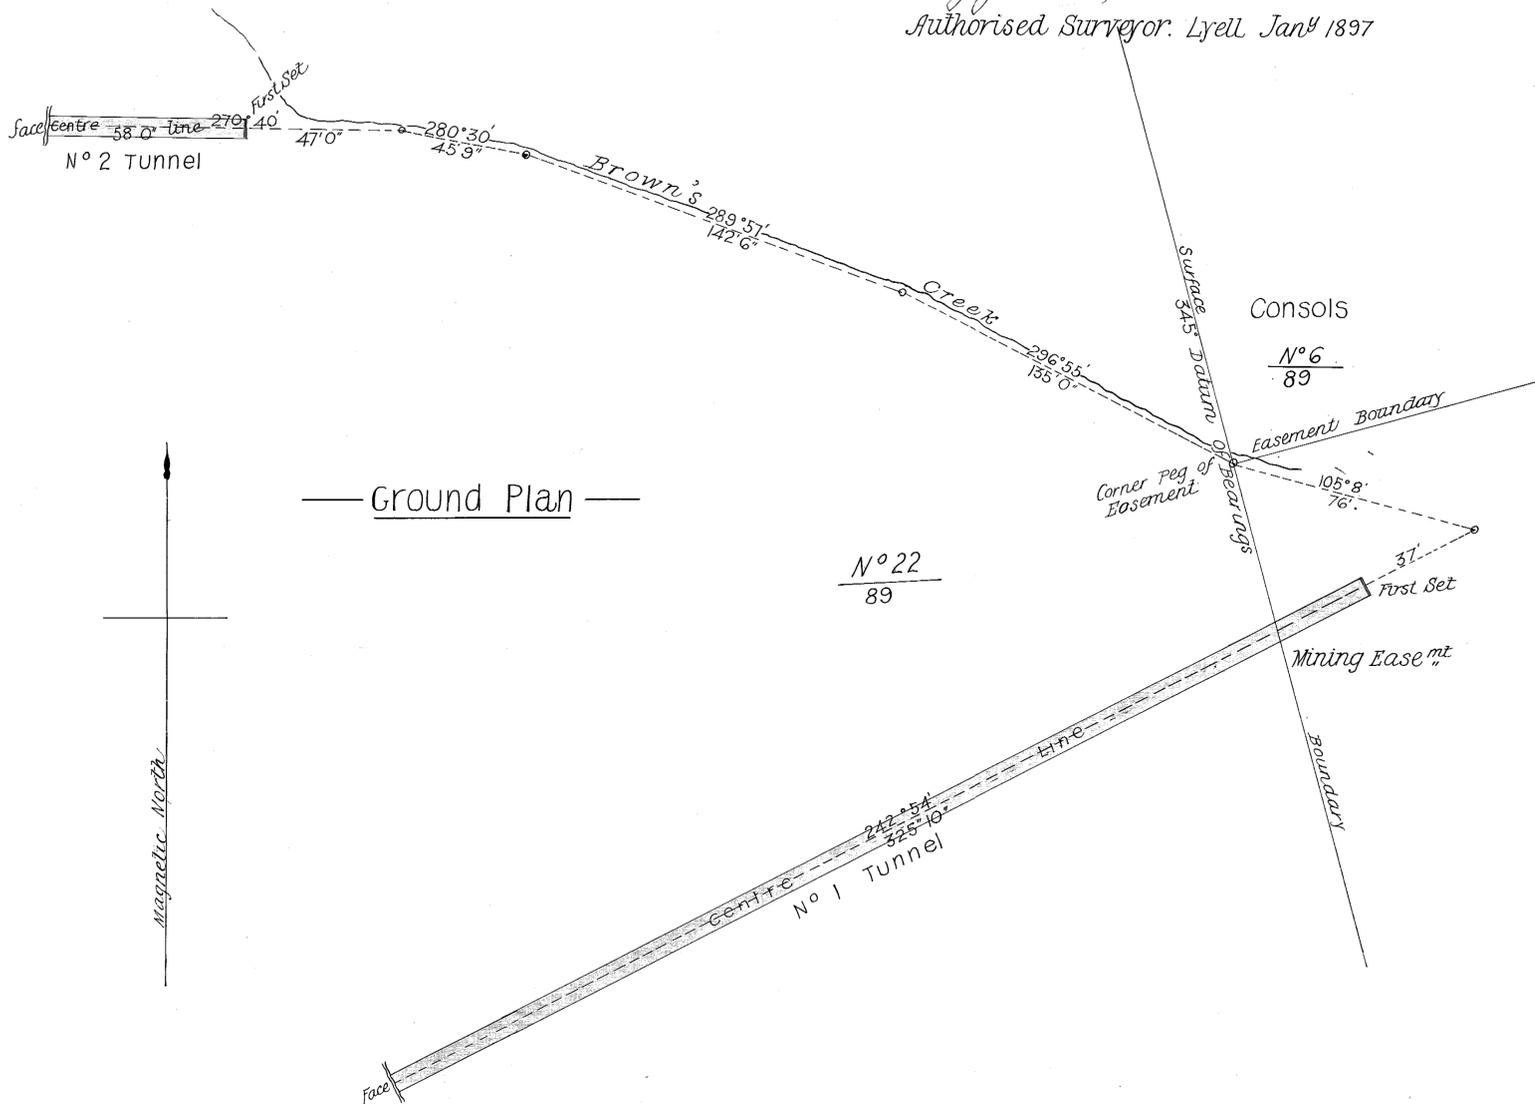

Ground Plan

N° 2 Tunnel

Finis	(58)	Face
000	270°40'	
(47°0')	First Set	
000	270°40'	
(45°9')	Station	
000	280°30'	
(142°6')	Station	
000	289°57'	
(135)	Station	
000	296°55'	
000	345	Surface
NW Corner of Mining Easement		

Magnetic North

N° 1 Tunnel

Finis	(325.10)	Face
000	242°54'	
(37)	First Set	
000	242°54'	
(76)	Stn	
000	105°8'	
NW corner of Mining Easement		

Surface 345

From NW Corner of Mining Easement

Sections

Field Notes

