

5 cm

144-02

(205) At face of tunnel
 34' opening set.
 000 of tunnel
 242°54'
 (46) Instrument point
 back of tunnel alignment
 000
 105°8'
 from A Mining Easement

Datum taken at 345°

MOUNT LYELL EXTENDED M^cCOY

underground survey for

1896

Scale of 25ft to an inch


Certified Correct

J. Jellum

Authorized Surveyor
at Mt Lyell Feb. 96.



Magnetic

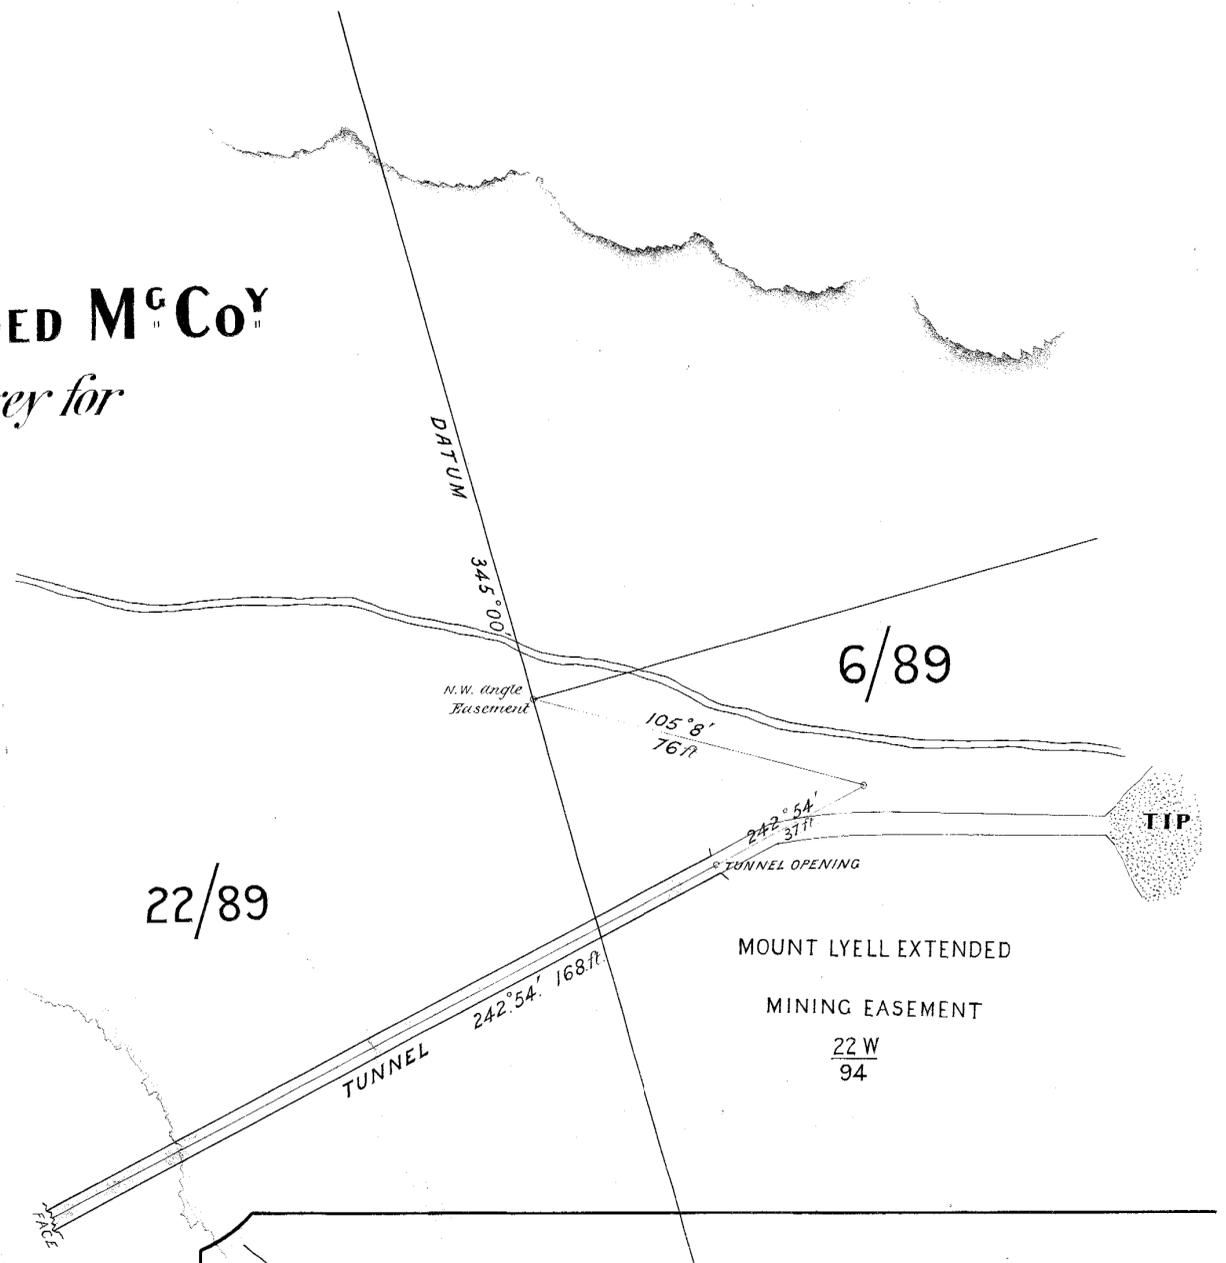


6/89

22/89

MOUNT LYELL EXTENDED

MINING EASEMENT

22 W
94

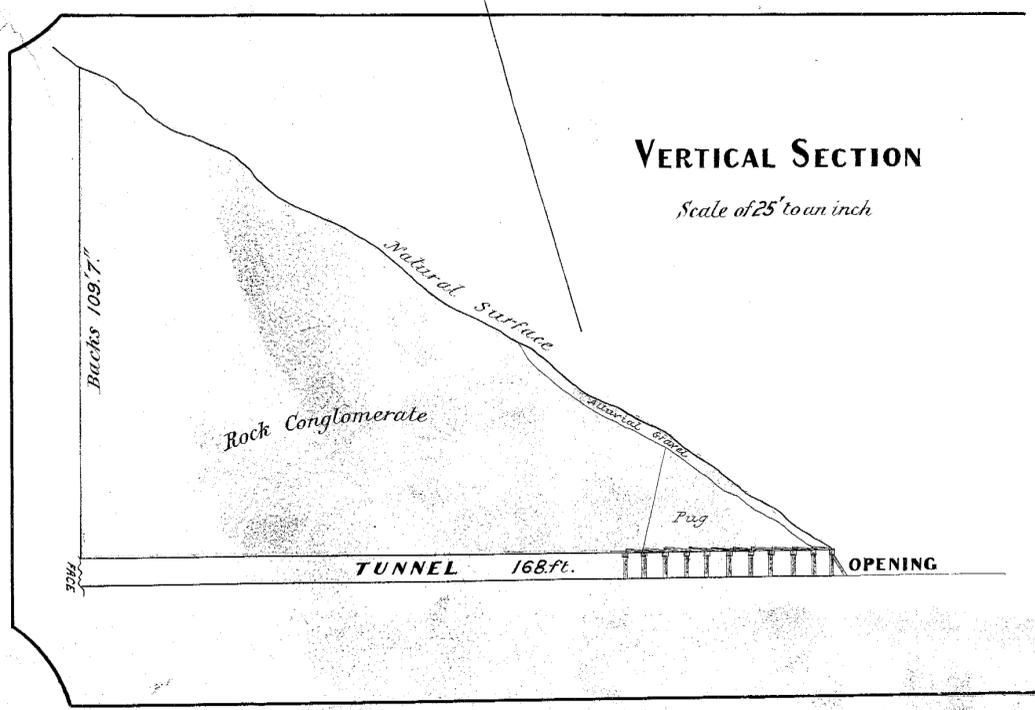

VERTICAL SECTION

Scale of 25' to an inch