




1144-04

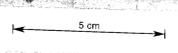


This portion is plotted on scale of 2.5' to the inch
7.24.

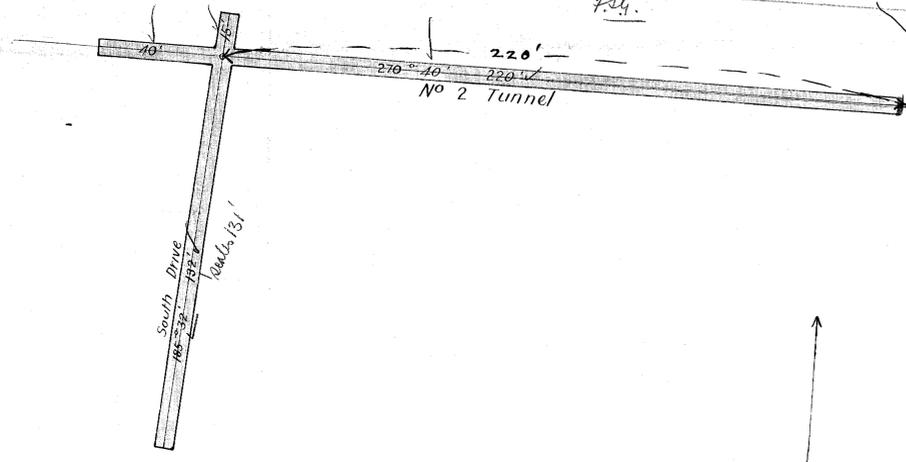

This portion is plotted on scale of 30' to the inch
7.24.

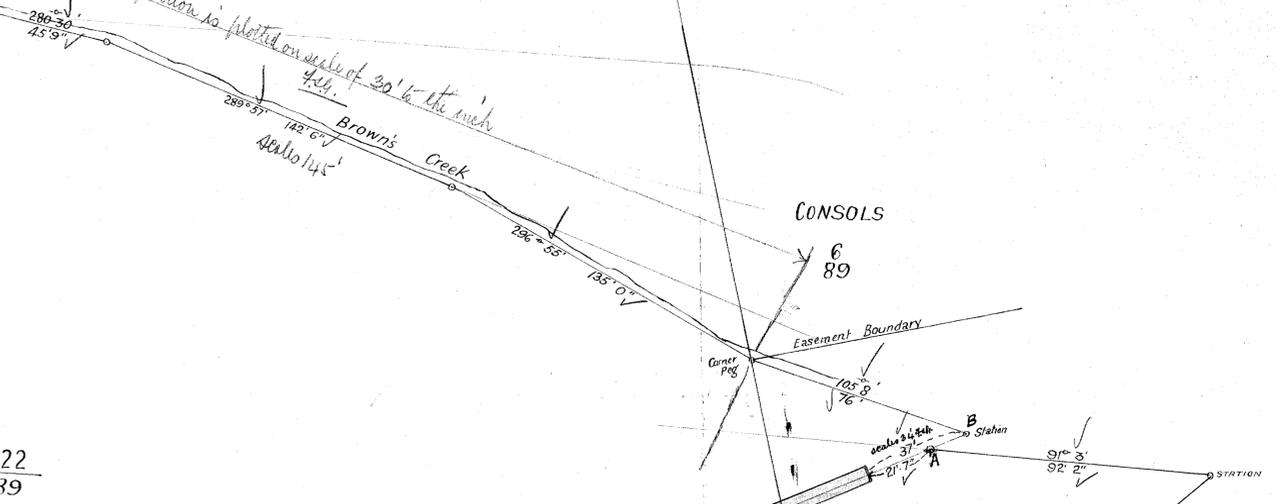

22
89

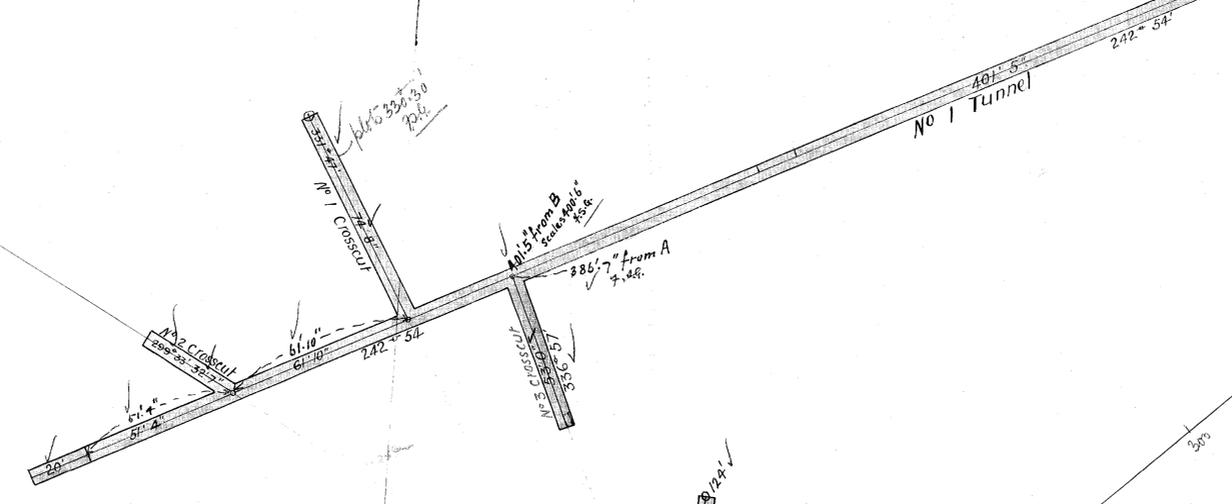

MT LYELL EXTENDED MINING CO
Underground Survey to end of 1898
25 Feet to an Inch

Extensions to end March 1901
as shown in Blue

W. M. Eacker
Author & Surveyor
8/2/1901



112

112