


111

5 cm
145-03

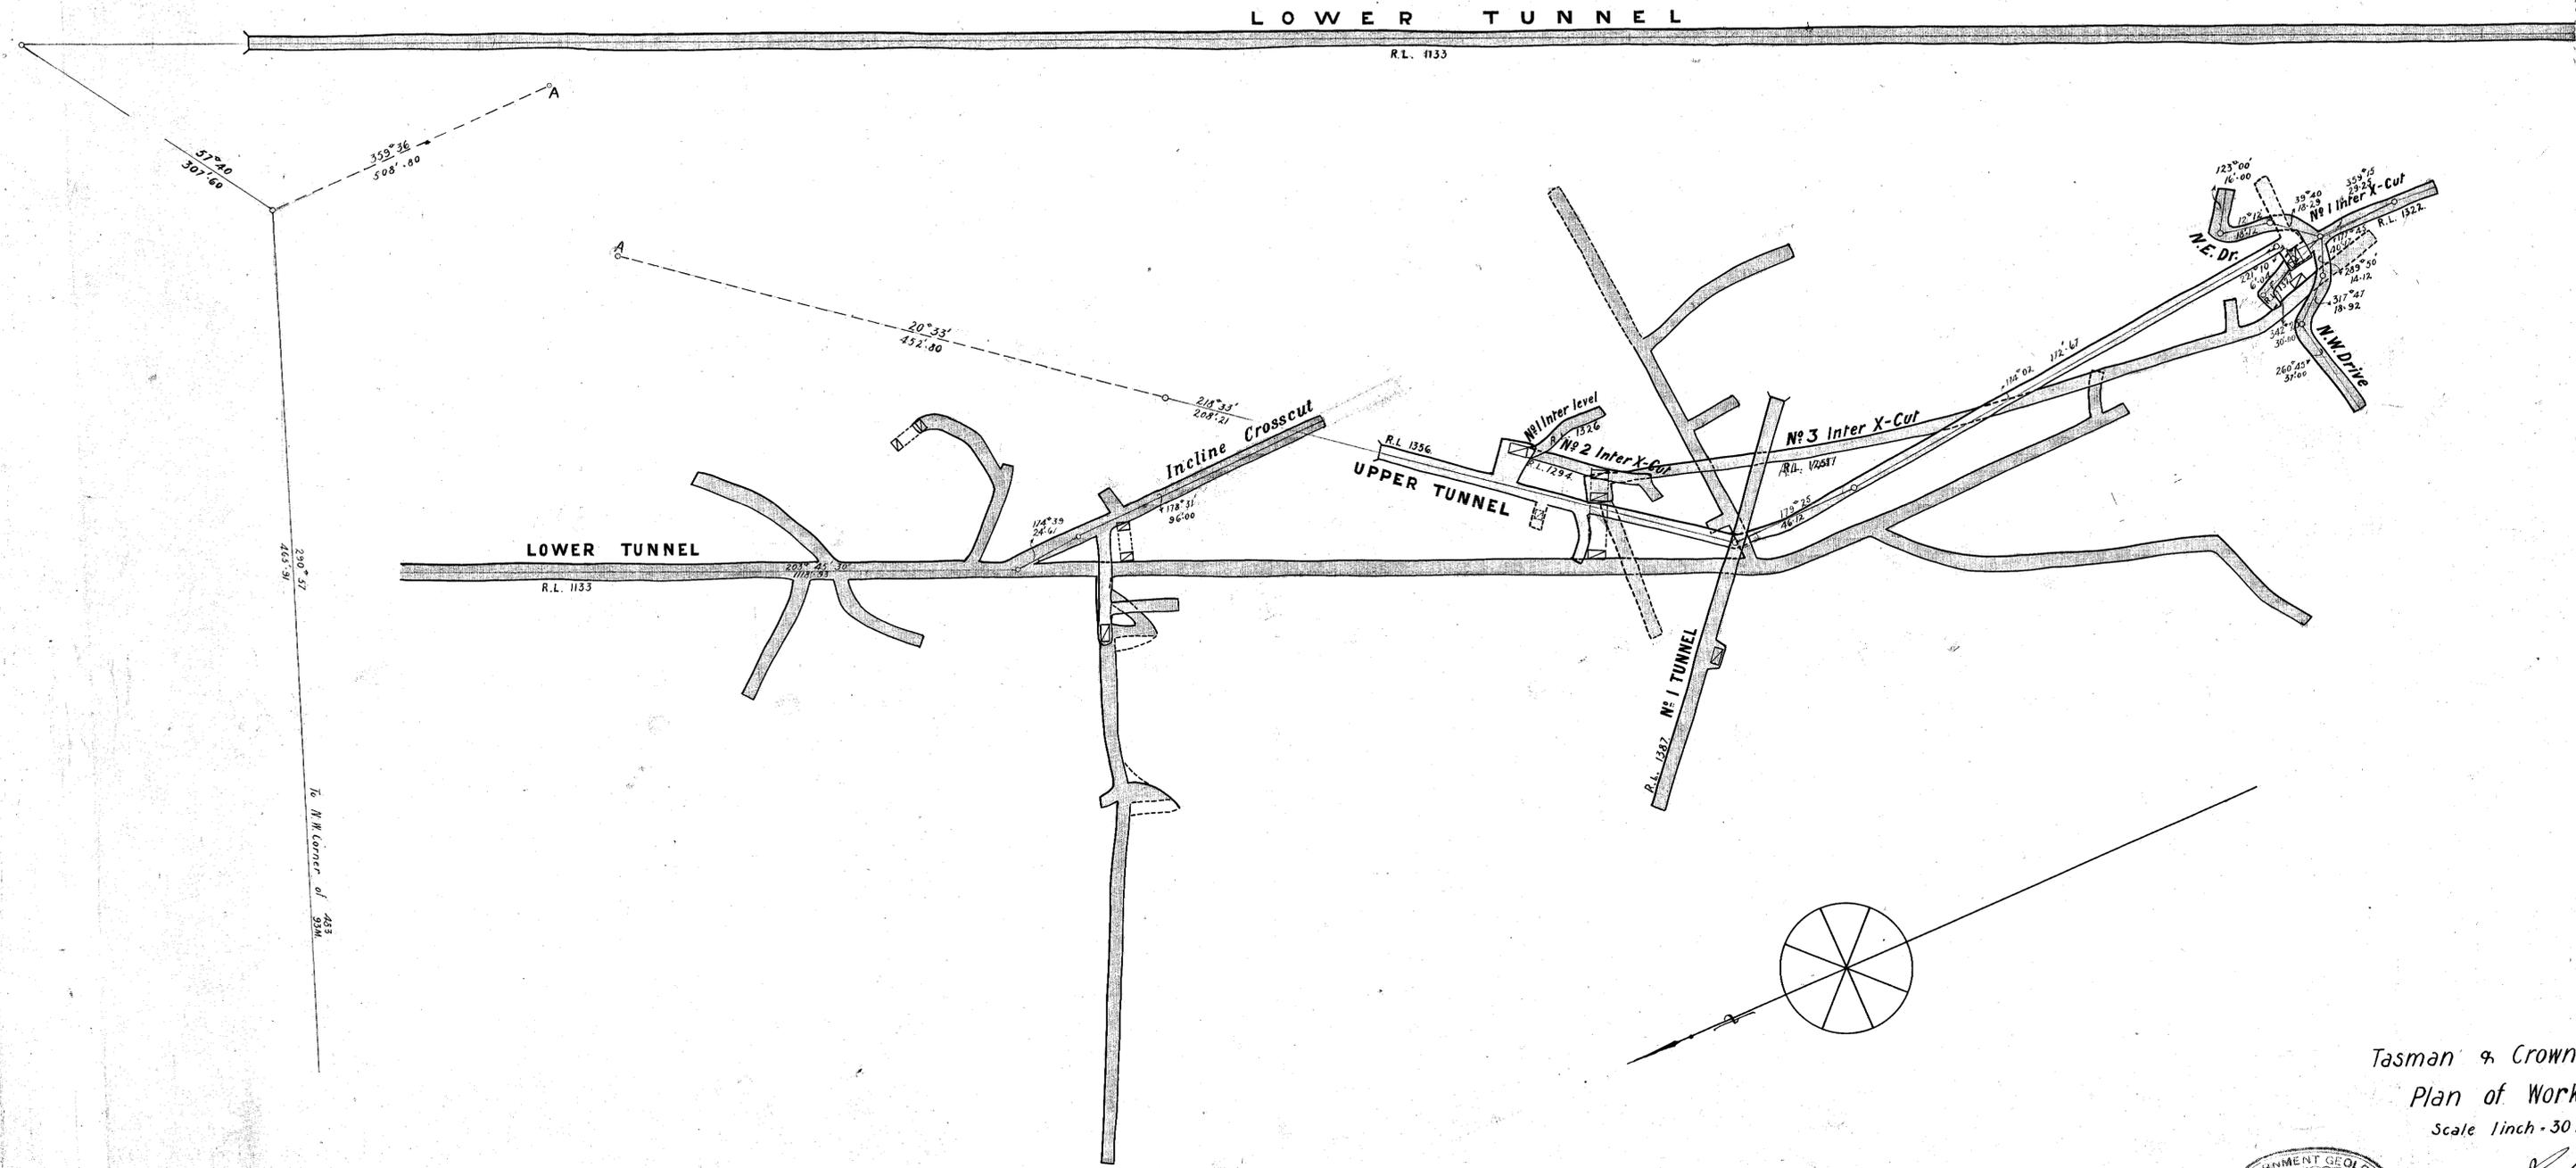

Tasman & Crown Lyell Extⁿ
 Plan of Workings 30.6.08.
 Scale 1 inch = 30 feet.



R. O. Murray B. Sc.
 Geol. Survey
 Launceston

June 1888
 Tasman & Crown Lyell Extⁿ

145-03