


TASMAN AND CROWN LYELL EXTENDED MINES NO LIA.

UNDERGROUND WORKINGS CONNECTED WITH SHAFT

SCALE AN INCH = 30 FEET

*Charleston
25th March 1911*

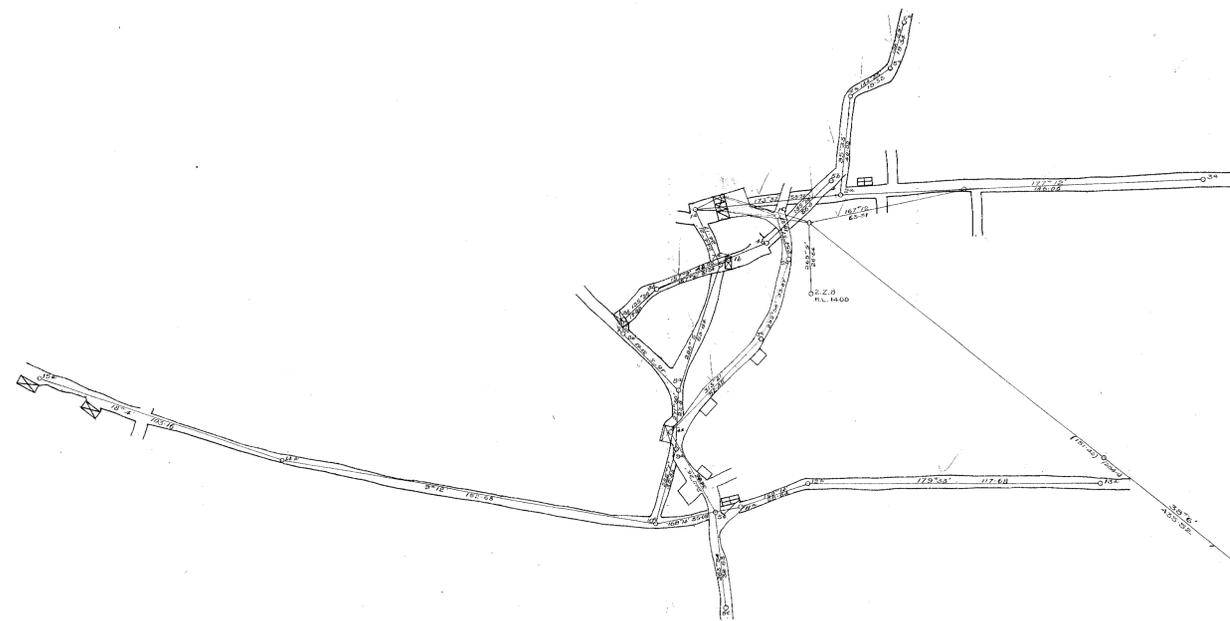

MOUNT LYELL COMSTOCK COPPER CO LTD

2135	2136
91 M	91 M

90-511

14-06