


EE

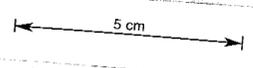


147-01

# LONGITUDINAL SECTION

## NATIVE YOUTH G M C

### North Leg

Scale 25 f<sup>t</sup> to an inch.

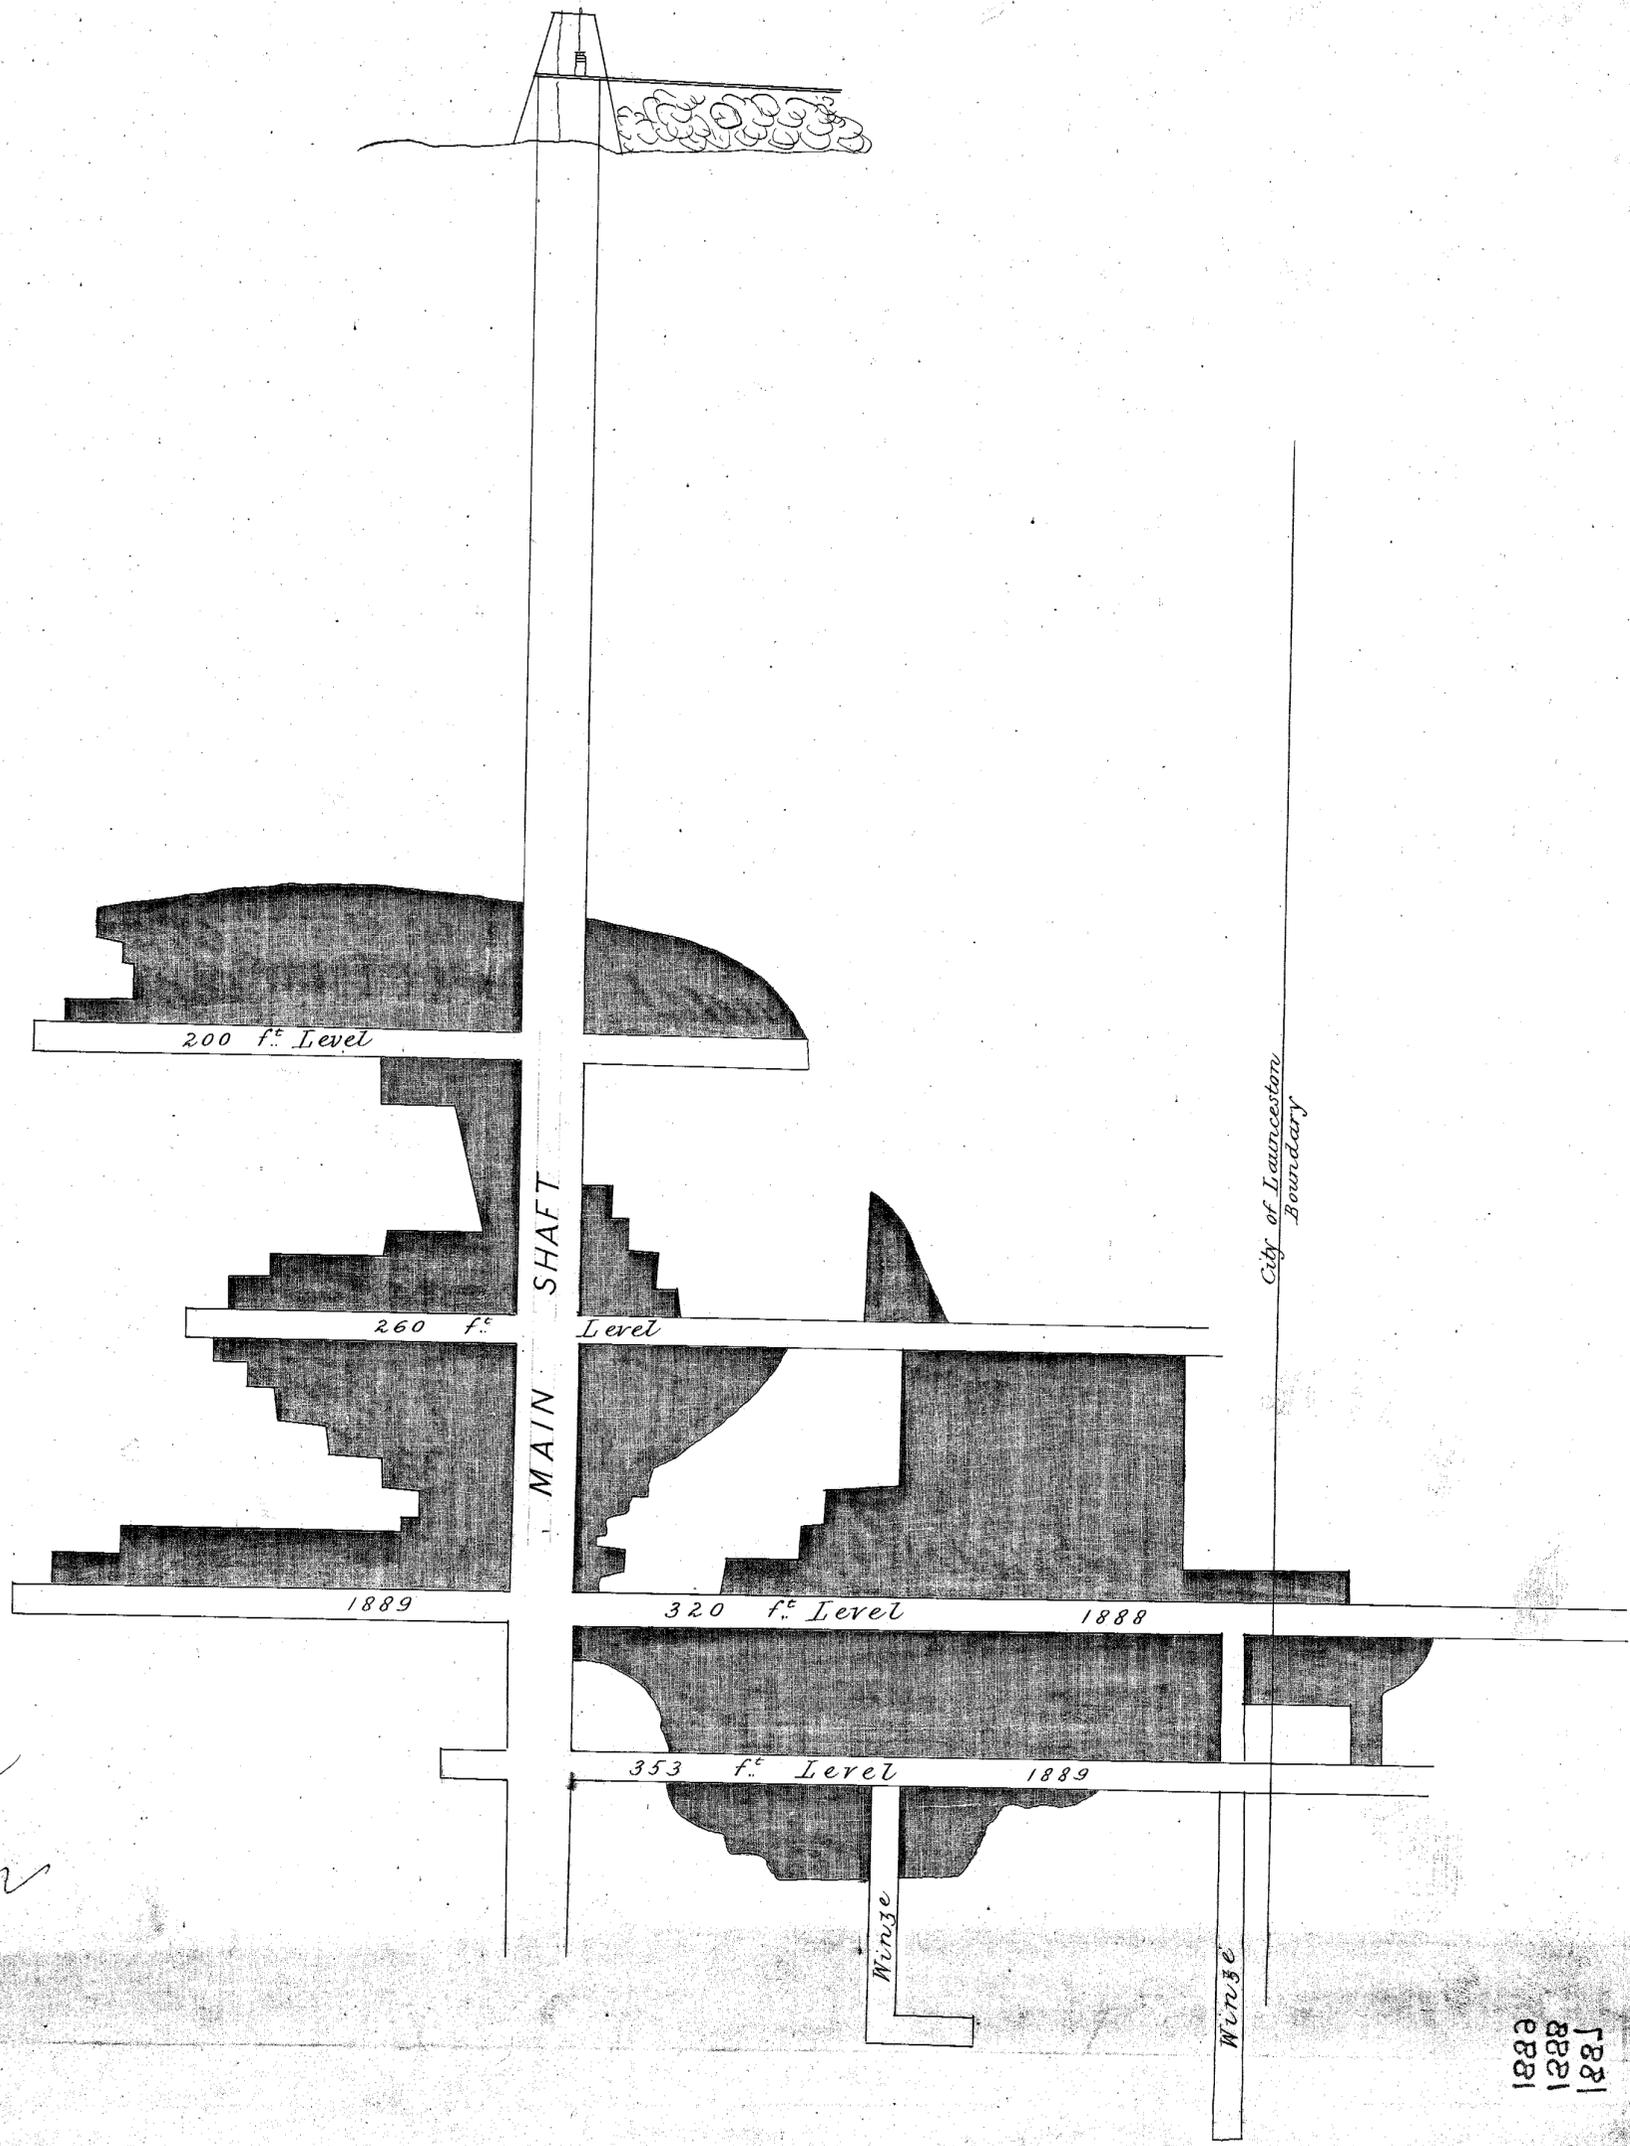

*Corrected Correct Copy  
 of plan in managers office  
 of work done during 1887-8-9  
 C. Dingley Waterman  
 Asst. Manager*

1881  
 8881  
 8881