


NATIVE YOUTH G. M.

Ground Plan

Scale 25 Feet to an Inch.

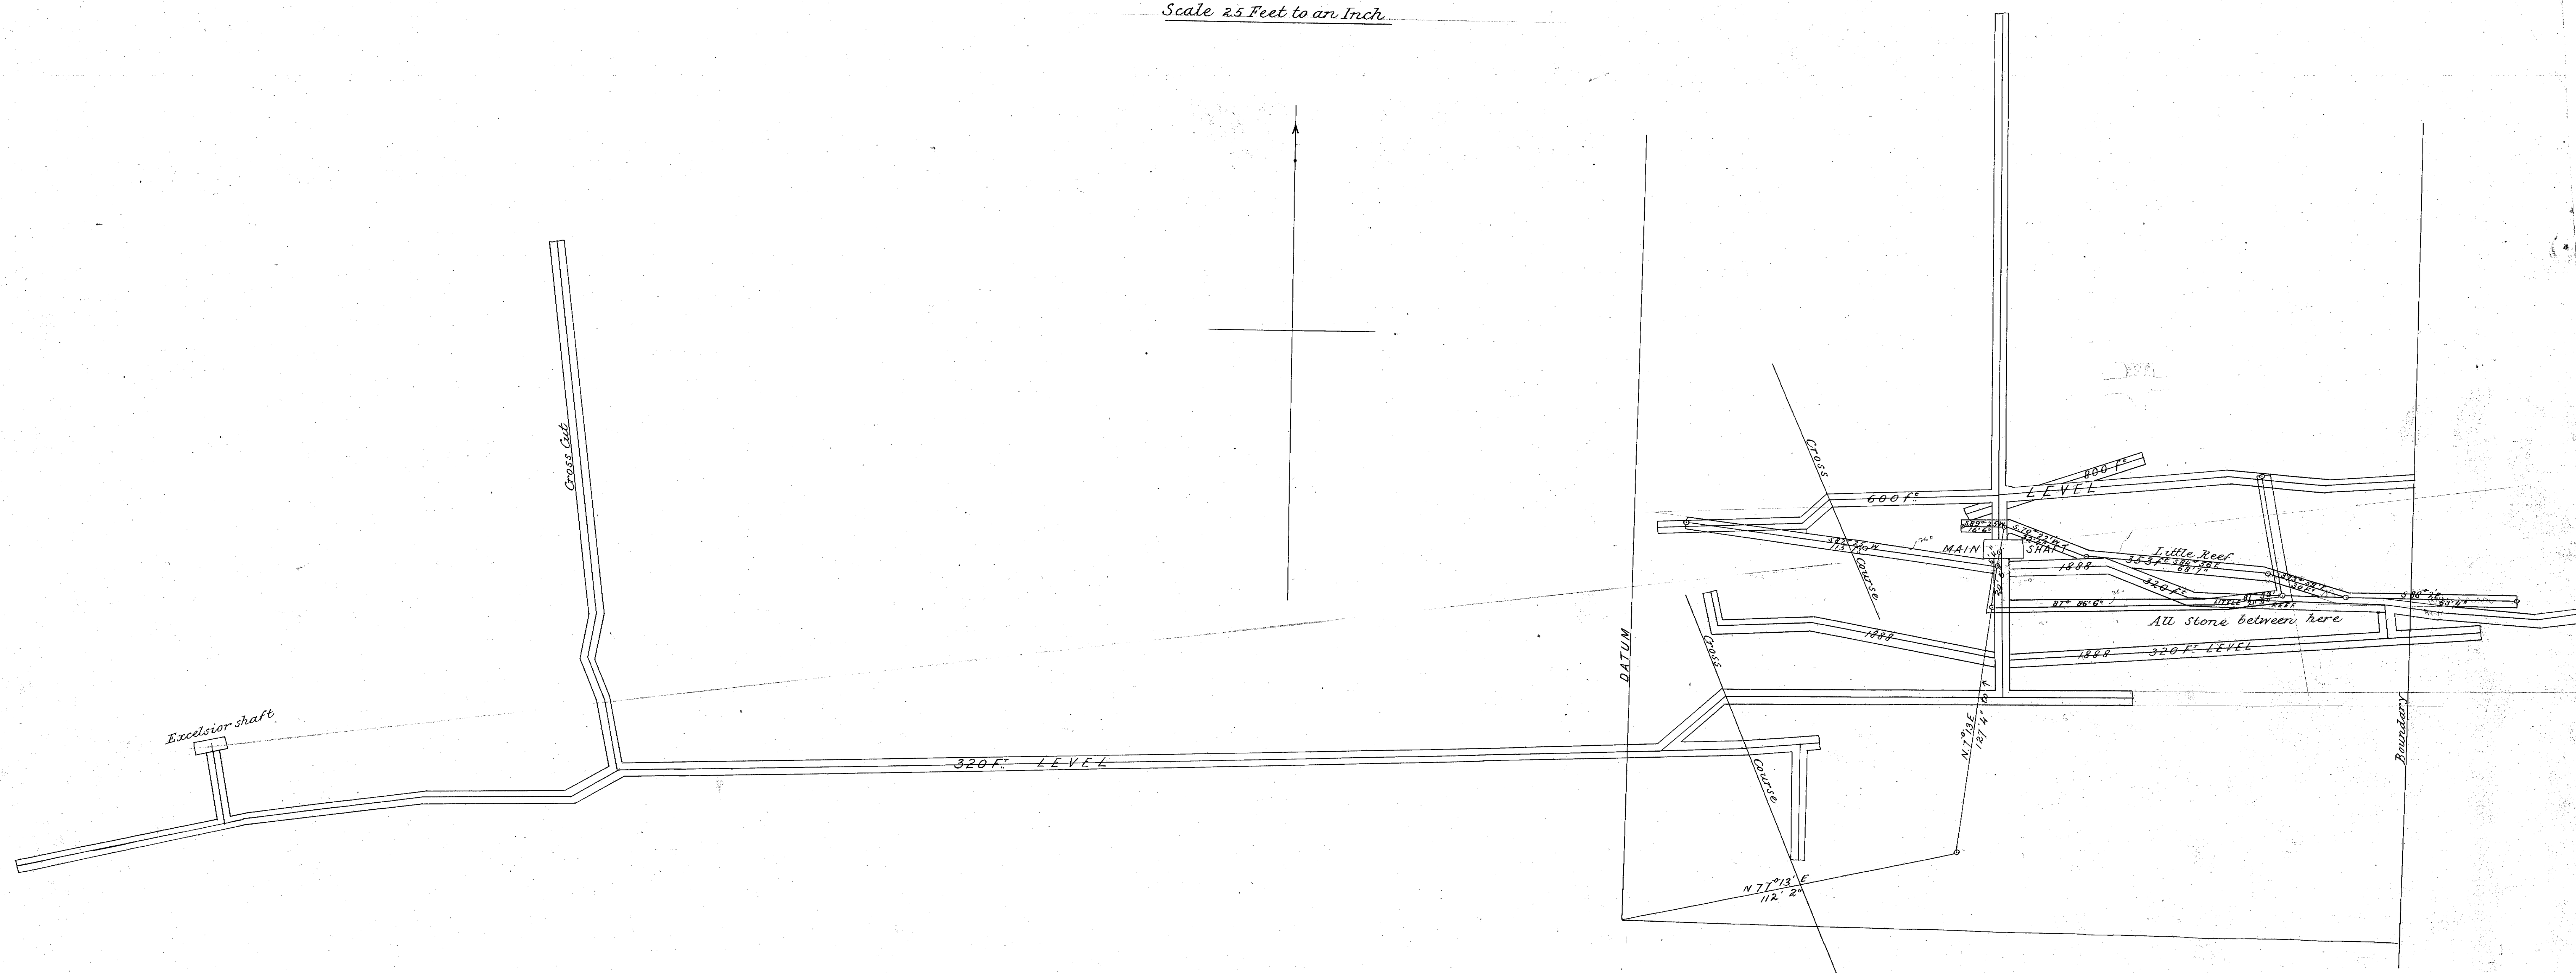

Certified correct copy of plan
in managers office of work done
during 1888 & 9

New Native Youth 1888
1889