


5 cm

147-03

NATIVE YOUTH G. M

Cross Section

Scale 25 Feet to an Inch

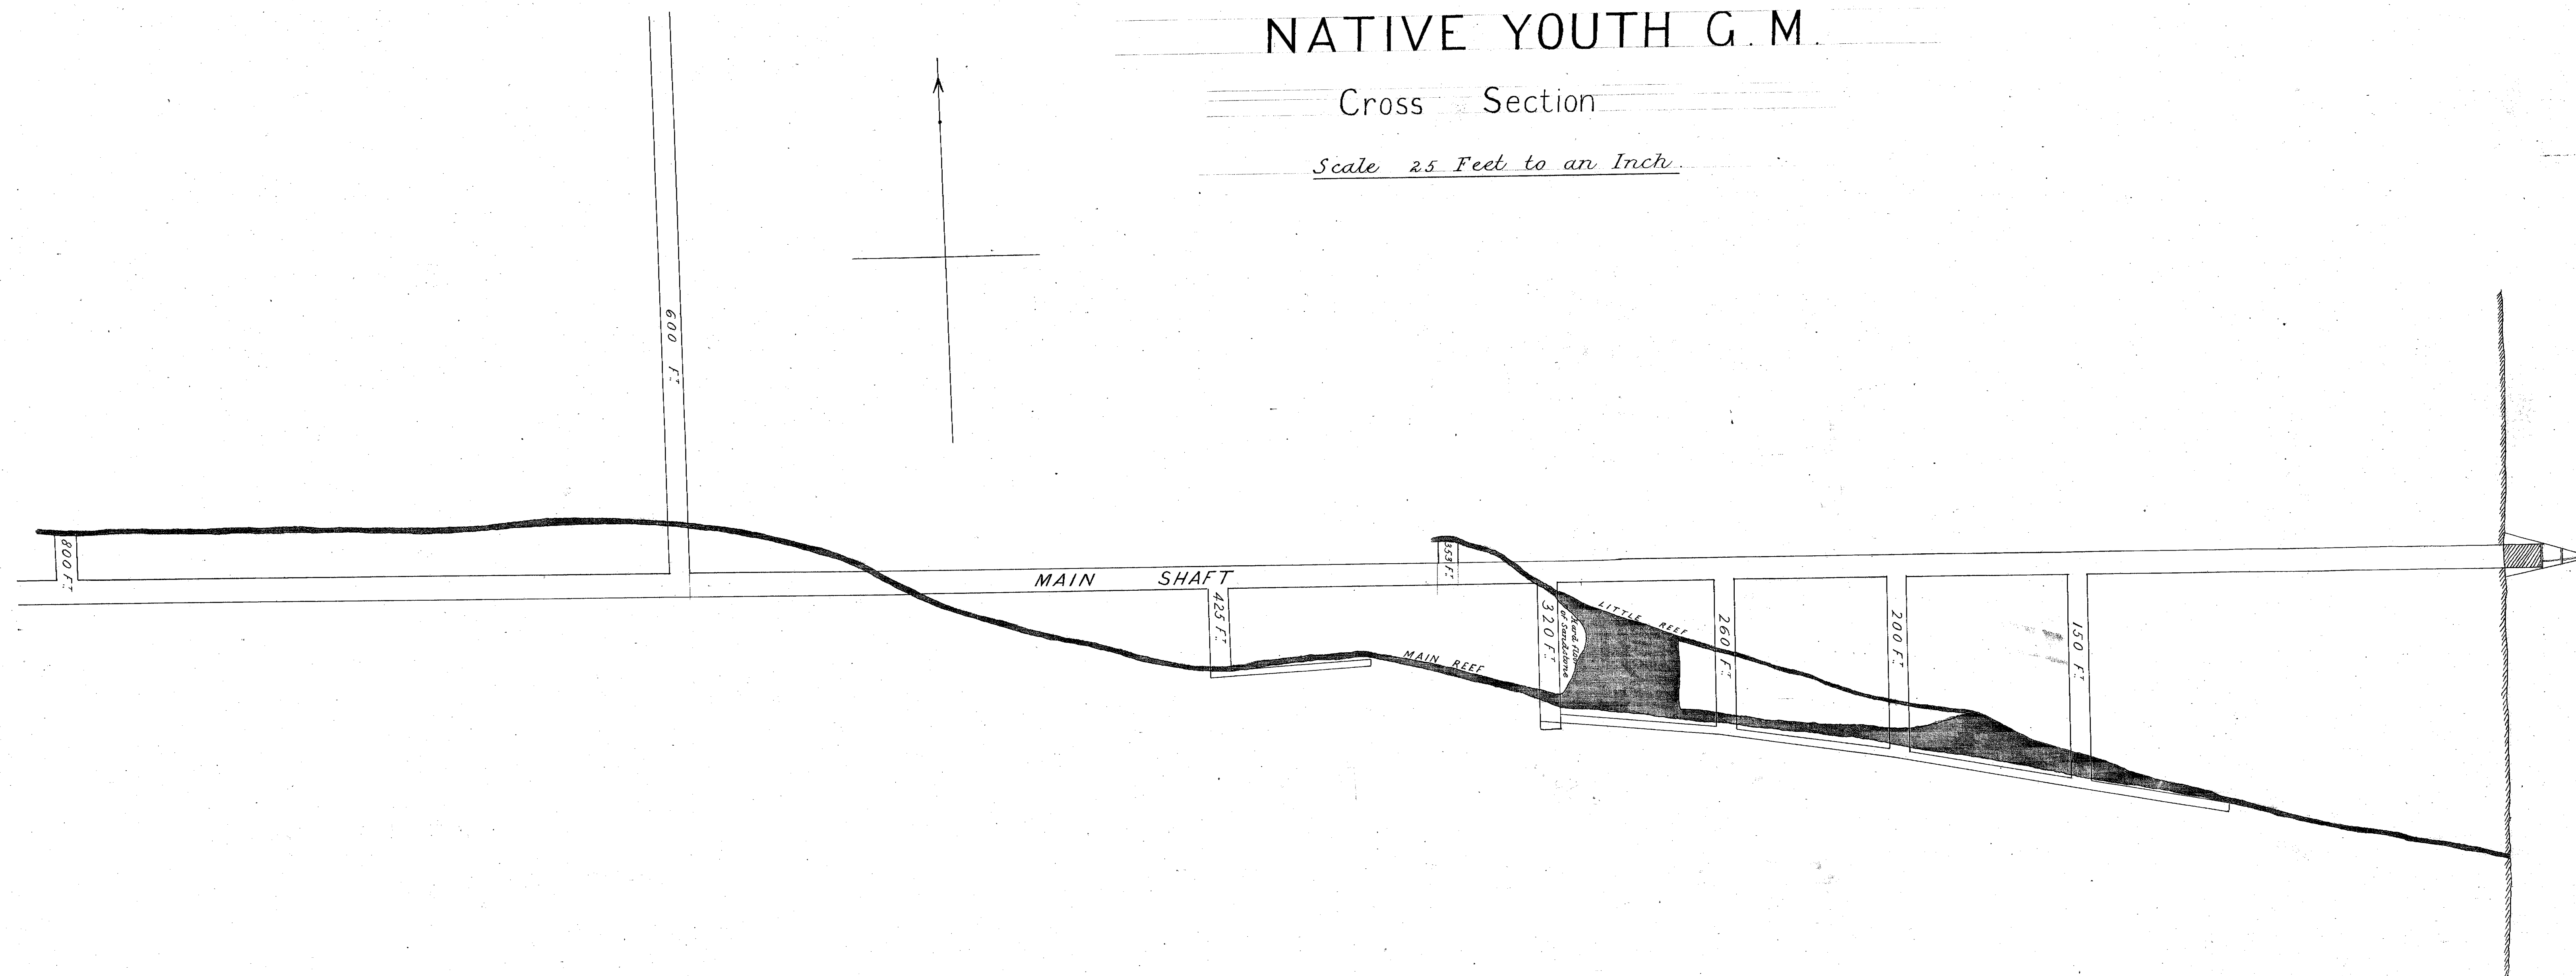

Certified correct copy of
 the Manuscript of the
 Autograph 1887-1888 of
 the
 [illegible]
 [illegible]