


NATIVE YOUTH G.M. LONGITUDINAL SECTⁿ

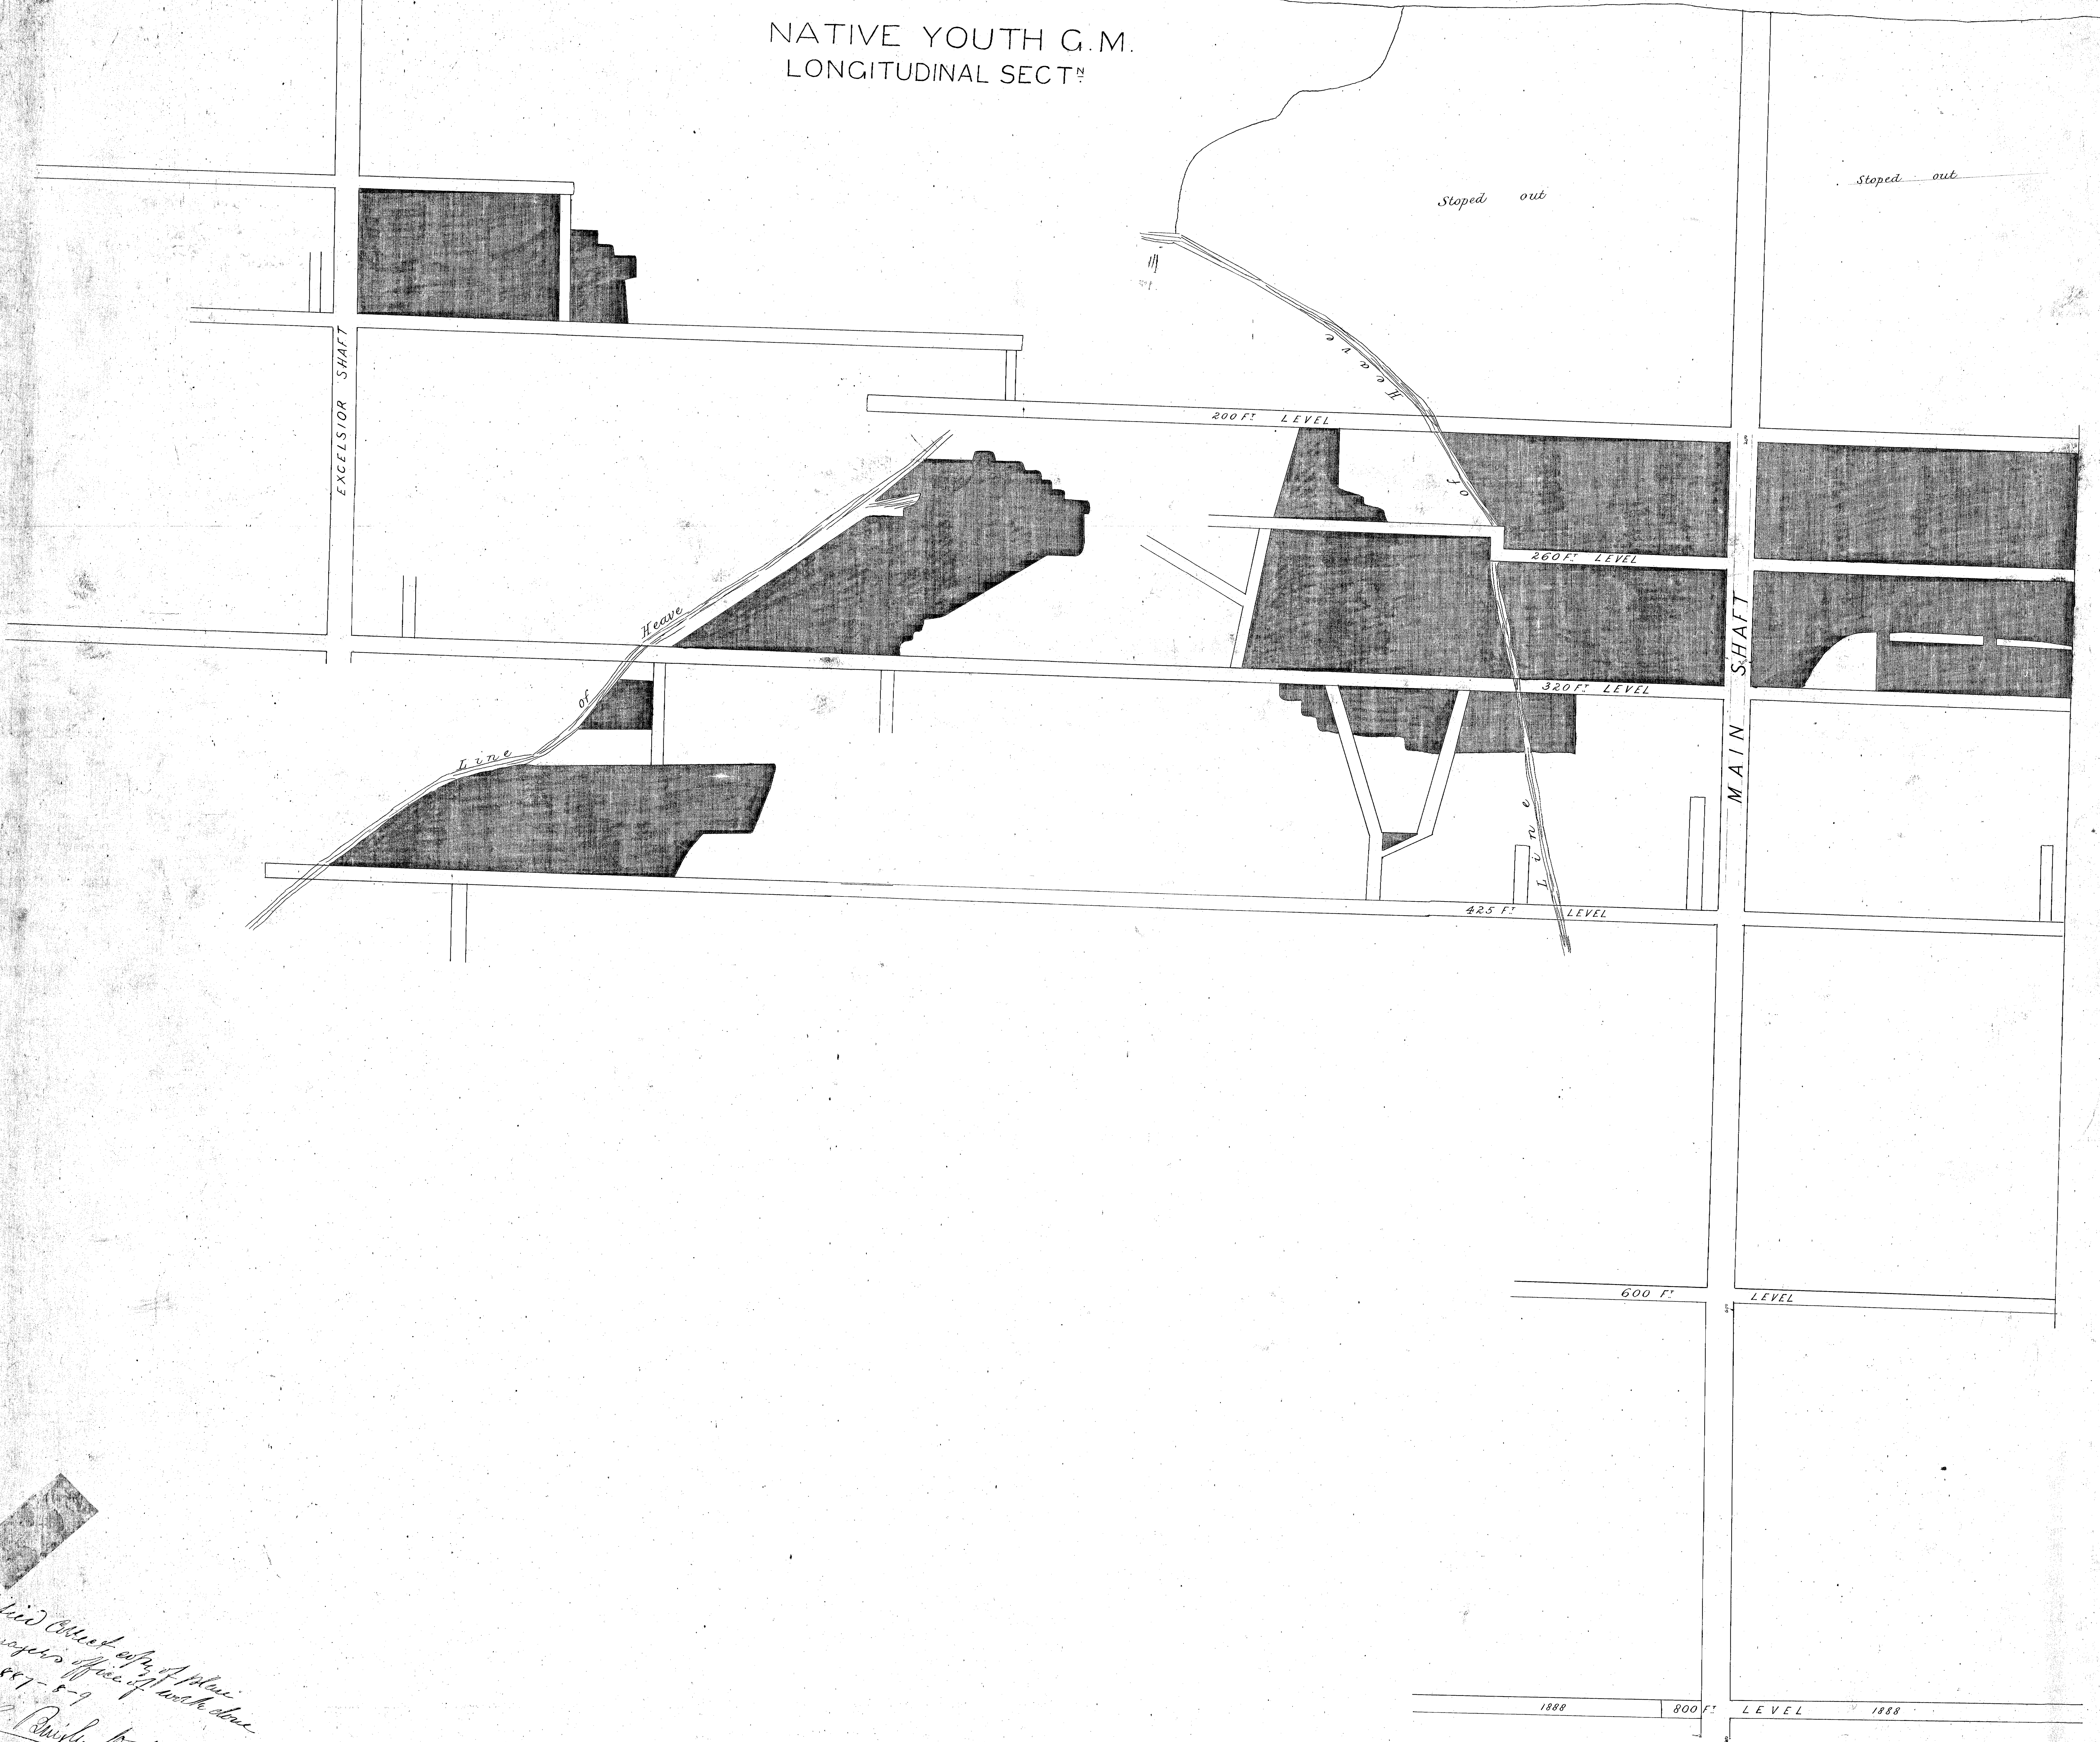

Verified Correct copy of plan
 in Managers office of work done
 during 1887-8-9
 Chiefly Watson
 Auth. Surveyor

1887
 1888
 1889