




149-01

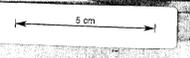

PLAN OF MINE WORKINGS

SUCCESS-OWEN-MEREDITH S.M.Co.


Scale 25 Feet to One inch

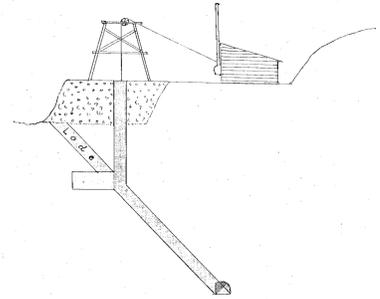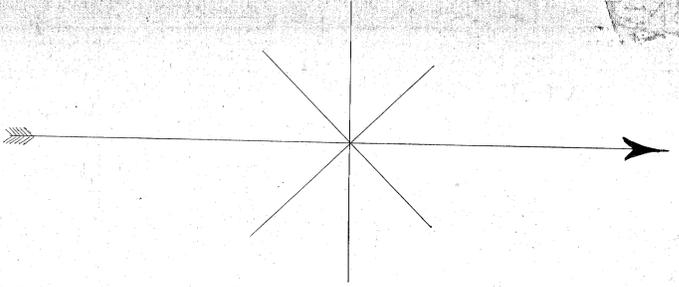


Cross Section
Looking North West

Reference


- Tunnel Levels
- N°1 Level
- N°2 Level
- Shafts
- Stops
- Surface Line of Lode

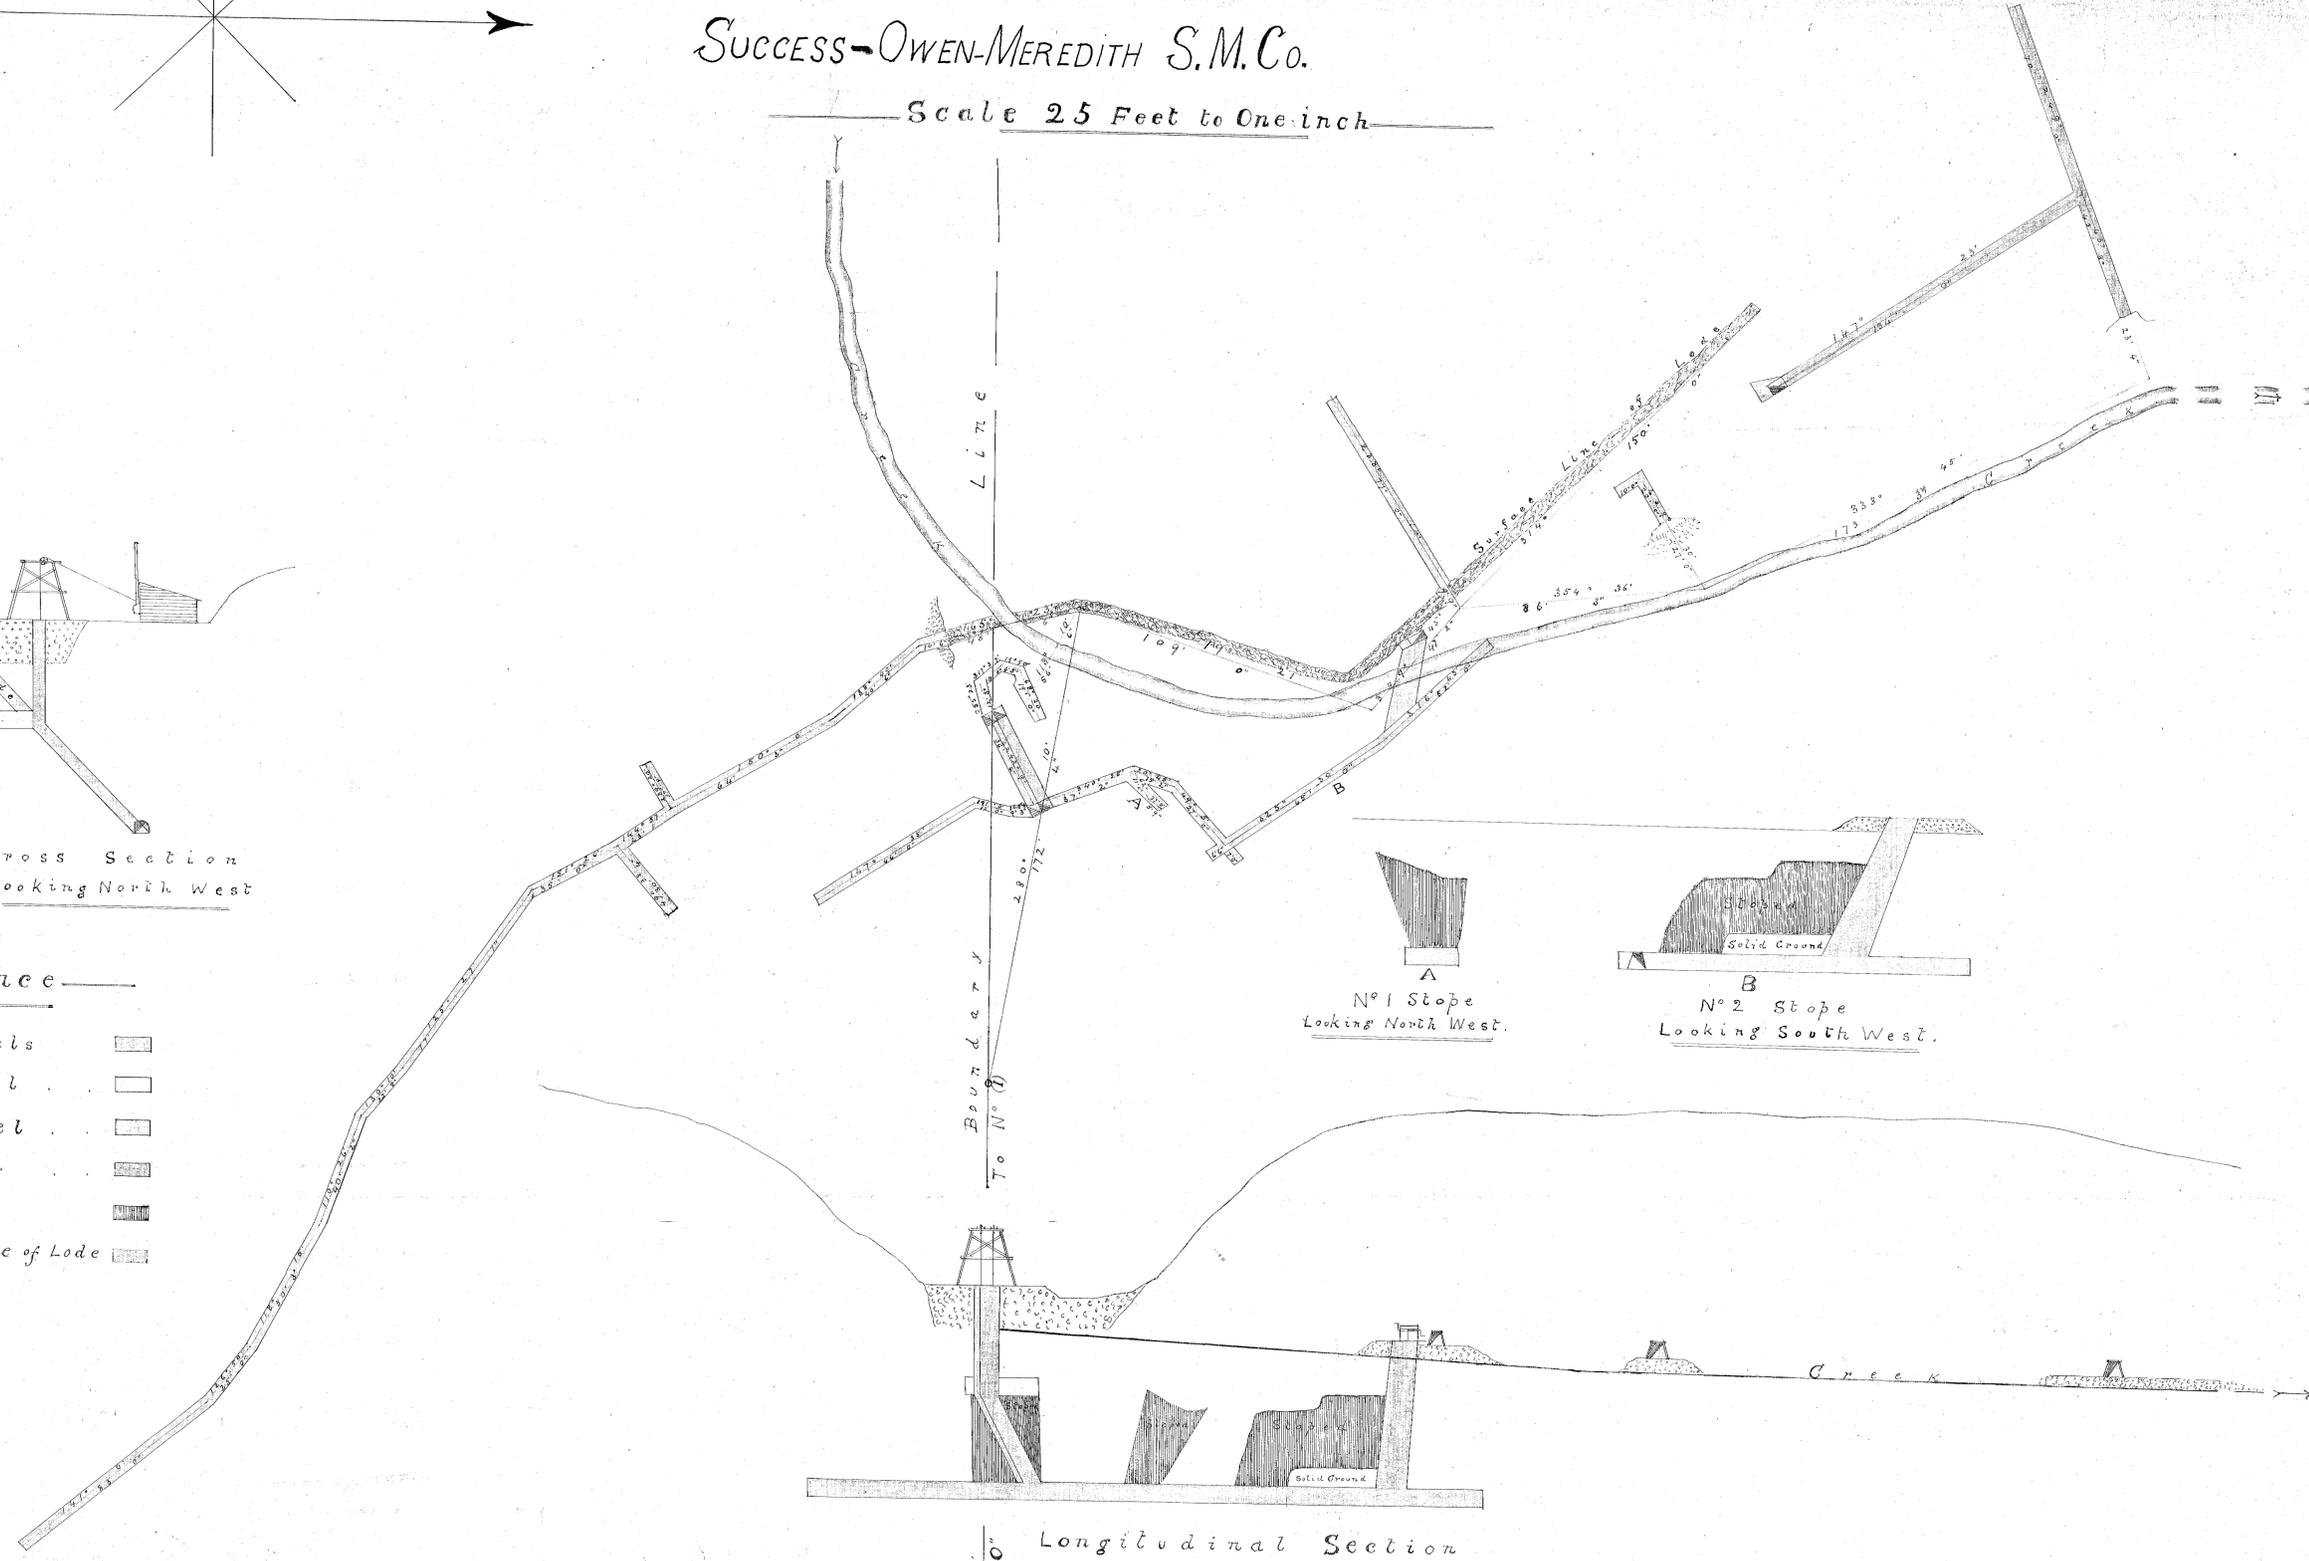

N°1 Stope
Looking North West

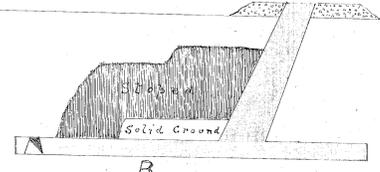

N°2 Stope
Looking South West

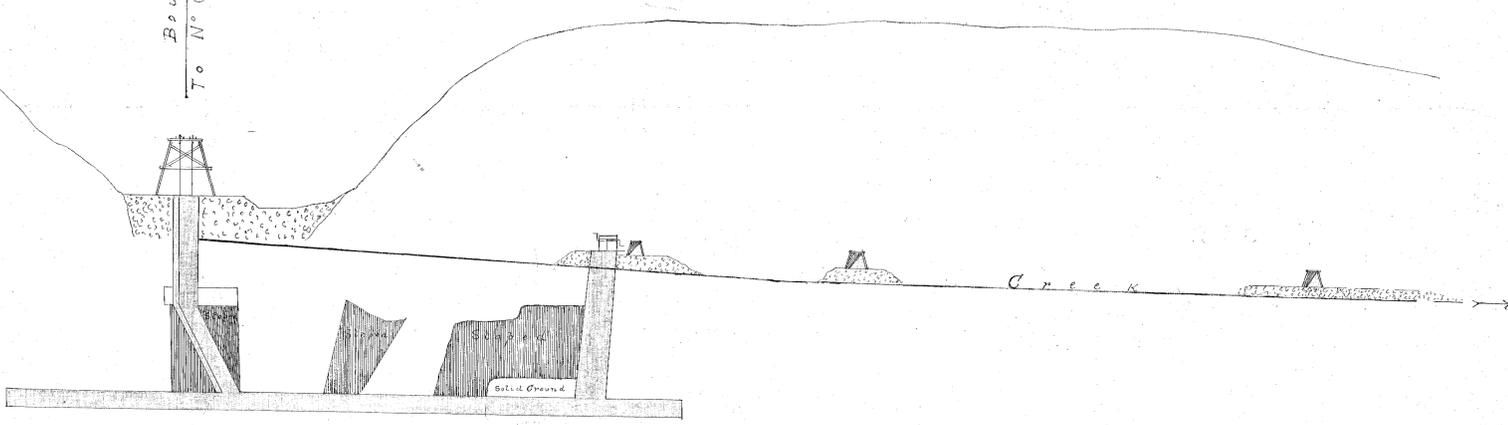

Longitudinal Section
Looking West

Success Section

Owen Meredith Section

Luke Williams
June 30th 1896