

PLAN WEST COMET S.M.C^{COY}

25 feet to an inch.


- 6 JUL 1896

1724
87M

163
93M

80°30' comp. s. read 83°

260°36'
78°6'

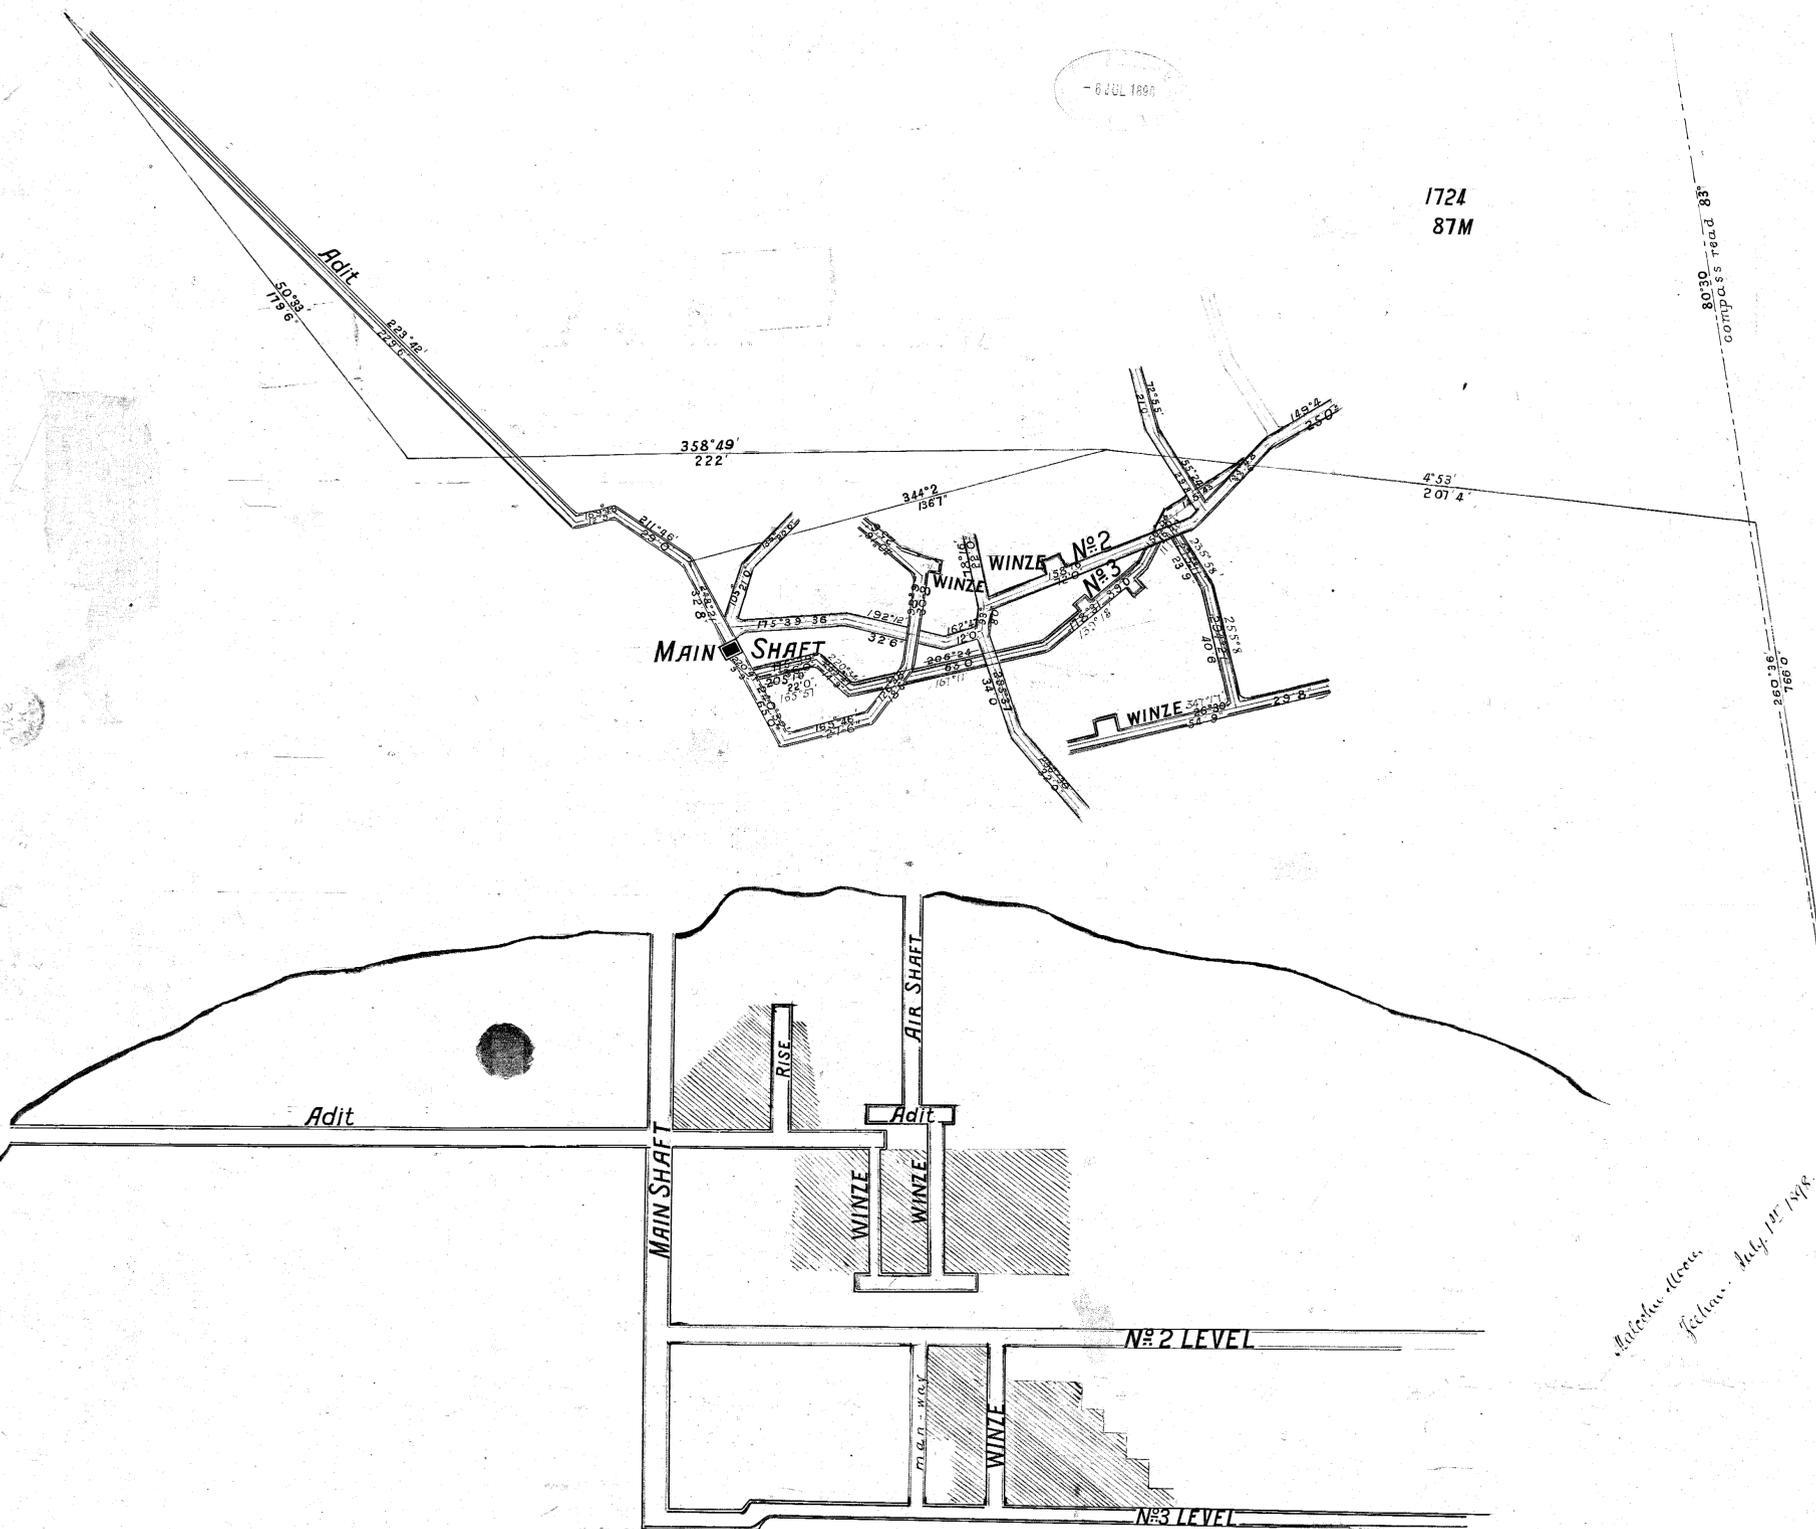

Adit
No 2 LEVEL
No 3 LEVEL