

151-01

— PLAN OF —
 — WEST COMET P, S, REC^d —
 — (ANDERSON SECTION) —
 — DUNDAS. —
 — Scale 25 ft to an inch. —

No 1935
M


151-01
 No 1935
 M

Mag. North

The H. Goodall
Mining Surveyor
1895-5-100.



29° 25'
1250' (ref to scale)

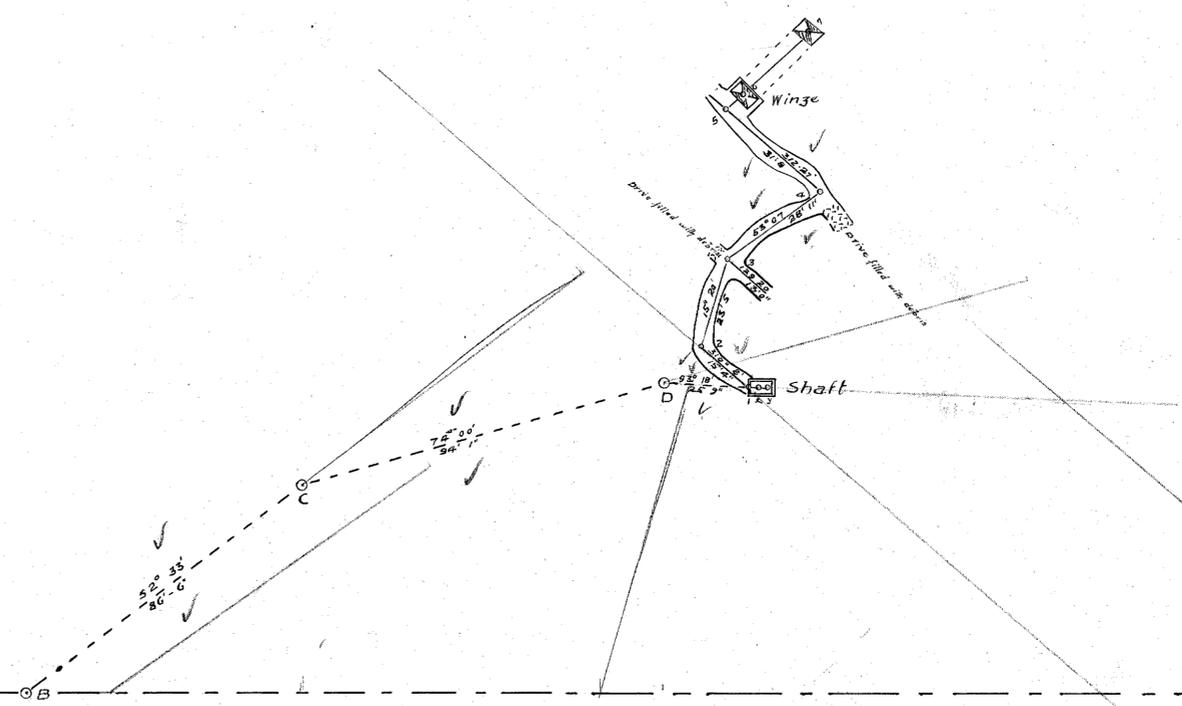

151-01

No 1135
M



50
M

151-01