

West Comet


West Comet Pros Syn No Lia
4 1/3 m. 80 Ac.

5 2/3 m.
2 Ac.

West Comet Pros Syn No Lia

4 9/16 m
25 Ac.

ORE BIN

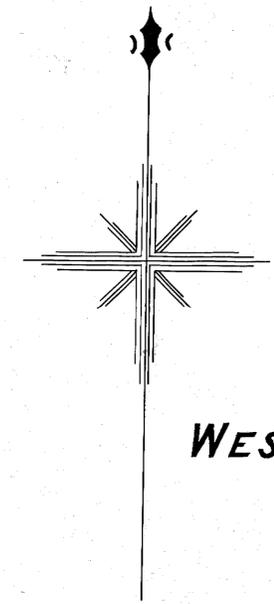

WEST COMET PROS SYNDICATE N^oL^{IA}

Old workings in Red ours in Blue

Scale 25 Feet to an Inch

Geo. F. Birkett
1.10.03.

151-02

151-02

121

