


151-03

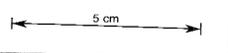

# West Comet Pros Synd N. L.



Underground Workings  
Scale 40 feet to inch

Reference  
1905-6 Workings shown thus   
Previous Ditto


*Godfrey Christie*  
Manager

29.3.06



Pencil Work Traced  
from  
Surface Workings.

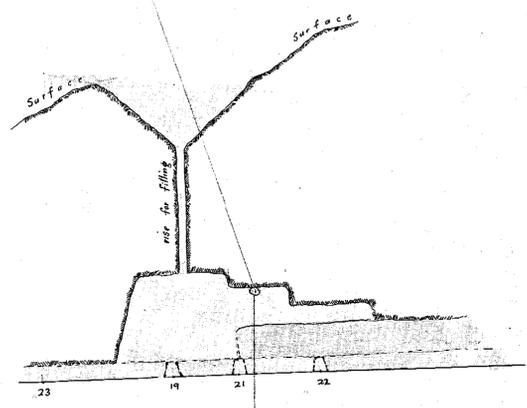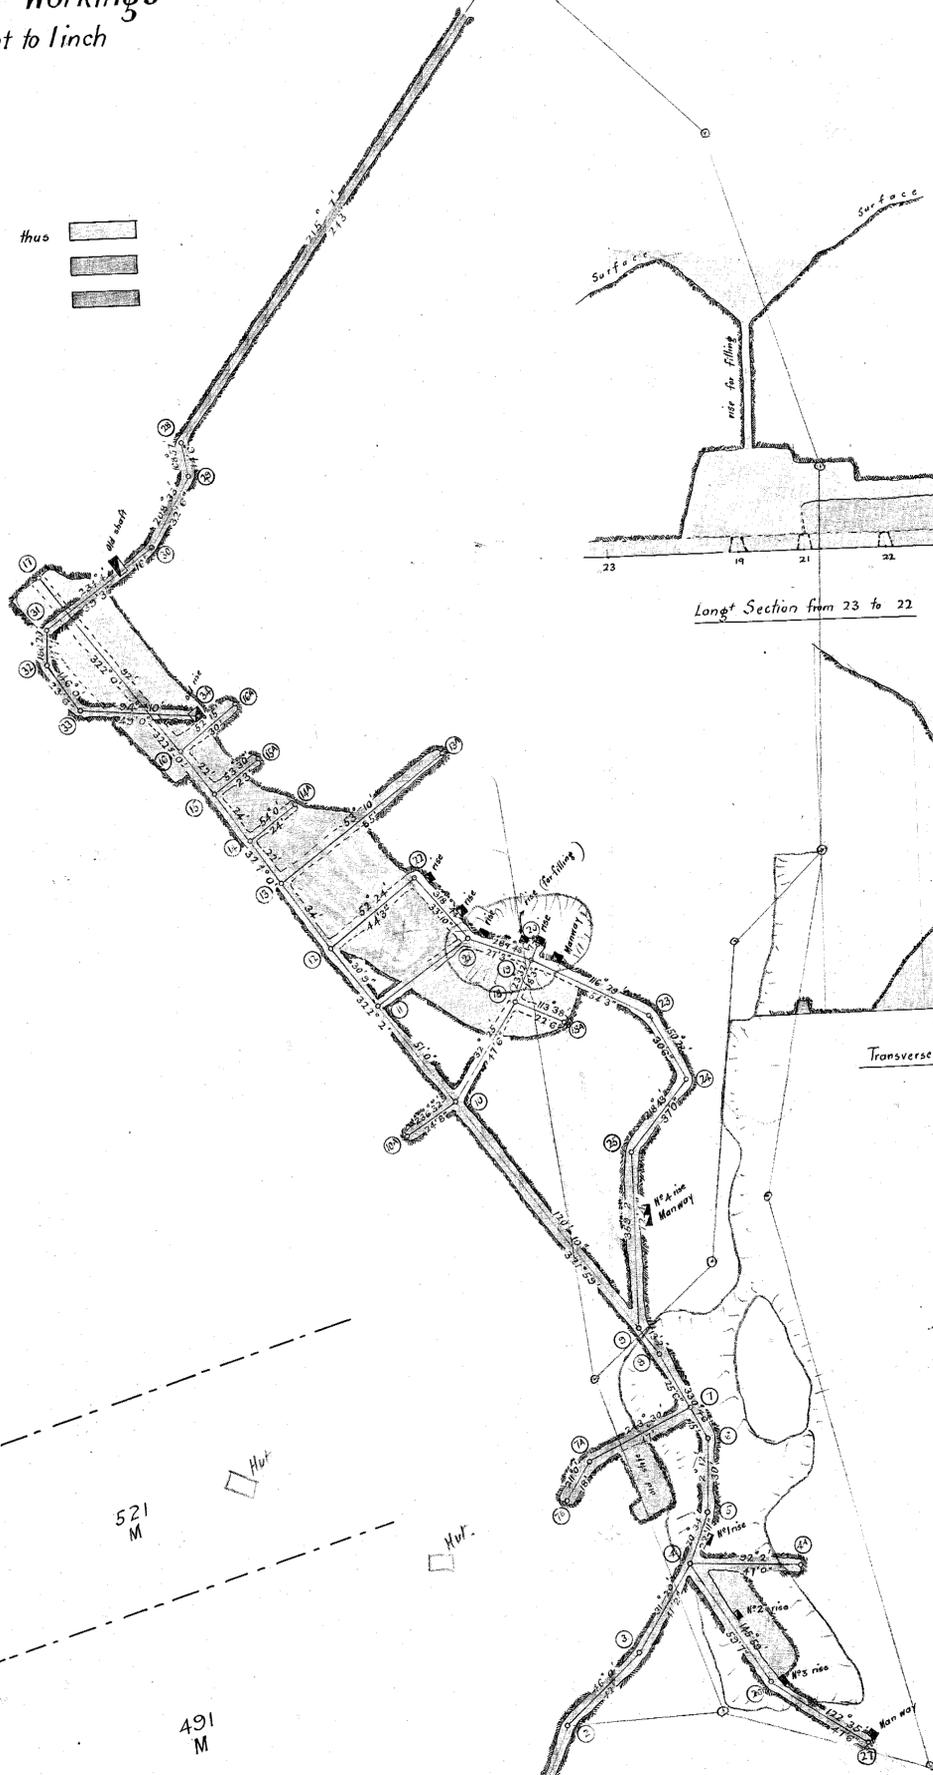


Longt Section from 23 to 22

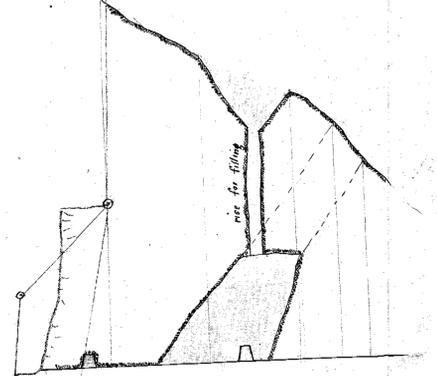

Transverse Section

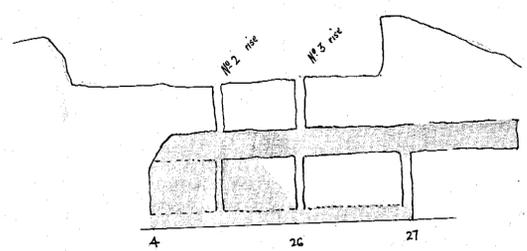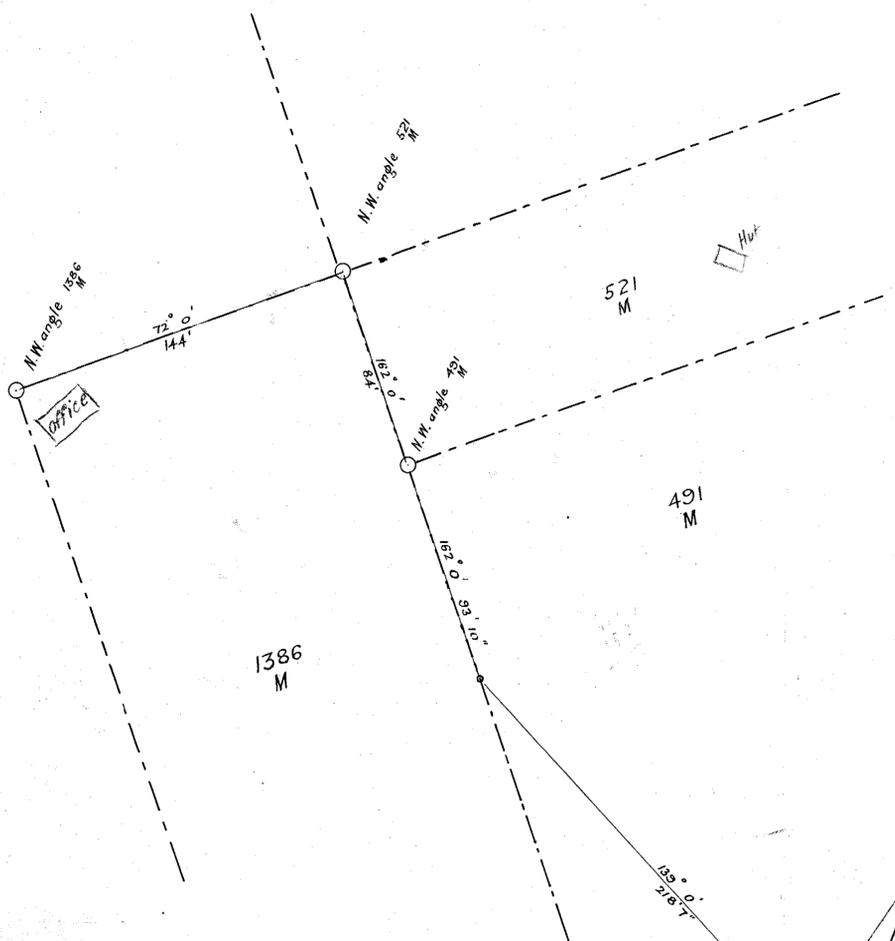

Longt Section 4 to 27

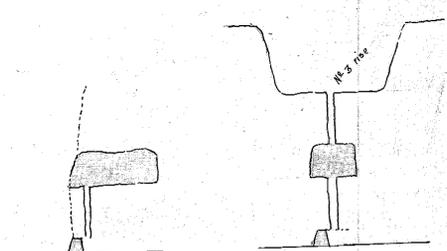

at 27 Cross Sections at 26

